FED. ROAD DIST. NO.	STATE	PROJ. NO.	FISCAL YEAR	SHEET NO.	TOTAL SHEETS
HAWAII	HAW.	65A-03-90	1992	8	10

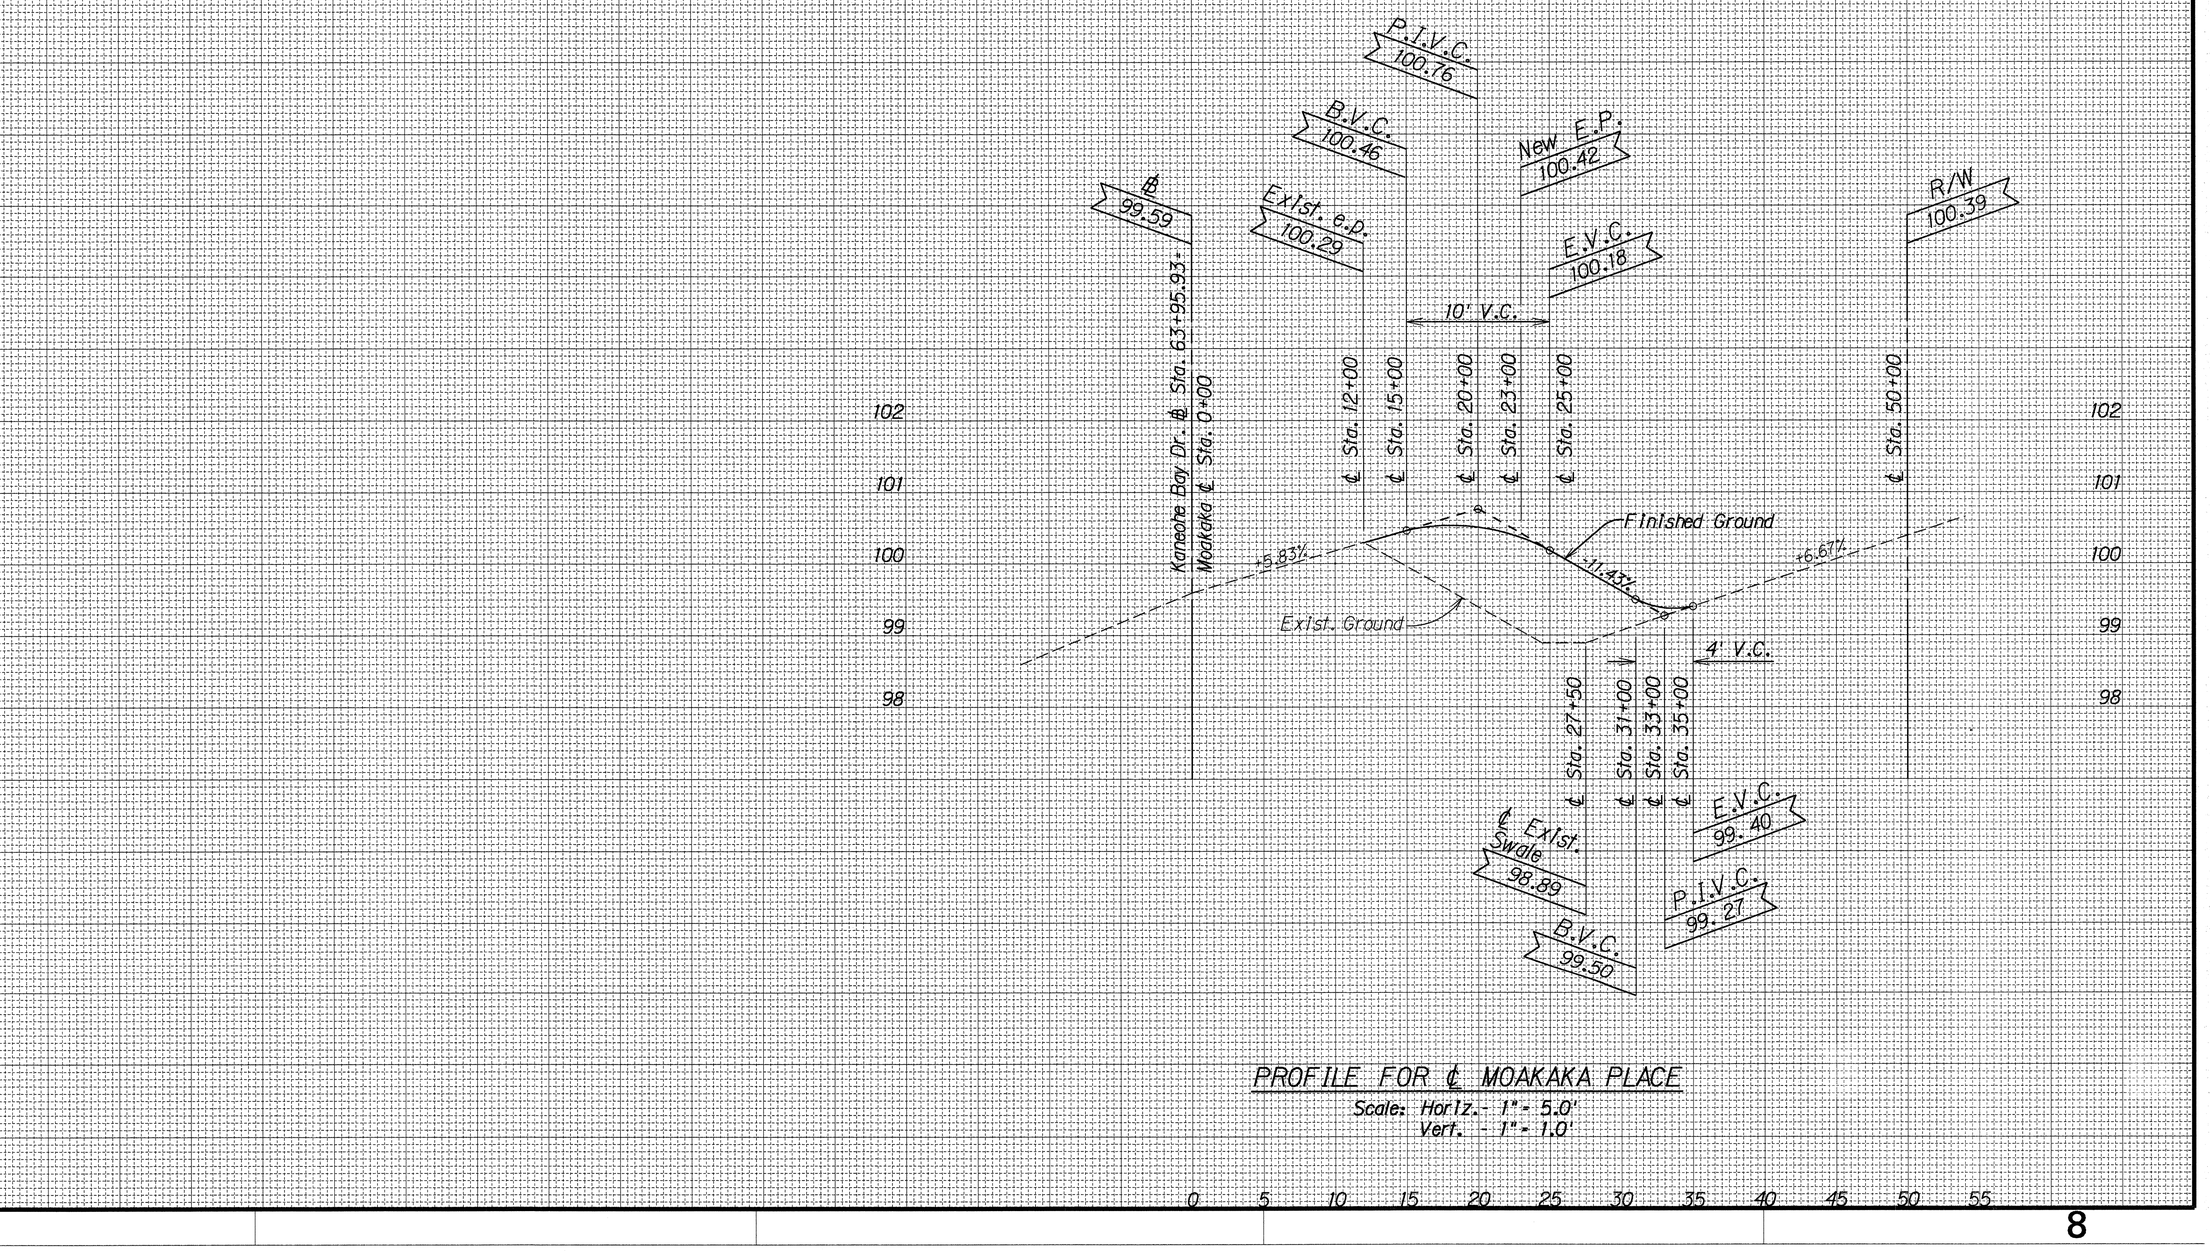

PROFILE FOR ℄ MOAKAKA PLACE

Scale: Horiz.- 1" = 5.0'
Vert. - 1" = 1.0'

ORIGINAL PLAN
NOTE BOOK
No. Tangorra-Ogo

SURVEY PLOTTED BY
DRAWN BY
TRACED BY
DESIGNED BY
QUANTITIES BY
CHECKED BY
DATE