INDEX TO DRAWINGS	
SHEET NO.	DESCRIPTIONS
1	TITLE SHEET
2	TYPICAL ROAD SECTIONS & DETAILS
3	PLAN & PROFILE
4-5	BRIDGE
6	ROAD CROSS SECTIONS

TERRITORY OF HAWAII

TERRITORIAL HIGHWAY DEPARTMENT

HONOLULU T.H.

PLANS OF

WAILUPE BRIDGE

FEDERAL AID PROJECT NO. 6 B

ON KALANIANAOLE HIGHWAY

DISTRICT OF HONOLULU

OAHU

FED. ROAD DIST. NO.	STATE	FED. AID PROJ. NO.	FISCAL YEAR	SHEET NO.	TOTAL SHEETS
HAWAII	HAW	6B	1930	1	6

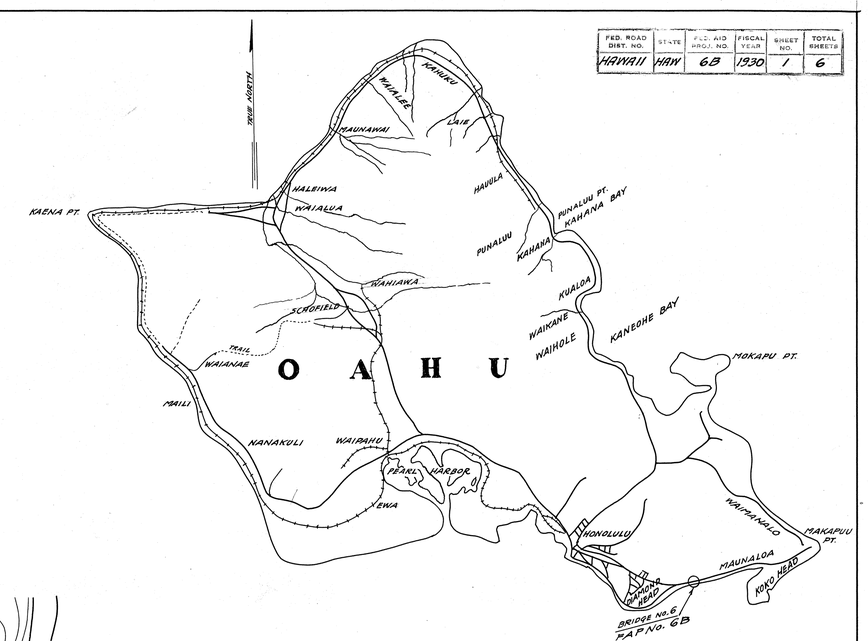

- CONVENTIONAL SIGNS -

Edge of Existing Road
Existing Fence
Boundry Line (Not Fenced)
Existing Stone Wall
Railroad
Center Line

SCALE

PLAN ---------- 1 INCH = 40 FEET
PROFILE -------- HOR 1 INCH = 40 FEET
VER 1 INCH = 4 FEET

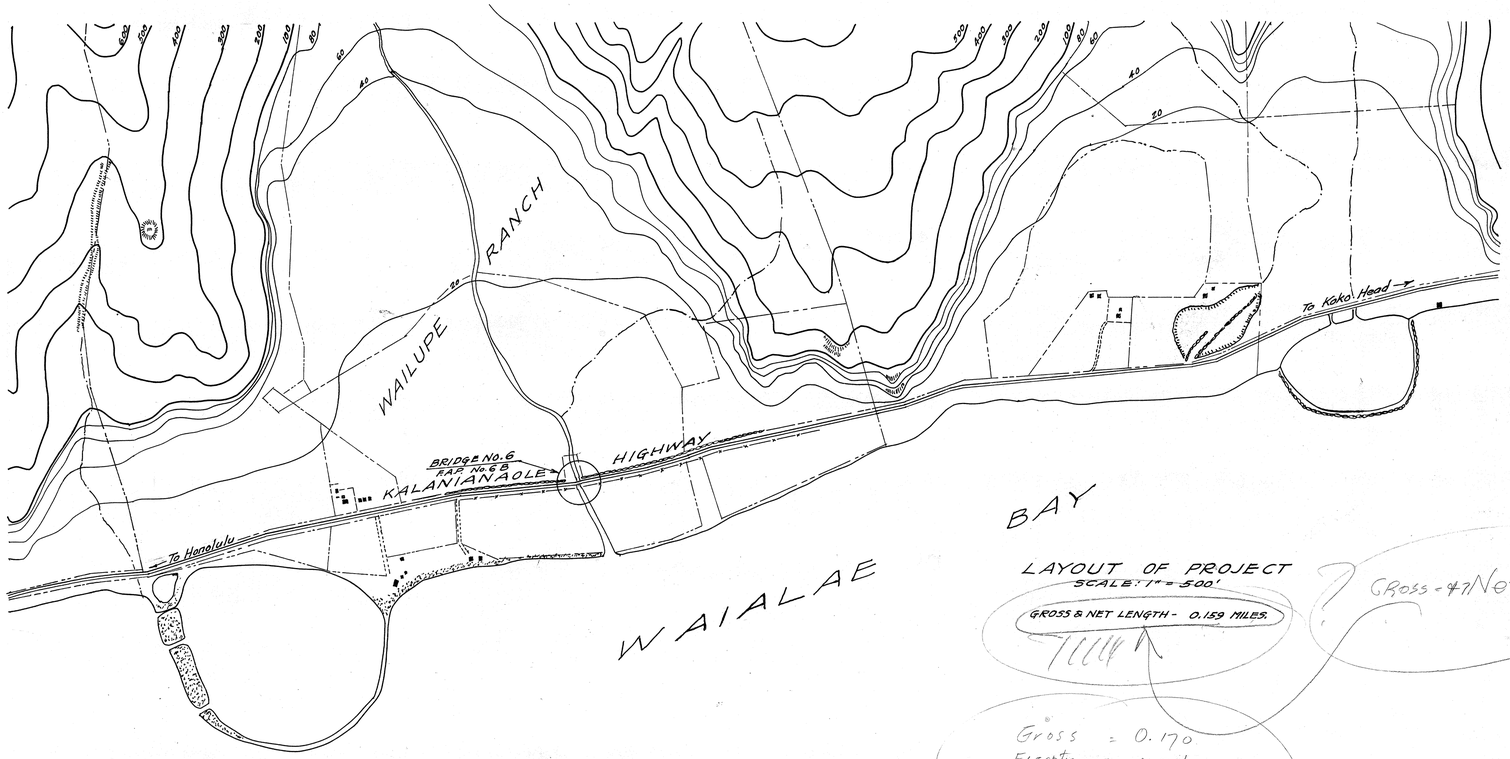

LAYOUT OF PROJECT
SCALE: 1" = 500'

GROSS & NET LENGTH - 0.159 MILES.

? Gross = 47 Net = 0.170 ?

Gross = 0.170
Exception = 0.011
Net = 0.159
12-28-39

NOTE:
Elevations refer to mean tide, U.S.G.S Datum

All poles and braces will be moved to 8 ft clear of pavement by H.E. Co.

4141.1

RECOMMENDED FOR APPROVAL
Gohlen. May. 22-1930.
PRINCIPAL HIGHWAY ENGR. Bureau of Public Roads.

APPROVED
L. B. Bailey
CHIEF ENGR. Dept. of Public Works. City and County of Honolulu.

APPROVED
Roger H. Bigelow.
March 20, 1930
TERRITORIAL HIGHWAY ENGR.

RECOMMENDED FOR APPROVAL
CHIEF ENGR. Bureau of Public Roads.

APPROVED
DIRECTOR. Bureau of Public Roads.

6 14 3