FED. ROAD DIST. NO.	STATE	FED. AID PROJ. NO.	FISCAL YEAR	SHEET NO.	TOTAL SHEETS
HAWAII	HAW.	25-B	1957	10	32

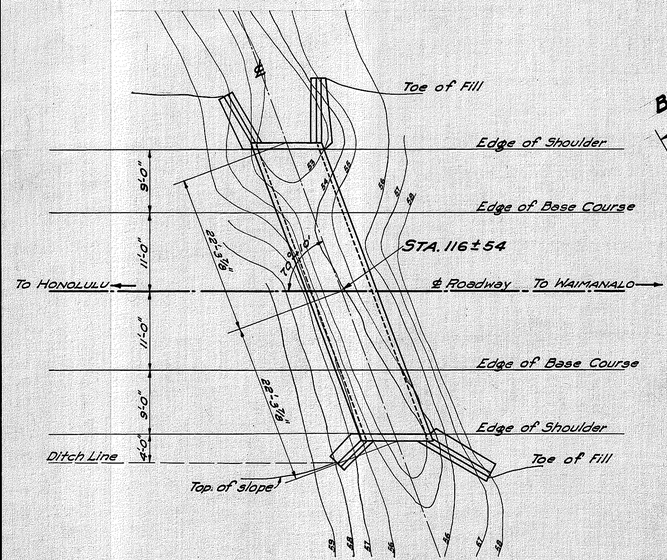

LOCATION PLAN
Scale: 1"=10'-0"

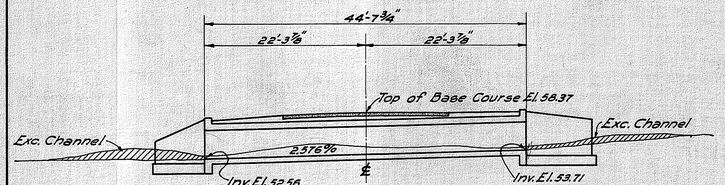

LONGITUDINAL SECTION ON ℄
Scale: 1"=10'-0"

ESTIMATED QUANTITIES	
CLASS "A" CONCRETE	452 c.y.
REINFORCING STEEL	53910 lb.
STRUCTURAL EXC.	440 c.y.
CHANNEL EXC.	160 c.y.

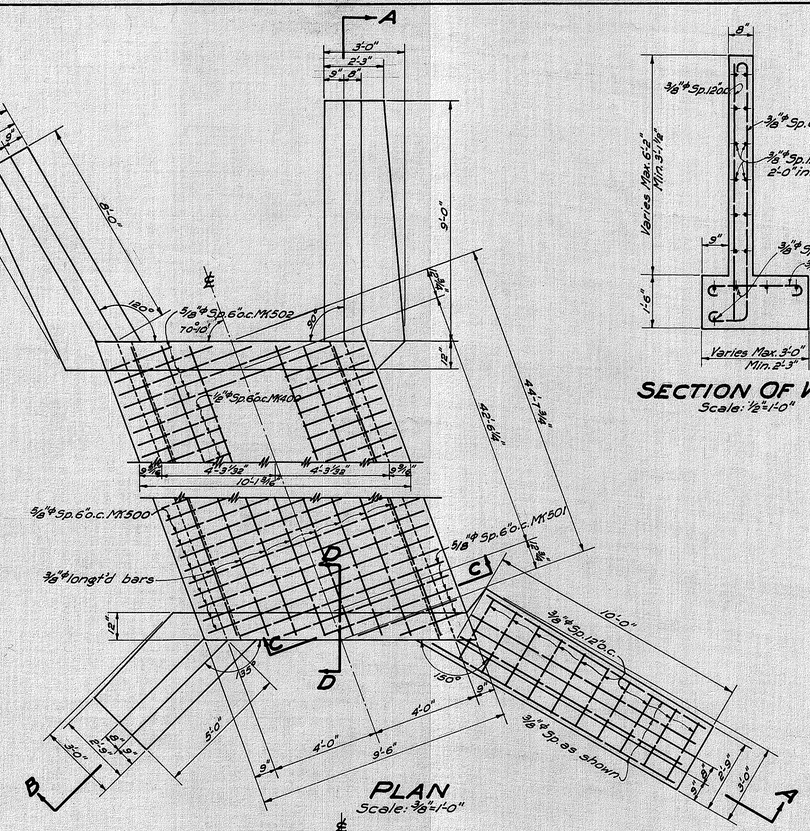

PLAN
Scale: 3/8"=1'-0"

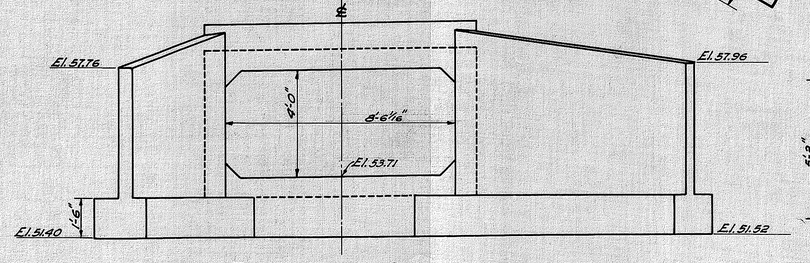

ELEVATION OF INTAKE
Scale: 3/8"=1'-0"

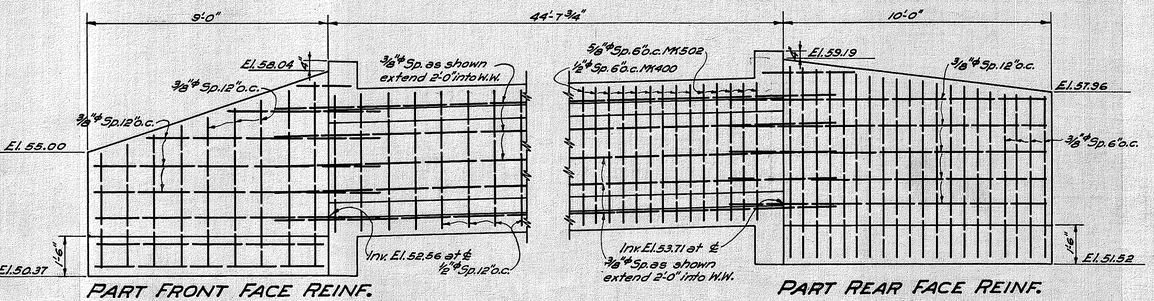

PART FRONT FACE REINF.

PART REAR FACE REINF.

SECTION A-A
Scale: 3/8"=1'-0"

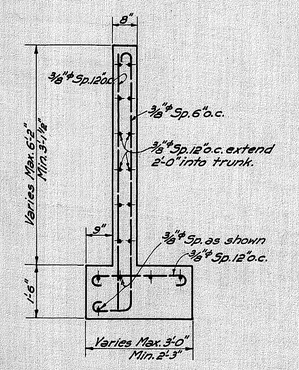

SECTION OF WINGWALL
Scale: ½"=1'-0"

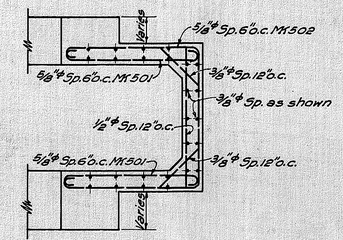

SECTION C-C
Scale: 3/8"=1'-0"

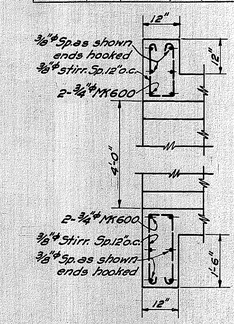

SECTION D-D
Scale: ½"=1'-0"

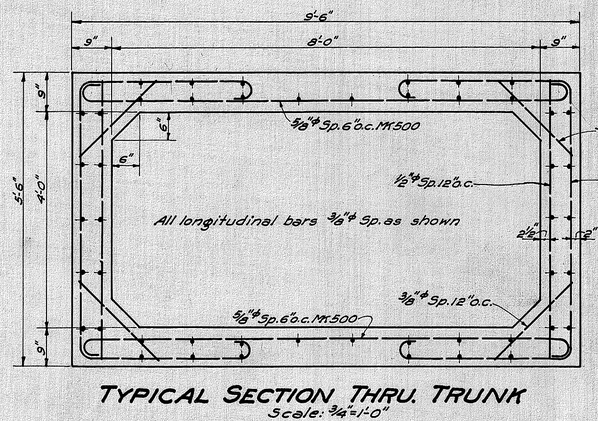

TYPICAL SECTION THRU. TRUNK
Scale: ¾"=1'-0"

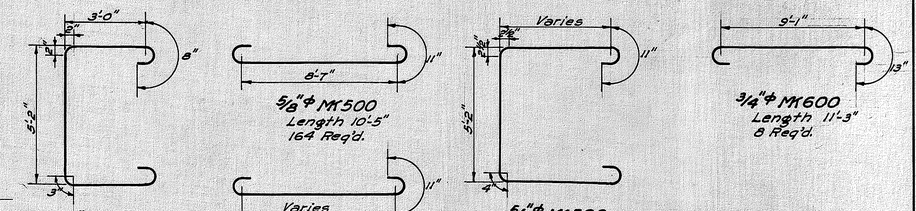

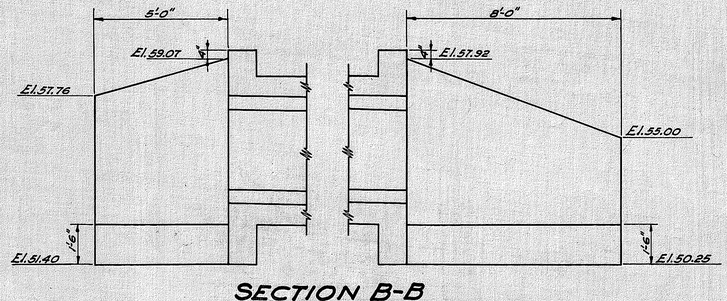

SECTION B-B
Scale: 3/8"=1'-0"

ORIGINAL PLANS	SURVEY PLOTTED BY	DATE
	DESIGNED BY H.E. Bartlett & L.L. Padgett	6/57
	DRAWN BY J.C. Myatt	" 22
NOTE BOOK	TRACED BY L. Felix	" 22
	QUANTITIES BY	"
No.	CHECKED BY	

TERRITORIAL HIGHWAY DEPARTMENT
TERRITORY OF HAWAII

4'x8' BOX CULVERT
STA. 116±54
KALANIANAOLE HIGHWAY F.A.P. 25-B

SHEET NO 1 OF 1 SHEETS

44 02.10