FED. ROAD DIST. NO.	STATE	FED. AID PROJ. NO.	FISCAL YEAR	SHEET NO.	TOTAL SHEETS
HAWAII	HAW	F G (16)	1948	1	31

INDEX TO DRAWINGS	
SHEET NO.	DESCRIPTION
1	TITLE SHEET
2	TYPICAL SECTION
3-12	PLAN & PROFILE
13-14	EXTENSION OF CULVERT DETAIL
15	RECONSTRUCTION OF DROP INTAKE BOX DETAIL
16-18	STANDARD DETAIL
19-31	CROSS SECTION

NOTE:
ALL CHANGES MADE DURING CONSTRUCTION HAVE BEEN NOTED IN RED ON THESE TRACINGS AND CHECKED.

By: L. C. Smith
Resident Engineer

Date: June 20, 1950

TERRITORY OF HAWAII
TERRITORIAL HIGHWAY DEPARTMENT
HONOLULU, OAHU, T. H.

PLANS OF WIDENING OF A PORTION OF KALANIANAOLE HIGHWAY

FEDERAL AID PROJECT NO. F 6 (16)

DISTRICTS OF KOOLAUPOKO AND HONOLULU

ISLAND OF OAHU

CONVENTIONAL SIGNS

Centerline
Boundary Lines, or
Fences (Named)
Existing Roadways
Circular Culvert
Box Culvert
Bridge
Telephone Pole
Electric Power Pole
Water Main (W4, 8, 12, Etc.)
Storm Drain (SD18, 24, Etc.)
Concrete Drop Intake
Standard Catch Basin
Standard Manhole
Sewer Manhole
Telephone Manhole
Fire Hydrant
Tree (Large, named)
Railroad

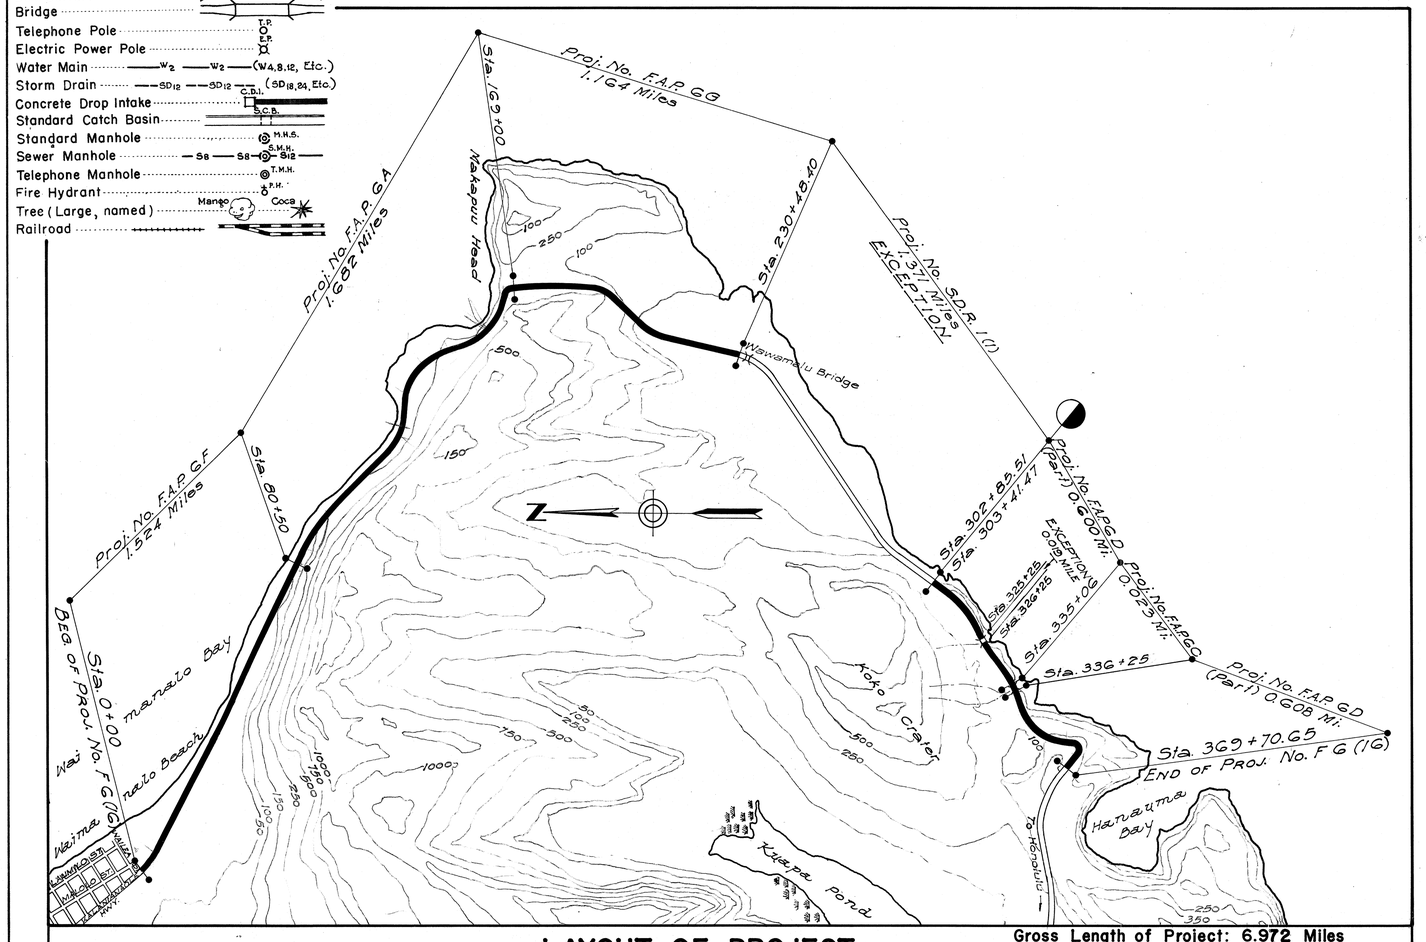

LAYOUT OF PROJECT

Gross Length of Project: 6.972 Miles
Exception: 1.390 Miles
Net Length of Project: 5.582 Miles

Federal Aid Projects Previously Constructed Or Under Construction

ORIGINAL PLAN		DATE
	SURVEY PLOTTED BY	
	DESIGNED BY	"
	DRAWN BY	"
	TRACED BY	"
NOTE BOOK	QUANTITIES	"
	QUANTITIES CHECKED BY	"
No.	CHECKED BY	"

RECOMMENDED FOR APPROVAL DATE [redacted]

DISTRICT ENGINEER
PUBLIC ROADS ADMINISTRATION
FEDERAL WORKS AGENCY

APPROVED DATE [redacted]

DIVISION ENGINEER
PUBLIC ROADS ADMINISTRATION
FEDERAL WORKS AGENCY

APPROVED DATE April 21, 1949

TERRITORIAL HIGHWAY ENGINEER

5340.1