FED. ROAD DIST. NO.	STATE	FED. AID PROJ. NO.	FISCAL YEAR	SHEET NO.	TOTAL SHEETS
HAWAII	HAW	WDR 1(1)	1948	1	12

TERRITORY OF HAWAII
TERRITORIAL HIGHWAY DEPARTMENT
HONOLULU, OAHU, T. H.

PLANS OF REHABILITATION OF A PORTION OF KALANIANAOLE HIGHWAY

WAR DAMAGE REHABILITATION PROJECT NO. W.D.R. 1 (1)

DISTRICTS OF KOOLAUPOKO AND HONOLULU
ISLAND OF OAHU

NOTE:
ALL CHANGES MADE DURING CONSTRUCTION HAVE BEEN NOTED IN RED ON THESE TRACINGS AND CHECKED.

By: L. C. Frutz
Resident Engineer

Date: June 20, 1948

INDEX TO DRAWINGS

SHEET NO.	DESCRIPTION
1	TITLE SHEET
2	TYPICAL SECTION
3-12	PLAN & PROFILE

CONVENTIONAL SIGNS

Centerline
Boundary Lines
Fences (Named)
Existing Roadways
Circular Culvert
Box Culvert
Bridge
Telephone Pole
Electric Power Pole
Water Main
Storm Drain
Concrete Drop Intake
Standard Catch Basin
Standard Manhole
Sewer Manhole
Telephone Manhole
Fire Hydrant
Tree (Large, named)
Railroad

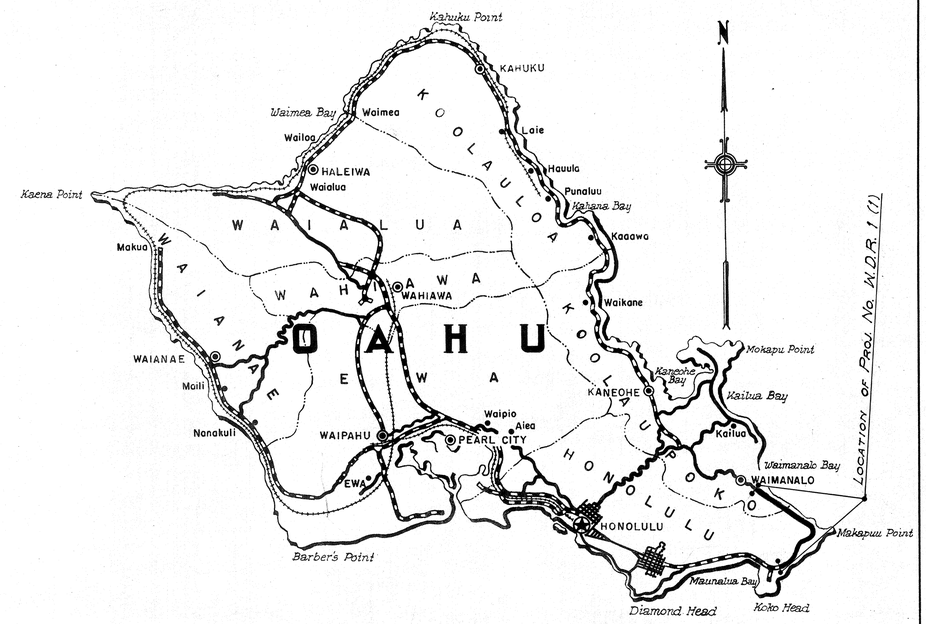

Federal Aid Projects Previously Constructed Or Under Construction

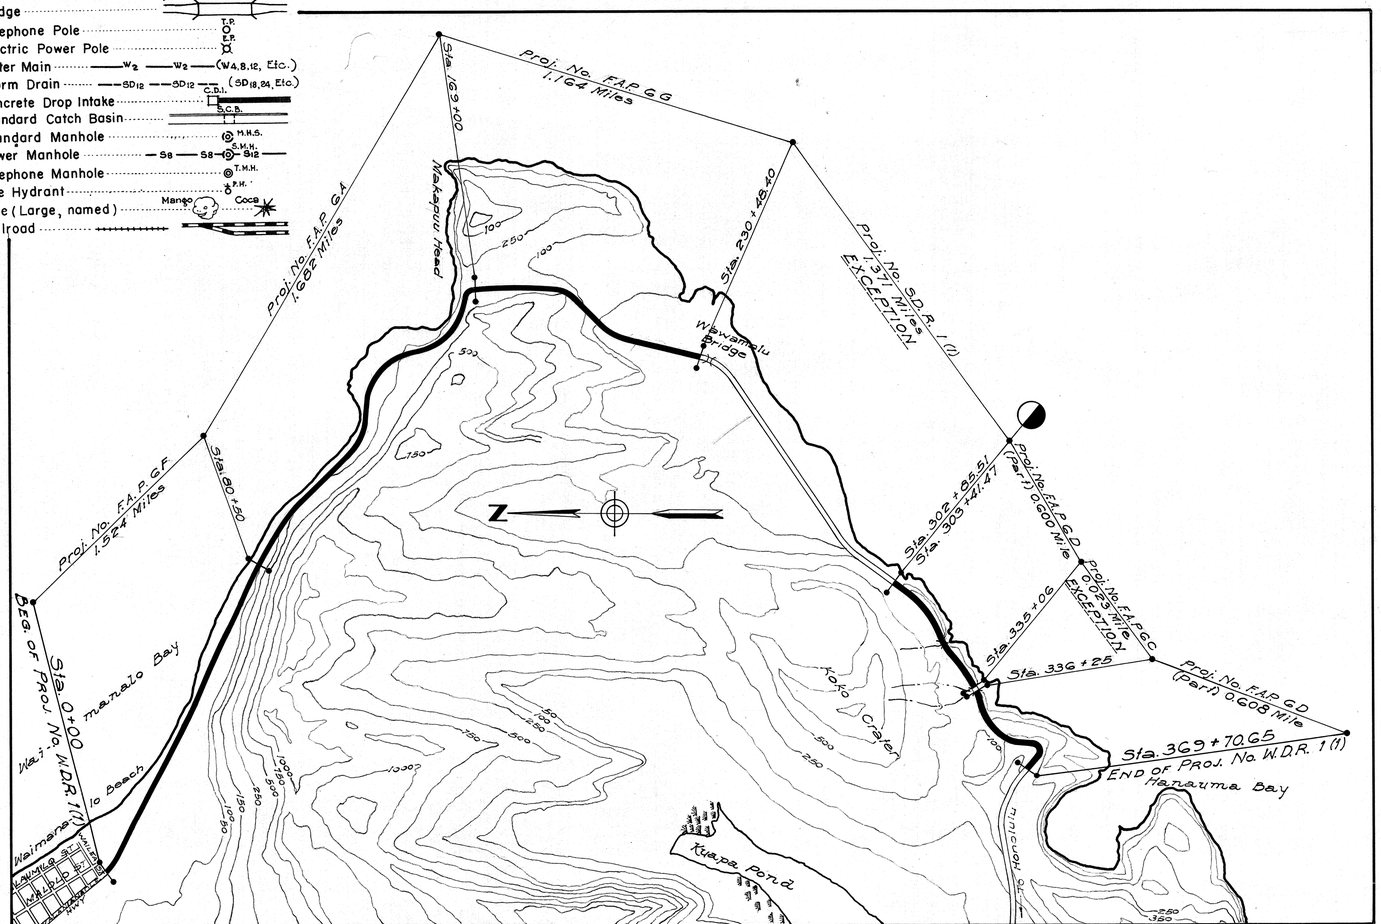

Scale: 1 : 20,000

LAYOUT OF PROJECT

Gross Length of Project: 6.972 Miles
Exception: 1.394 Miles
Net Length of Project: 5.578 Miles

ORIGINAL PLAN		DATE
	SURVEY PLOTTED BY	
	PROFILE BY	" "
	DRAWN BY	" "
NOTE BOOK	TRACED BY	" "
	DESIGN CHECKED BY	" "
No.	QUANTITIES BY	" "
	QUANTITIES CHECKED BY	" "
	CHECKED BY	" "

APPROVED DATE April 21, 1949
Nunbell
TERRITORIAL HIGHWAY ENGINEER

RECOMMENDED FOR APPROVAL DATE [redacted]
[redacted]
DISTRICT ENGINEER
PUBLIC ROADS ADMINISTRATION
FEDERAL WORKS AGENCY

APPROVED DATE [redacted]
[redacted]
DIVISION ENGINEER
PUBLIC ROADS ADMINISTRATION
FEDERAL WORKS AGENCY

5341.1

K & E CO., N.Y.
"KRAL" TRACING CLOTH
PRINTED ON