FED. ROAD DIST. NO.	STATE	FED. AID PROJ. NO.	FISCAL YEAR	SHEET NO.	TOTAL SHEETS
HAWAII	HAW.	F15(5)	1949	3	4

6-28-50
REVISED 10-15-50
REV. 7-22-51

LIST OF PLANT MATERIAL

ITEM NO.	COMMON NAME	BOTANICAL NAME	QUAN.	SPAC.
120(1)	African Tulip	Spathodea campanulata	16	
120(1a)	Barringtonia	Barringtonia asiatica	10	
120(1b)	Breadfruit	Artocarpus incisa	35	
120(1c)	Chinese Banyan	Ficus retusa	30	
120(1d)	Coconut	Cocos nucifera	285	
120(1e)	Golden Shower	Cassia fistula	2	
120(1f)	Gold Tree	Tabebuia donnell-smithii	33	
120(1g)	Hala	Pandanus odoratissimus	108	
120(1h)	Monkeypod	Samanea saman	41	
120(1i)	Yellow Plumeria	Plumiera acutifolia	29	
120(1j)	Salmon-pink Plumeria	Plumiera hybrida	14	
120(1k)	Rainbow Shower	Cassia hybrida	16	
120(2)	Bamboo	Phyllostachys sp.	179	20'x20
120(3)	Brick Bougainvillea	Bougainvillea s. var. lateritia	170	15' r.f.
120(3a)	Crimsonlake Boug.	Bougainvillea glabra var. s	83	15' r.f.
120(3b)	Purple Bougainvillea	Bougainvillea spec. var. p.	~~247~~	10' r.f. 298
120(3c)	Green Ti	Cordyline terminalis	2972	4'x4'
120(3d)	Perennial Morning Glory	Convolvulus purpureus	1520	5 o.c. (SINGLE ROWS)
120(3b)	Shell Ginger	Alpinia nutans	1400	5'x5'
120(3c)	Yellow Ginger	Hedychium flavum	6280	5'x5'
120(3d)	Red Heliconia	Heliconia humilis	800	5'x5'
120(3e)	Yellow, Red Hibiscus	Hibiscus var.	111	
120(3c)	Huapala vine	Bignonia venusta	~~600~~	10' r.f. 549
120(3f)	Naupaka	Scaevola frutescens	1196	8'x8'
120(3g)	Star Jasmine	Jasminum pubescens	460	5'x5'
120(1t)	Poinciana Regia	Poinciana	13	

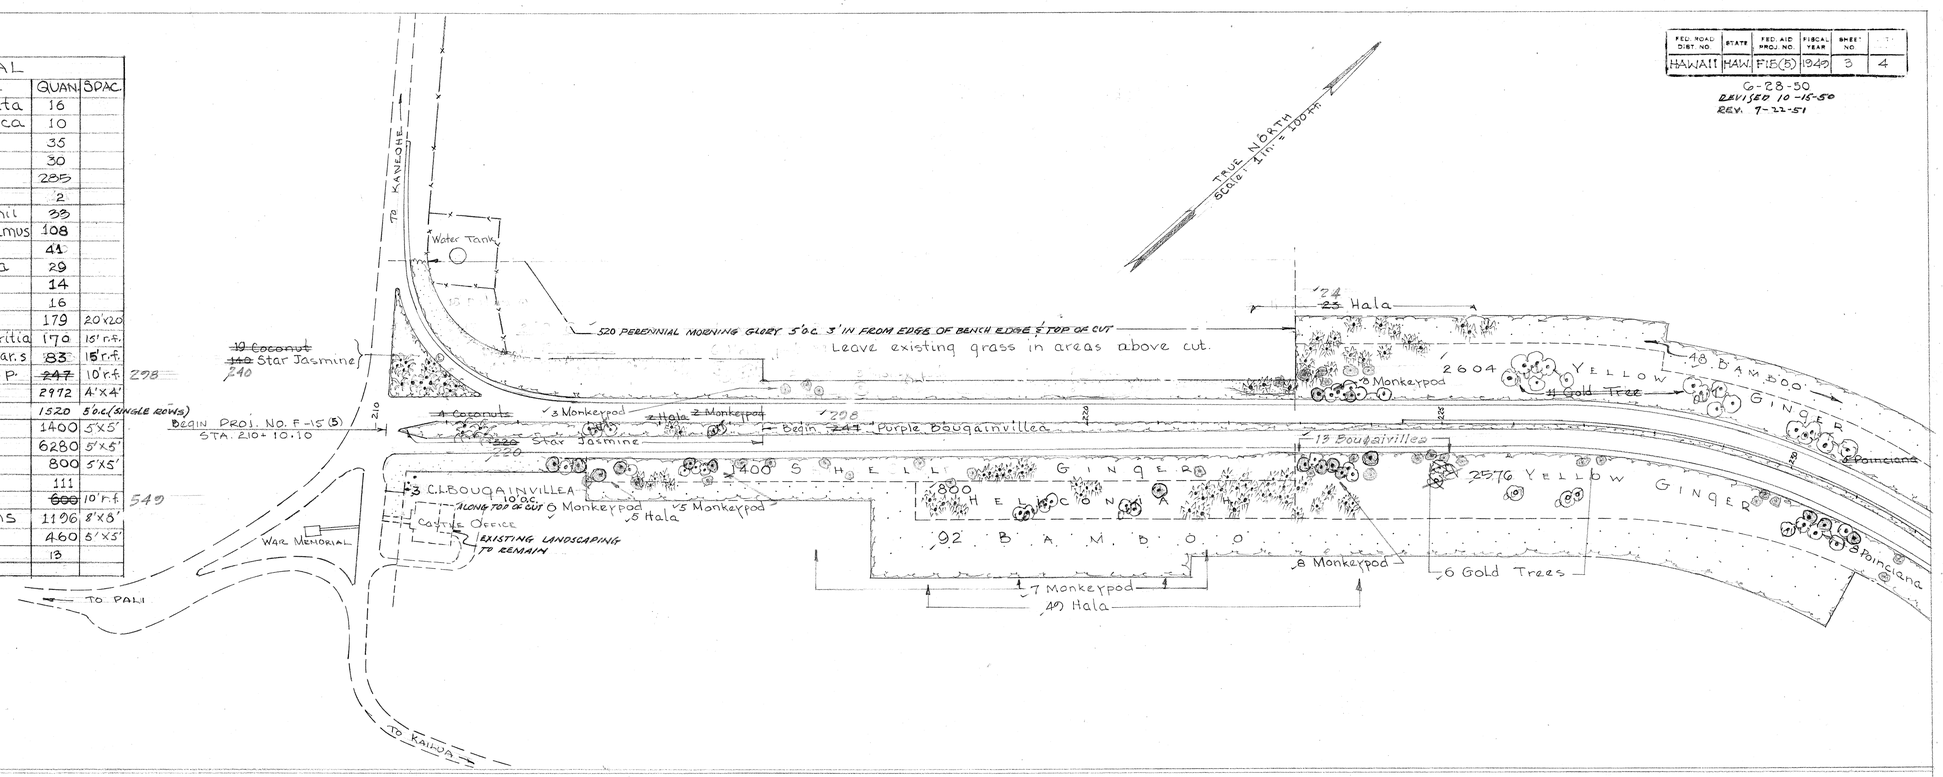

Note: ⊗ Existing trees.

NOTE:

Plant Brick Bougainvillea spaced 15' apart in a single row at the top of cut slope 5' in from cut edge.
Where Green Ti is specified plant 2 rows.
Where section is "bench cut" plant Bougainvillea along top of cut and 5' in from edge of bench (cut)
Trees bet. Sta. 232+50 & 249+00 to be planted on bench (cut) AND SPOTTED ON SITE TO PERMIT FREE PASSAGE OF GRADING, MAINTENANCE AND REPAIR EQUIPMENT ON BENCHES.

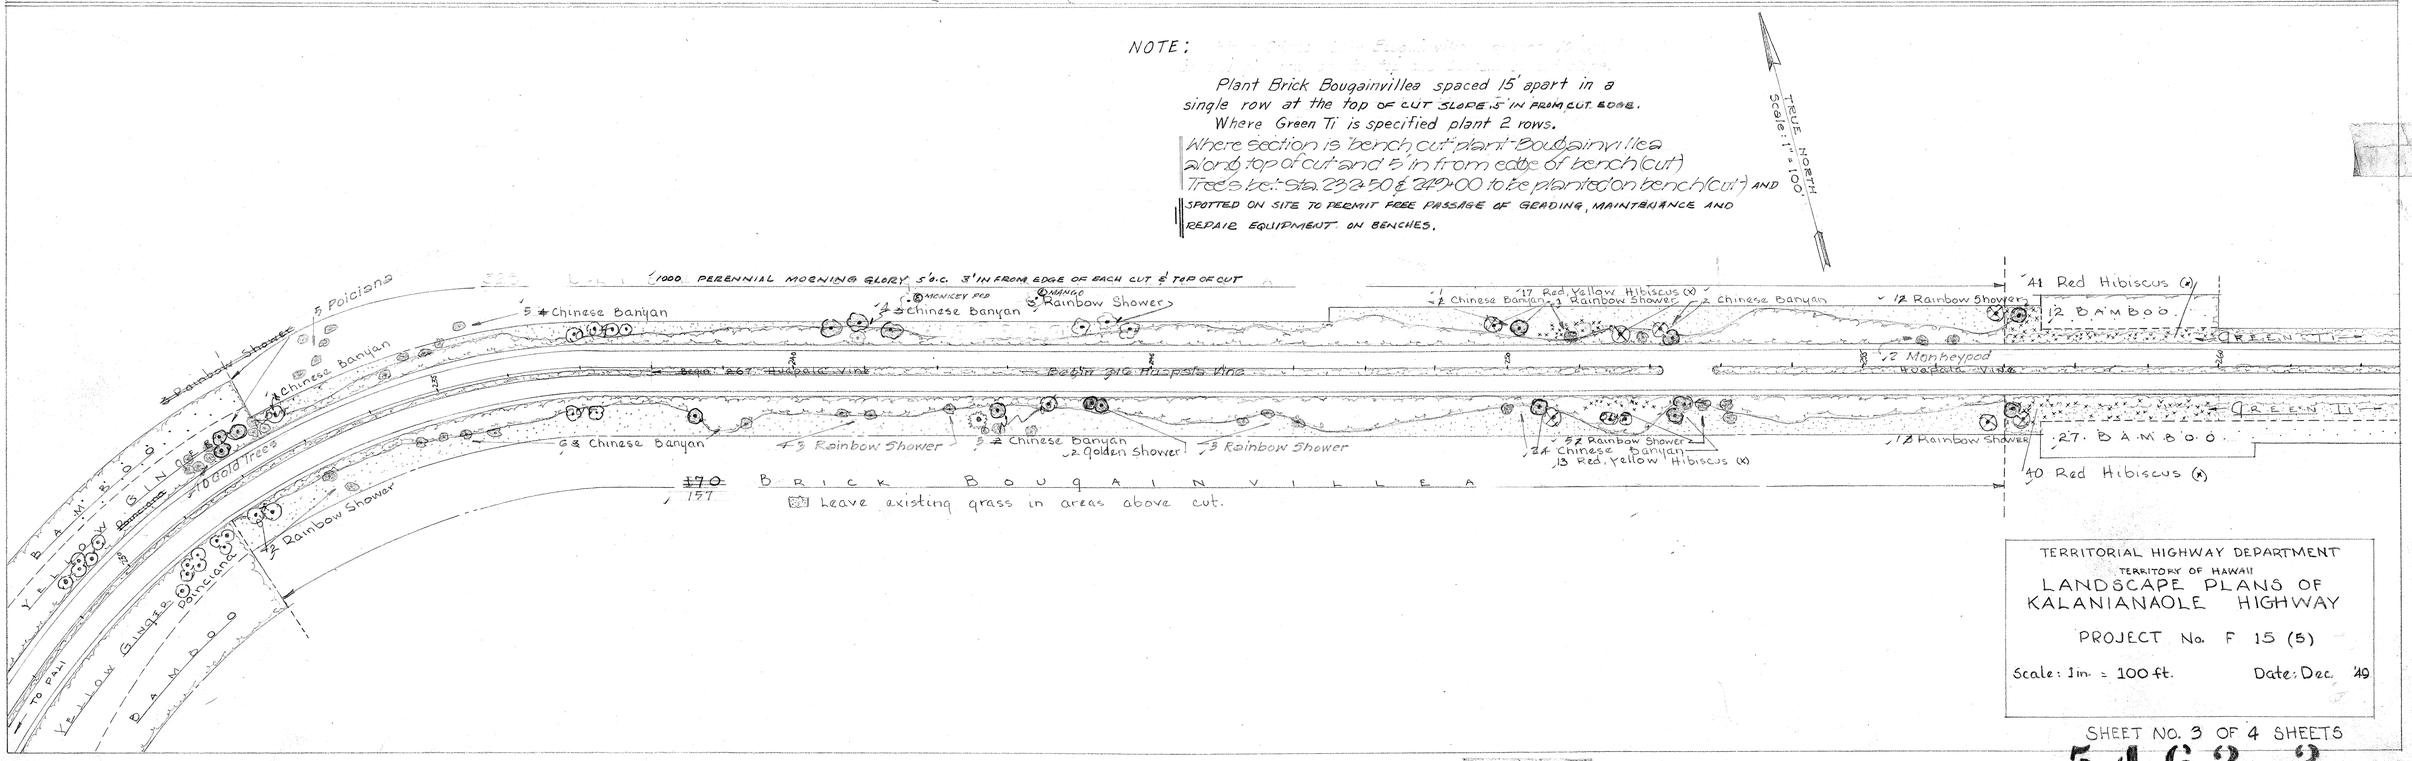

TERRITORIAL HIGHWAY DEPARTMENT
TERRITORY OF HAWAII
LANDSCAPE PLANS OF
KALANIANAOLE HIGHWAY

PROJECT No. F 15 (5)

Scale: 1 in. = 100 ft. Date: Dec. '49

SHEET NO. 3 OF 4 SHEETS

5462.3

FED. ROAD DIST. NO.	STATE	FED. AID PROJ. NO.	FISCAL YEAR	SHEET NO.	TOTAL SHEETS
HAWAII	HAW	F15(5)	1949	4	4

6-28-50

TERRITORIAL HIGHWAY DEPARTMENT
TERRITORY OF HAWAII
LANDSCAPE PLANS OF
KALANIANAOLE HIGHWAY
PROJECT No. F - 15 (5)
Scale: 1 in. = 100 ft. Date: Dec. 49

SHEET No. 4 OF 4 SHEETS

5462.4