FED. ROAD DIST. NO.	STATE	FED. AID PROJ. NO.	FISCAL YEAR	SHEET NO.	TOTAL SHEETS
HAWAII	HAW.				

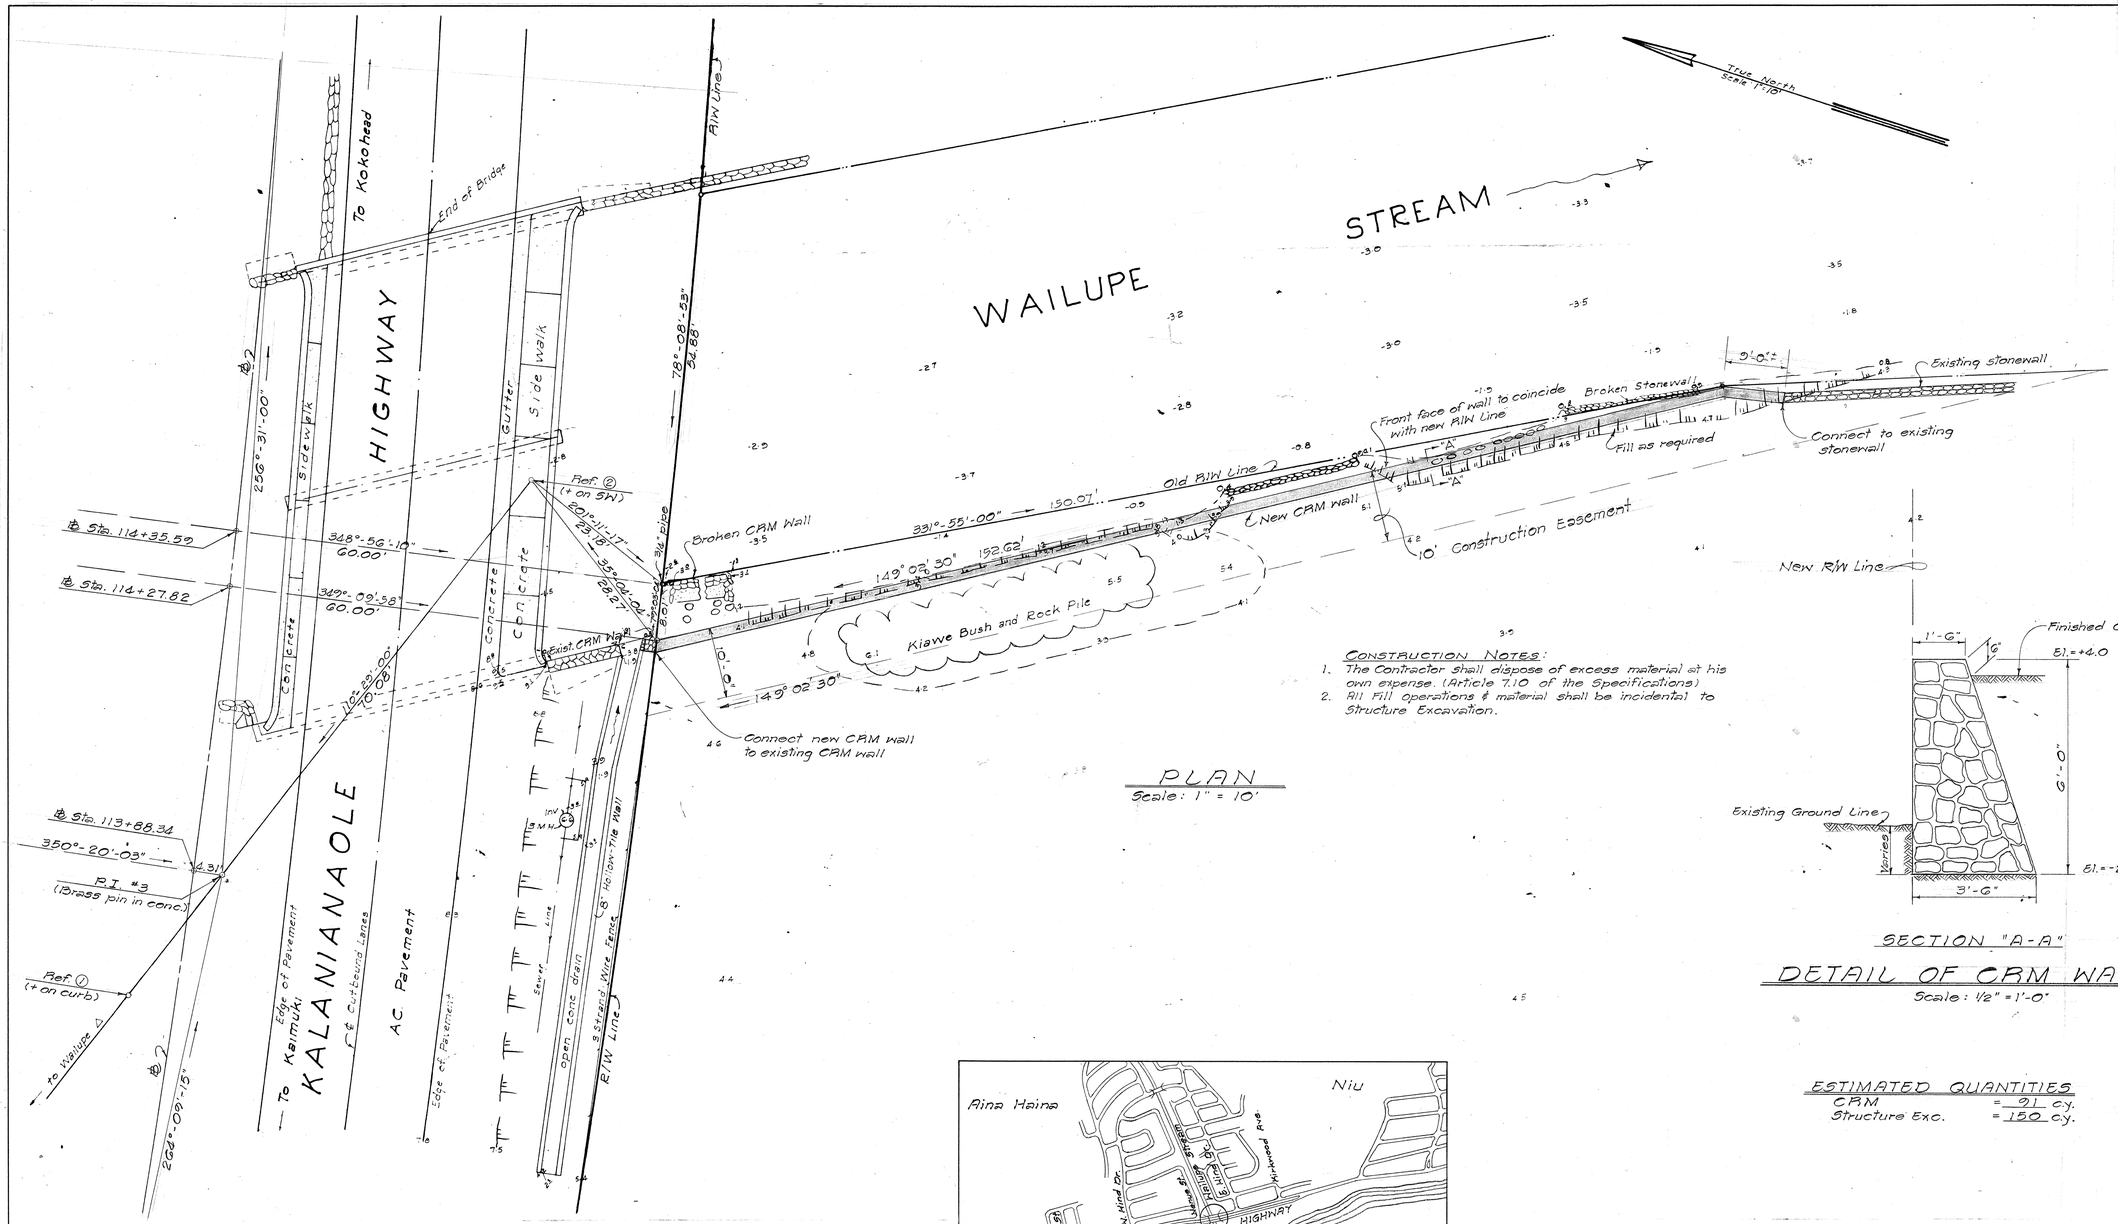

PLAN
Scale: 1" = 10'

CONSTRUCTION NOTES:
1. The Contractor shall dispose of excess material at his own expense. (Article 7.10 of the Specifications)
2. All Fill operations & material shall be incidental to Structure Excavation.

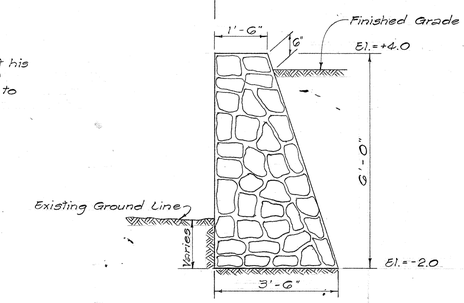

SECTION "A-A"

DETAIL OF CRM WALL
Scale: 1/2" = 1'-0"

ESTIMATED QUANTITIES
CRM = 91 c.y.
Structure Exc. = 150 c.y.

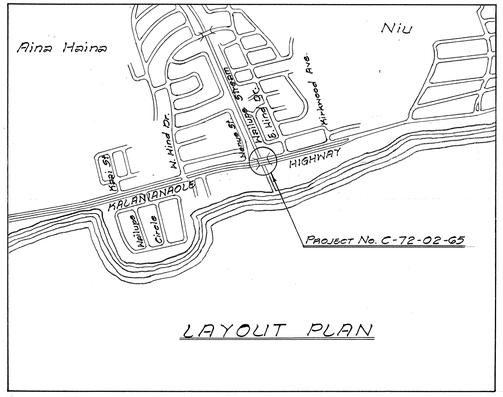

LAYOUT PLAN

APPROVED:

Lizio Ukuwela 19 Apr 65
DIRECTOR OF TRANSPORTATION DATE

STATE OF HAWAII
DEPARTMENT OF TRANSPORTATION
HIGHWAYS DIVISION

MISCELLANEOUS IMPROVEMENTS OF CERTAIN DRAINAGE FACILITIES ON OAHU - UNIT 1
(Construction of Cement Rubble Masonry Wall along Wailupe Stream)

Project No. C-72-02-65

Scale: As Shown Date: April, 1965