FED. ROAD DIST. NO.	STATE	FED. AID PROJ. NO.	FISCAL YEAR	SHEET NO.	TOTAL SHEETS
HAWAII	HAW.	F-072-1(24)	1969	1	26

INDEX TO DRAWINGS

SHEET NO.	DESCRIPTION
1	TITLE SHEET
2 - 3	TYPICAL SECTION
4 - 8	PLAN & PROFILE
9 - 10	DETAIL PLAN OF ROADWAY
11 - 14	DRAINAGE DETAILS
15 - 16	TRAFFIC SIGNS & PAVEMENT MARKERS
17 - 26	STANDARD DETAILS

STATE OF HAWAII
DEPARTMENT OF TRANSPORTATION
HIGHWAYS DIVISION
HONOLULU, HAWAII
"AS BUILT"
PLANS FOR

KALANIANAOLE HIGHWAY
KEOLU DRIVE EXTENSION VICINITY
TOWARD SADDLE CITY

FEDERAL AID PROJECT NO. F-072-1(24)

DISTRICT OF KOOLAUPOKO
ISLAND OF OAHU

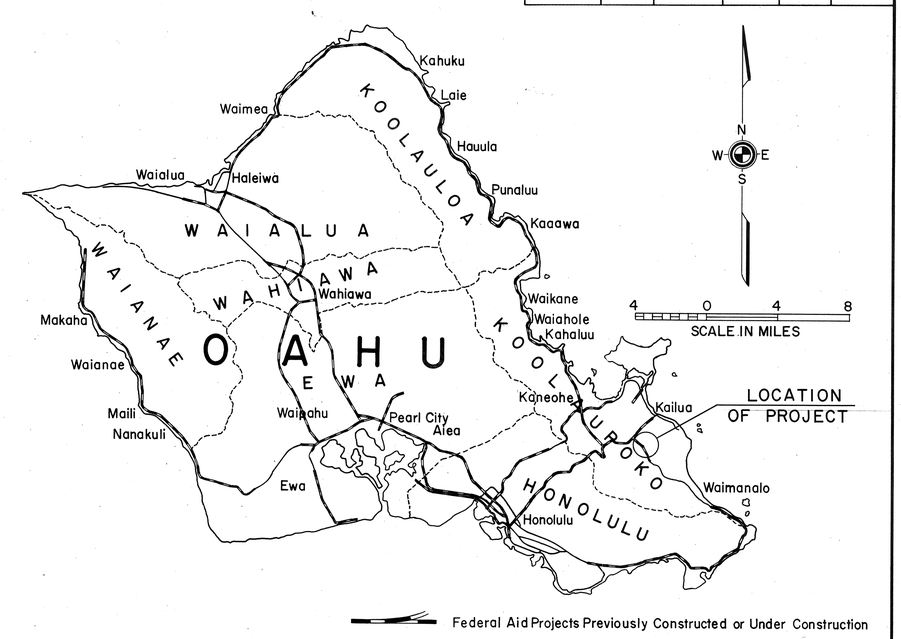

NOTE:
ALL CHANGES MADE DURING CONSTRUCTION HAVE BEEN NOTED ON THESE TRACINGS IN RED AND CHECKED BY:

PROJECT ENGINEER

July 7, 1971
DATE

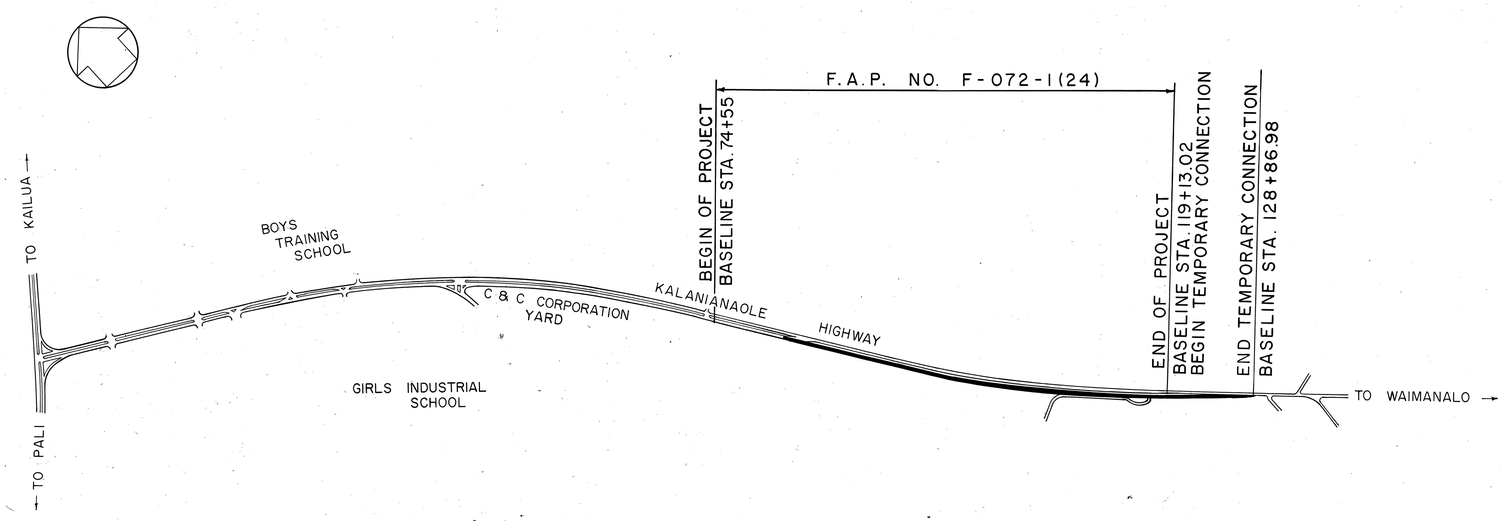

LAYOUT PLAN

800 0 800 1600 2400
SCALE IN FEET

DESIGN CLASSIFICATION

ADT (1969) 9,500
DESIGN ADT (1989) . . 13,500
DHV . . . . . 10 %
D 65/35
T . . . . . 3 %
T_{24} . . . . . 4 %
V . . . . . 60 M.P.H.

GROSS LENGTH OF PROJECT . . . . . 0.844 Mi.
LESS BRIDGES OVER 20'-0" SPAN . . . 0.0 Mi.
NET LENGTH OF ROADWAY . . . . . 0.844 Mi.

DEPARTMENT OF TRANSPORTATION BUREAU OF PUBLIC ROADS	
APPROVED:	
for DIVISION ENGINEER	6-24-69 DATE

DEPARTMENT OF TRANSPORTATION STATE OF HAWAII	
APPROVED:	
for DIR. OF TRANSPORTATION	5/14/69 DATE

R. Mikami