FED. ROAD DIST. NO.	STATE	PROJ. NO.	FISCAL YEAR	SHEET NO.	TOTAL SHEETS
HAWAII	HAW.	72A-02-71 72A-01-72	1971	1	8

INDEX TO DRAWINGS

SHEET NO.	DESCRIPTION
1	TITLE SHEET
2 - 4	PLAN AND PROFILE
5 - 6	DRAINAGE DETAILS
7	STANDARD DETAIL
8	PROJECT INFORMATION SIGN

STATE OF HAWAII

DEPARTMENT OF TRANSPORTATION

HIGHWAYS DIVISION

HONOLULU, HAWAII

"AS BUILT" PLANS FOR

KALANIANAOLE HIGHWAY

C&C CORPORATION YARD TO KEOLU DRIVE INTERSECTION

KALANIANAOLE HIGHWAY
DRAINAGE IMPROVEMENTS
PROJECT NO. 72A-02-71

KALANIANAOLE HIGHWAY LANDSCAPING
PROJECT NO. 72A-01-72

DISTRICT OF KOOLAUPOKO
ISLAND OF OAHU

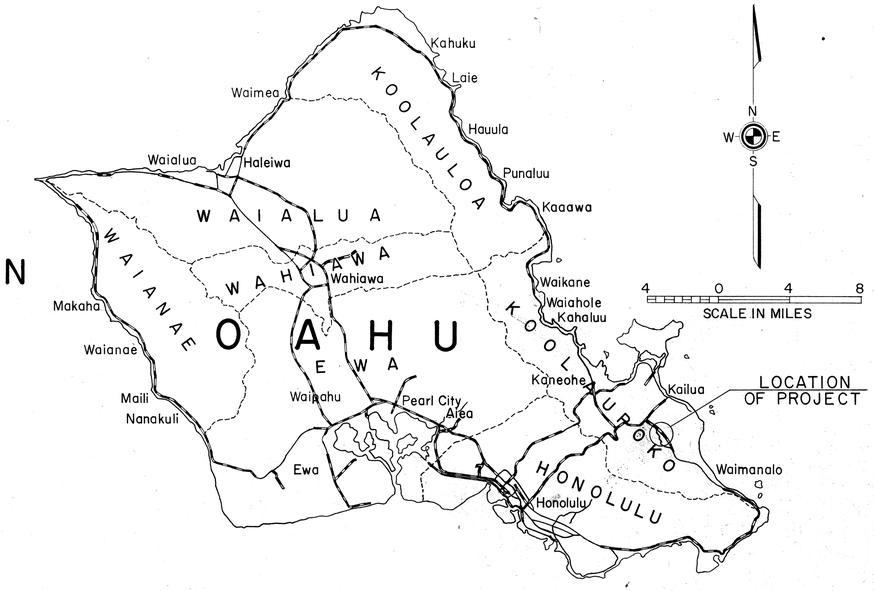

NOTE:

ALL THE QUANTITIES SHOWN ARE ORIGINAL THEORETICAL QUANTITIES. FOR ACTUAL QUANTITIES, REFER TO PROJECT LEDGER AND/OR COMPUTATION BOOK.

ALL CHANGES MADE DURING CONSTRUCTION HAVE BEEN INCORPORATED ON THESE PLANS.

Robert J. Alexander
PROJECT ENGINEER

10/6/72
DATE

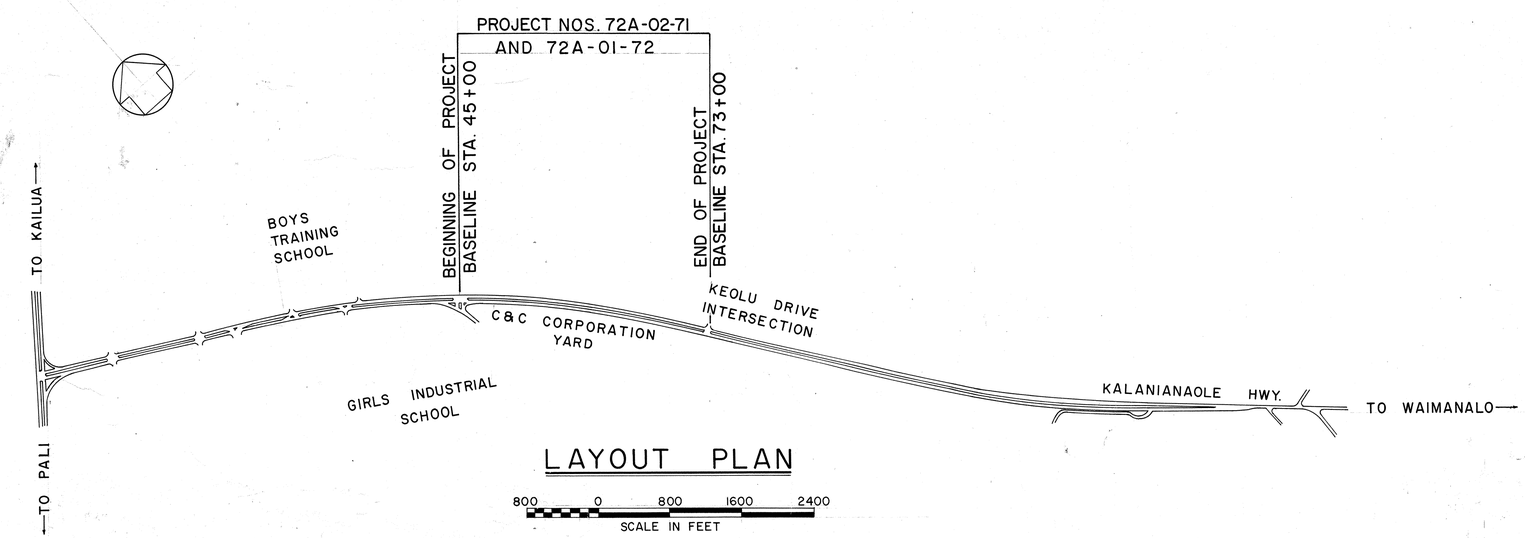

LAYOUT PLAN

800 0 800 1600 2400
SCALE IN FEET

DEPARTMENT OF TRANSPORTATION
STATE OF HAWAII

APPROVED:

Tsuneyo Lee
For DIR. OF TRANSPORTATION

9/29/71
DATE

D. Bevier September, 1971