FED. ROAD DIST. NO.	STATE	PROJ. NO.	FISCAL YEAR	SHEET NO.	TOTAL SHEETS
HAWAII	HAW.	72C-01-75M	1974	1	8

INDEX TO DRAWINGS

SHEET NO.	DESCRIPTION
1	TITLE SHEET
2	TYPICAL SECTION & GENERAL NOTES
3-6	PAVEMENT MARKINGS
7-8	TYPICAL DETAILS - PAVEMENT MARKINGS & RAISED PAVEMENT MARKERS

STATE OF HAWAII

DEPARTMENT OF TRANSPORTATION
HIGHWAYS DIVISION

HONOLULU, HAWAII

"AS BUILT" PLANS FOR

KALANIANAOLE HIGHWAY RESURFACING

KIRKWOOD STREET TO MAY WAY

PROJECT NO. 72C-01-75M

DISTRICT OF HONOLULU
ISLAND OF OAHU

NOTE:
ALL CHANGES MADE DURING CONSTRUCTION HAVE BEEN INCORPORATED ON THESE PLANS IN RED EXCEPT CHANGES IN THE ORIGINAL THEORETICAL QUANTITIES.

Ralph T. Hirie — PROJECT ENGINEER
1-6-76 — DATE

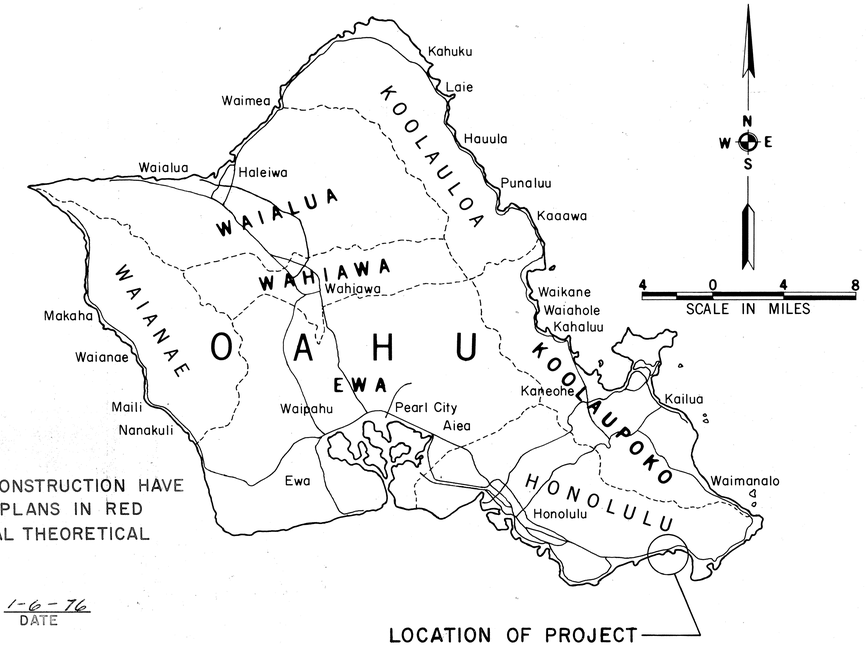

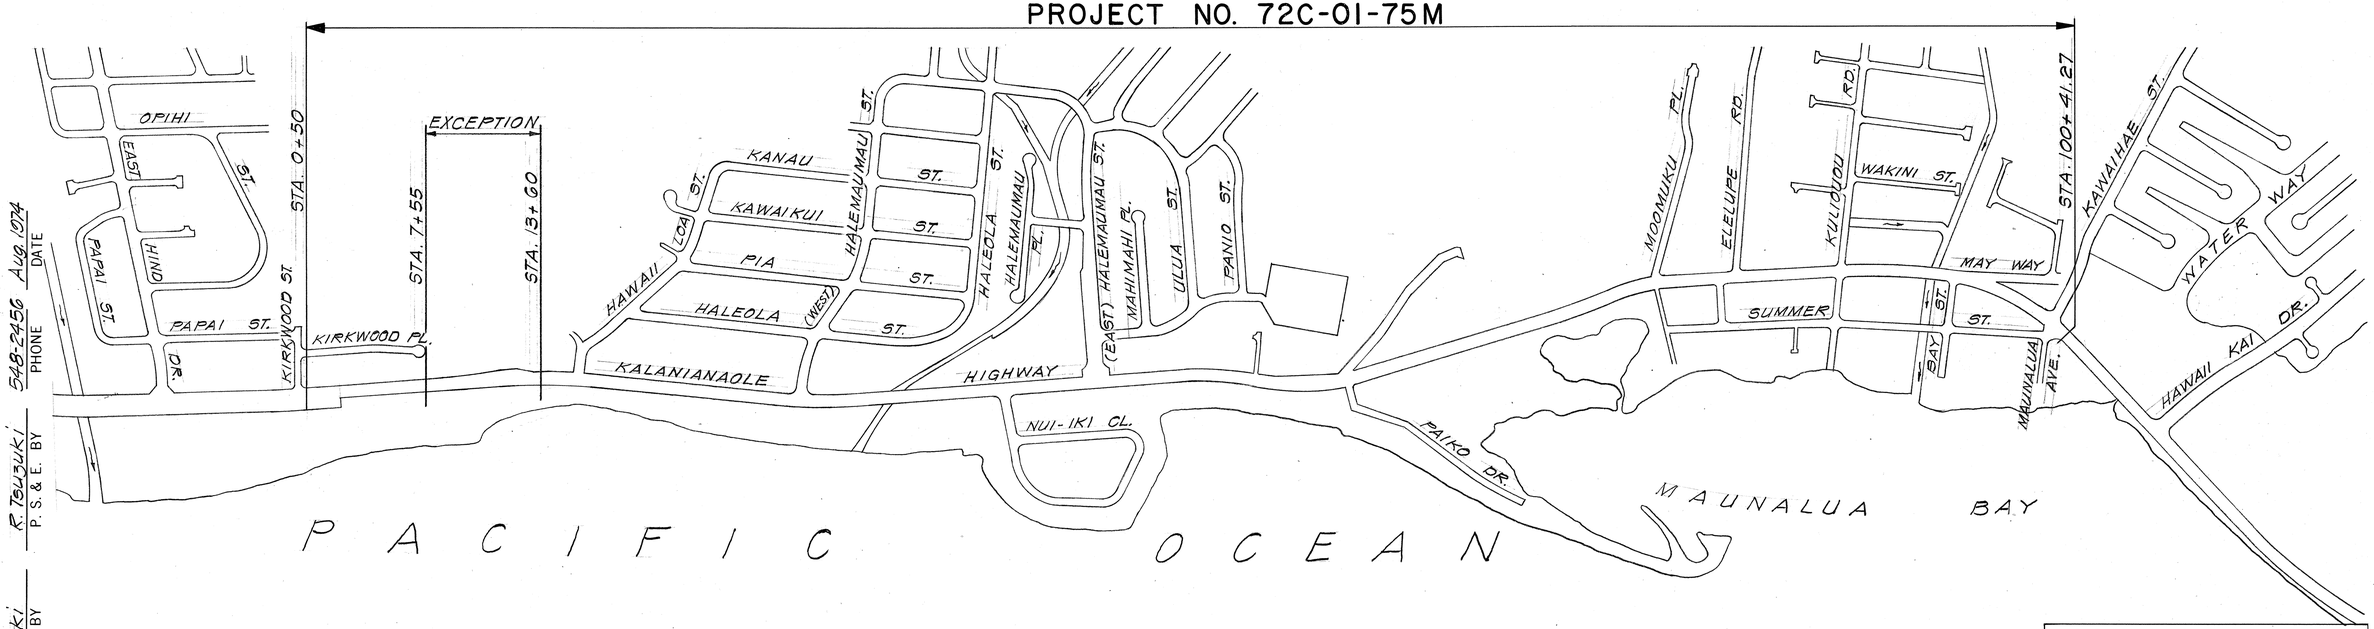

LAYOUT PLAN

GROSS LENGTH OF PROJECT ___ 1.89 MI.
NET LENGTH OF PROJECT _____ 1.78 MI.

R. TSUZUKI — DESIGNED BY	
R. TSUZUKI — P. S. & E. BY	548-2456 — PHONE
	Aug. 1974 — DATE

DEPARTMENT OF TRANSPORTATION
STATE OF HAWAII

APPROVED:
Mummy Lee — FOR DIR. OF TRANSPORTATION
10/29/74 — DATE