FED. ROAD DIST. NO.	STATE	PROJ. NO.	FISCAL YEAR	SHEET NO.	TOTAL SHEETS
HAWAII	HAW.	72C-02-73 Phase II	1974	12	23

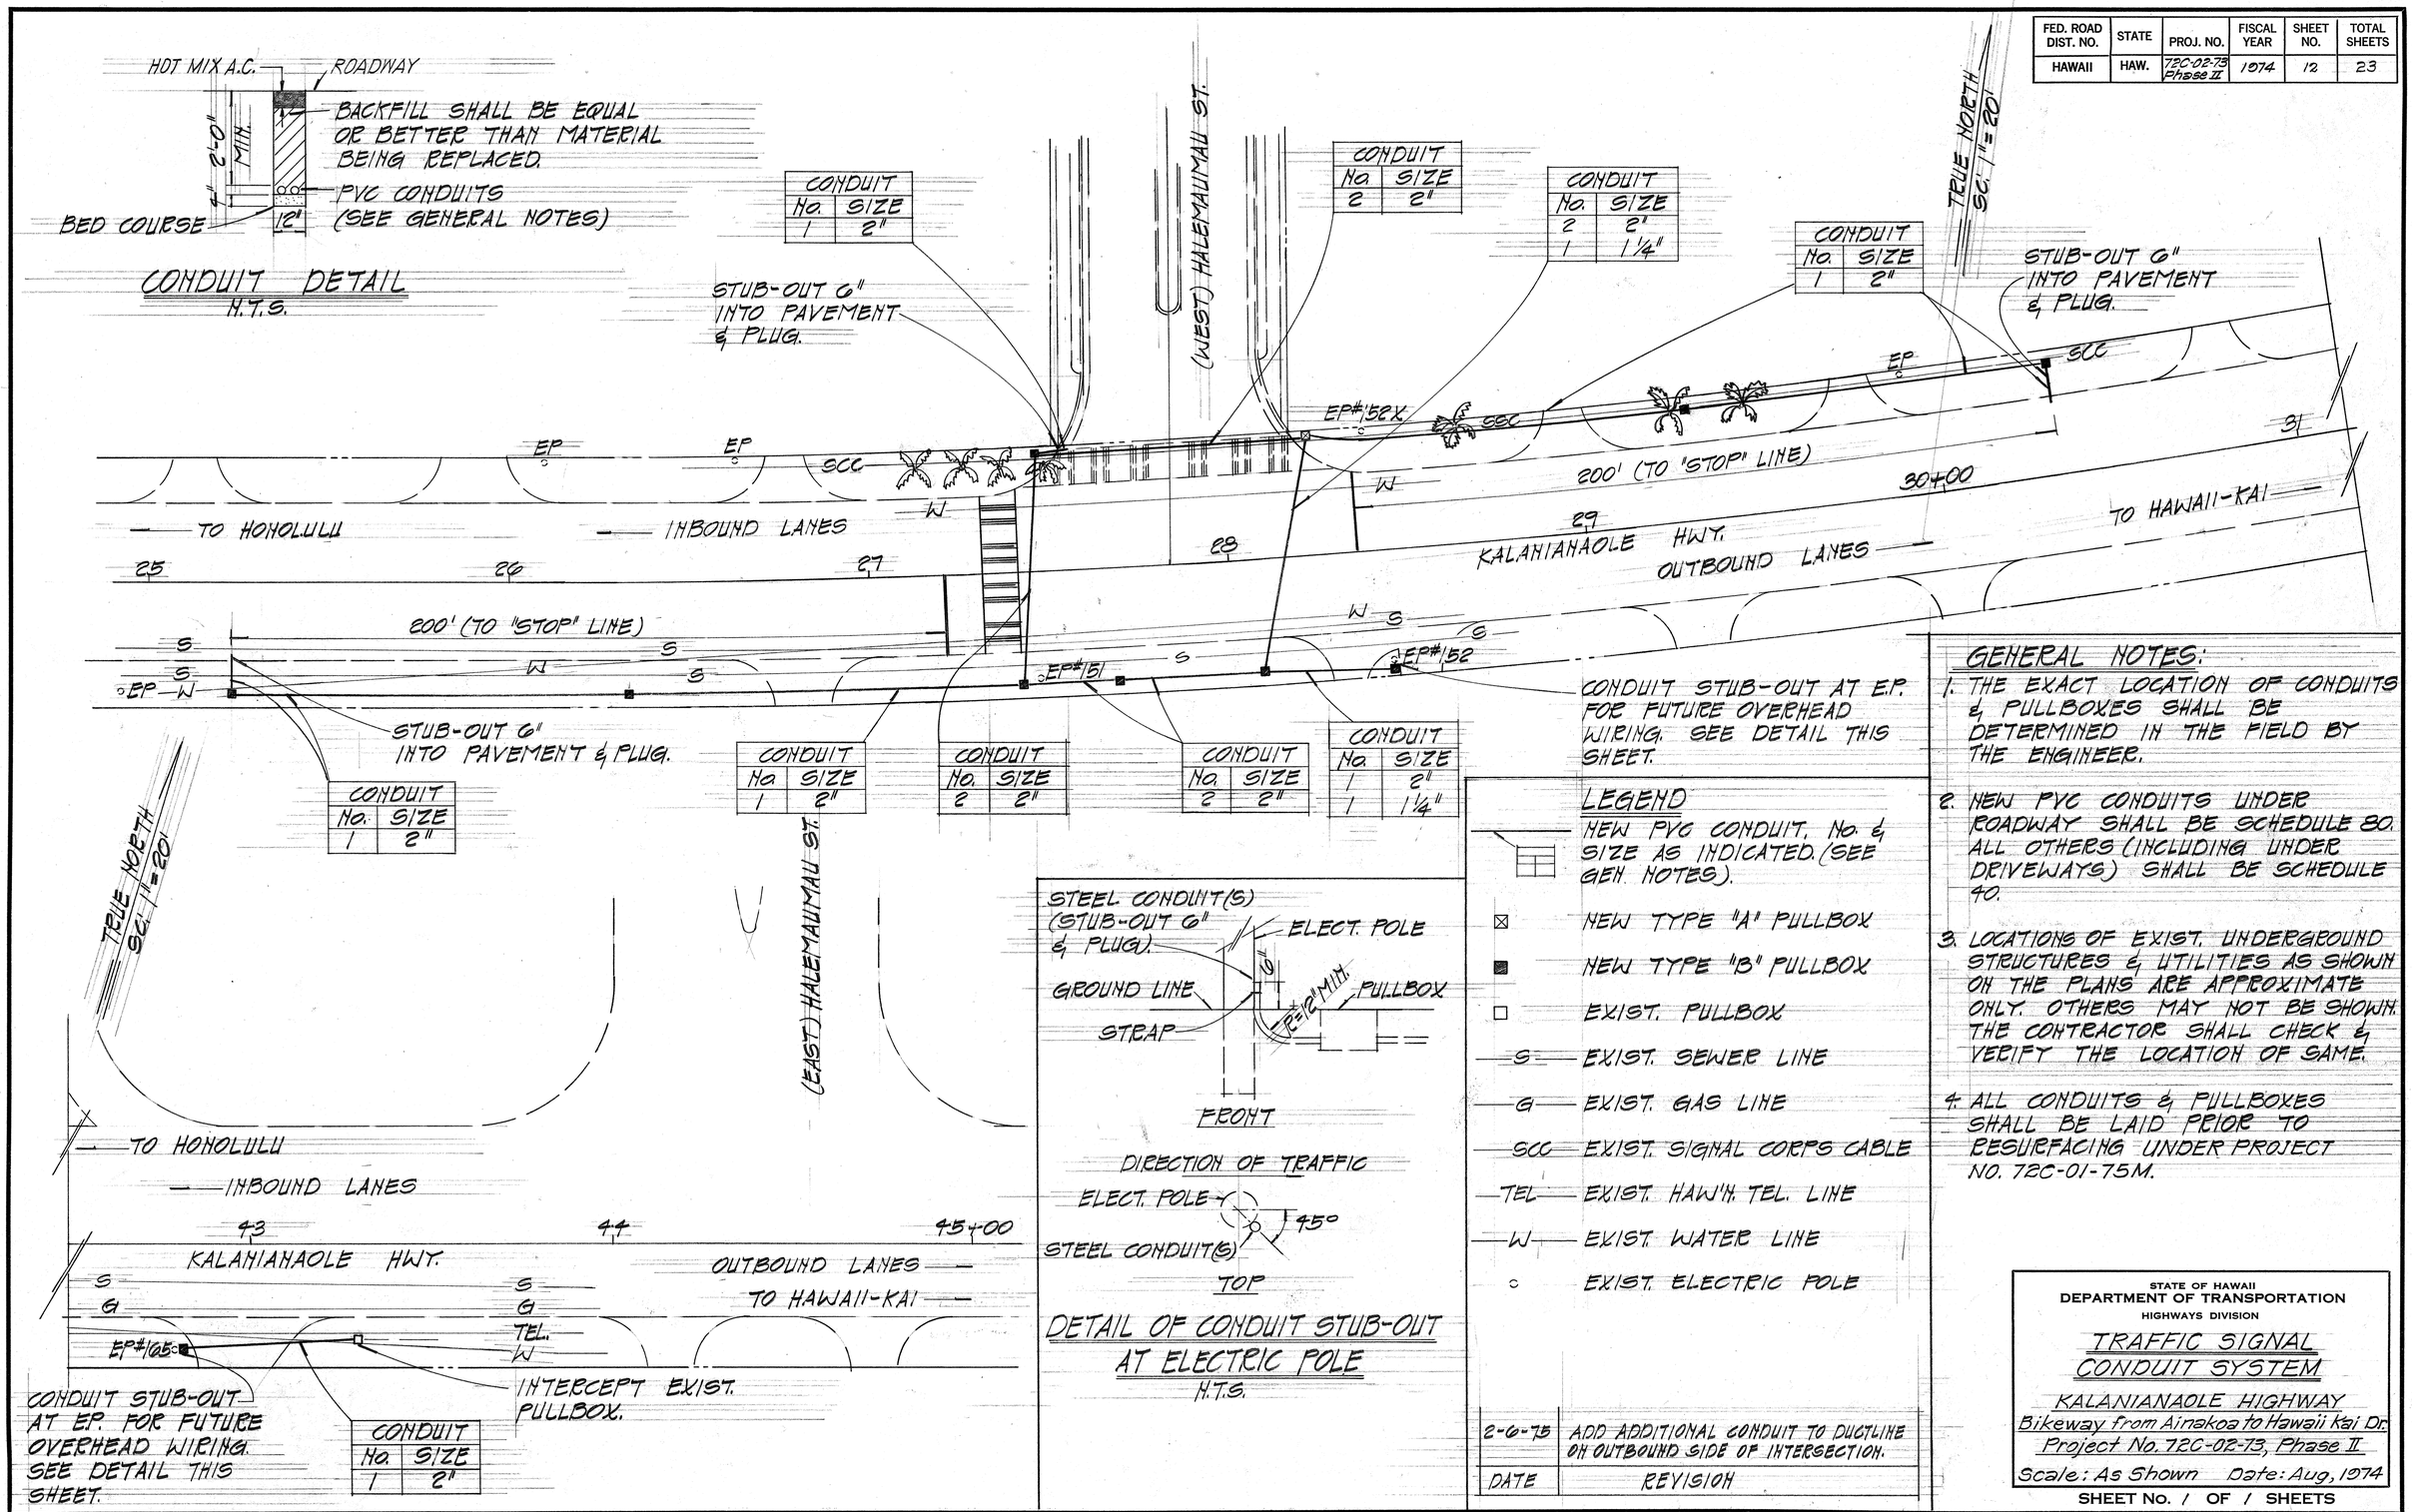

CONDUIT	
No.	SIZE
1	2"

CONDUIT	
No.	SIZE
2	2"

CONDUIT	
No.	SIZE
2	2"
1	1¼"

CONDUIT	
No.	SIZE
1	2"

CONDUIT	
No.	SIZE
1	2"

CONDUIT	
No.	SIZE
2	2"

CONDUIT	
No.	SIZE
2	2"
1	1¼"

CONDUIT	
No.	SIZE
1	2"

GENERAL NOTES:

1. THE EXACT LOCATION OF CONDUITS & PULLBOXES SHALL BE DETERMINED IN THE FIELD BY THE ENGINEER.
2. NEW PVC CONDUITS UNDER ROADWAY SHALL BE SCHEDULE 80. ALL OTHERS (INCLUDING UNDER DRIVEWAYS) SHALL BE SCHEDULE 40.
3. LOCATIONS OF EXIST. UNDERGROUND STRUCTURES & UTILITIES AS SHOWN ON THE PLANS ARE APPROXIMATE ONLY. OTHERS MAY NOT BE SHOWN. THE CONTRACTOR SHALL CHECK & VERIFY THE LOCATION OF SAME.
4. ALL CONDUITS & PULLBOXES SHALL BE LAID PRIOR TO RESURFACING UNDER PROJECT NO. 72C-01-75M.

LEGEND

- NEW PVC CONDUIT, No. & SIZE AS INDICATED. (SEE GEN. NOTES).
- NEW TYPE "A" PULLBOX
- NEW TYPE "B" PULLBOX
- EXIST. PULLBOX
- S — EXIST. SEWER LINE
- G — EXIST. GAS LINE
- SCC — EXIST. SIGNAL CORPS CABLE
- TEL — EXIST. HAW'N. TEL. LINE
- W — EXIST. WATER LINE
- EXIST. ELECTRIC POLE

DATE	REVISION
2-6-75	ADD ADDITIONAL CONDUIT TO DUCTLINE ON OUTBOUND SIDE OF INTERSECTION.

STATE OF HAWAII
DEPARTMENT OF TRANSPORTATION
HIGHWAYS DIVISION

TRAFFIC SIGNAL CONDUIT SYSTEM

KALANIANAOLE HIGHWAY
Bikeway from Ainakoa to Hawaii Kai Dr.
Project No. 72C-02-73, Phase II

Scale: As Shown Date: Aug, 1974

SHEET No. 1 OF 1 SHEETS

ORIGINAL PLAN	SURVEY PLOTTED BY	DATE
	DRAWN BY	"
	TRACED BY	"
NOTE BOOK	DESIGNED BY	"
No.	QUANTITIES BY	"
	CHECKED BY	"

C.O. 12