FED. ROAD DIST. NO.	STATE	PROJ. NO.	FISCAL YEAR	SHEET NO.	TOTAL SHEETS
HAWAII	HAW.	72A-01-79M LT-0-01-79M	1979	1	8

INDEX TO DRAWINGS

SHEET NO.	DESCRIPTION
1	TITLE SHEET
2 - 3	TYPICAL SECTION & DETAILS, PROJECT NO. 72A-01-79M
4 - 5	TYPICAL SECTION & DETAILS, PROJECT NO. LT-0-01-79M
6 - 8	STANDARD DETAILS

STATE OF HAWAII

DEPARTMENT OF TRANSPORTATION

LAND TRANSPORTATION FACILITIES DIVISION

"AS BUILT" PLANS FOR

KALANIANAOLE HIGHWAY RESURFACING

KAILUA ROAD TO C&C CORPORATION YARD

PROJECT NO. 72A-01-79M

DISTRICT OF KOOLAUPOKO

AND

KALANIANAOLE HIGHWAY RESURFACING

SEA LIFE PARK TO BLOW HOLE LOOKOUT

PROJECT NO. LT-0-01-79M

DISTRICT OF KOOLAUPOKO AND HONOLULU

ISLAND OF OAHU

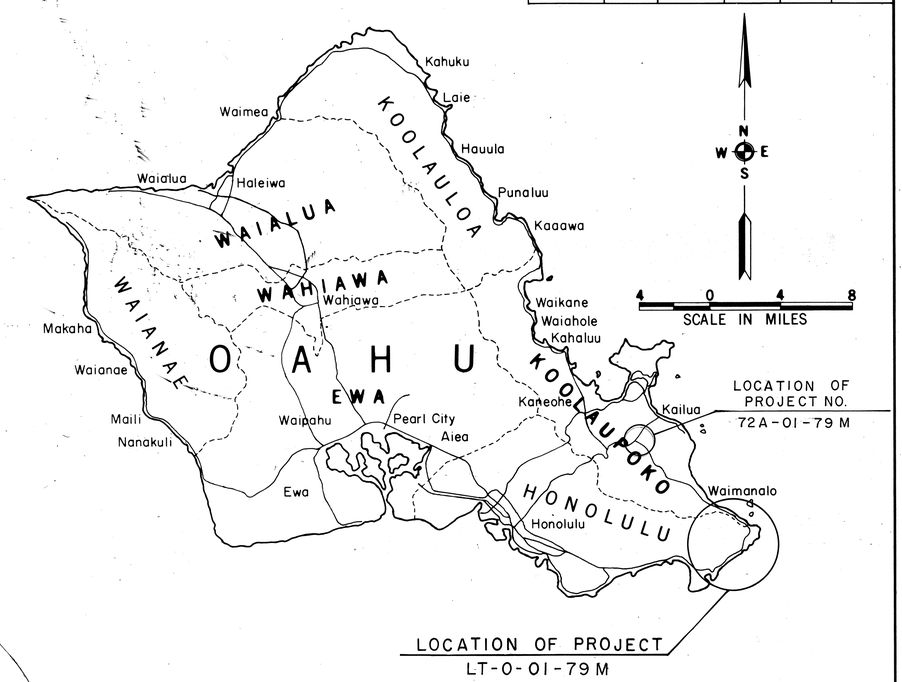

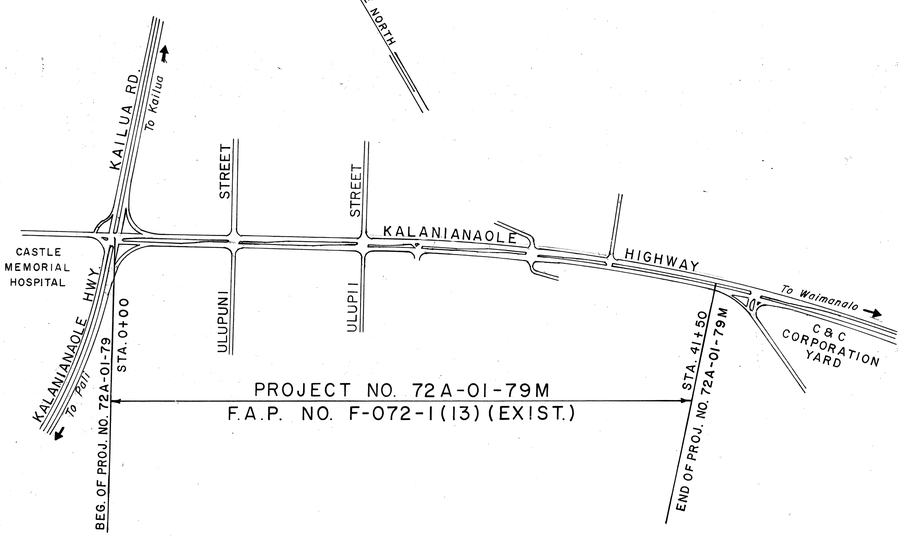

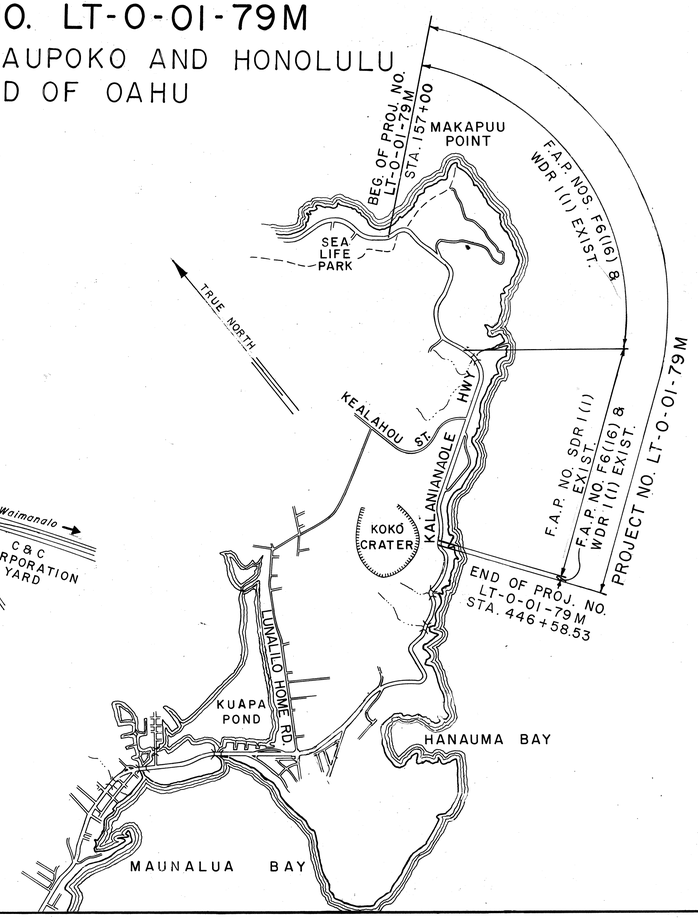

PROJECT NO. 72A-01-79M
Length of Project - 0.7784 Miles

PROJECT NO. LT-0-01-79M
Length of Project - 2.3240 Miles

NOTE:

ALL CHANGES MADE DURING CONSTRUCTION HAVE BEEN INCORPORATED ON THESE PLANS IN RED EXCEPT CHANGES IN THE ORIGINAL THEORETICAL QUANTITIES.

Robert Y. Muronaka — 3/5/79
PROJECT ENGINEER — DATE

DEPARTMENT OF TRANSPORTATION
STATE OF HAWAII
APPROVED:
Ryokichi Higashionna 7/25/78
DIR. OF TRANSPORTATION — DATE

DESIGN UNIT "A"	R. Mikami	548-7534	7/25/78
DESIGNED BY	P. S. & E. BY	PHONE	DATE

LT-0-01-79M 6130-2/22
72A-01-79M 6164-2/22

D-8-8