FED. ROAD DIST. NO.	STATE	PROJ. NO.	FISCAL YEAR	SHEET NO.	TOTAL SHEETS
HAWAII	HAW.	72C-01-79M	1979	1	8

INDEX TO DRAWINGS

SHEET NO.	DESCRIPTION
1	TITLE SHEET
2	TYPICAL SECTIONS & GENERAL NOTES
3	MISCELLANEOUS DETAILS
4*	QUANTITY SCHEDULES
5-8	STANDARD DETAILS
*4 S-1	RECONSTRUCTION AREAS SCHEDULE

TOTAL SHEET COUNT AFTER "AS-BUILT" POSTING: 9 SHEETS

STATE OF HAWAII

DEPARTMENT OF TRANSPORTATION

LAND TRANSPORTATION FACILITIES DIVISION

"AS BUILT"

PLANS FOR

KALANIANAOLE HIGHWAY RESURFACING

VICINITY OF AINAKOA AVENUE TO KIRKWOOD STREET

PROJECT NO. 72C-01-79M

DISTRICT OF HONOLULU
ISLAND OF OAHU

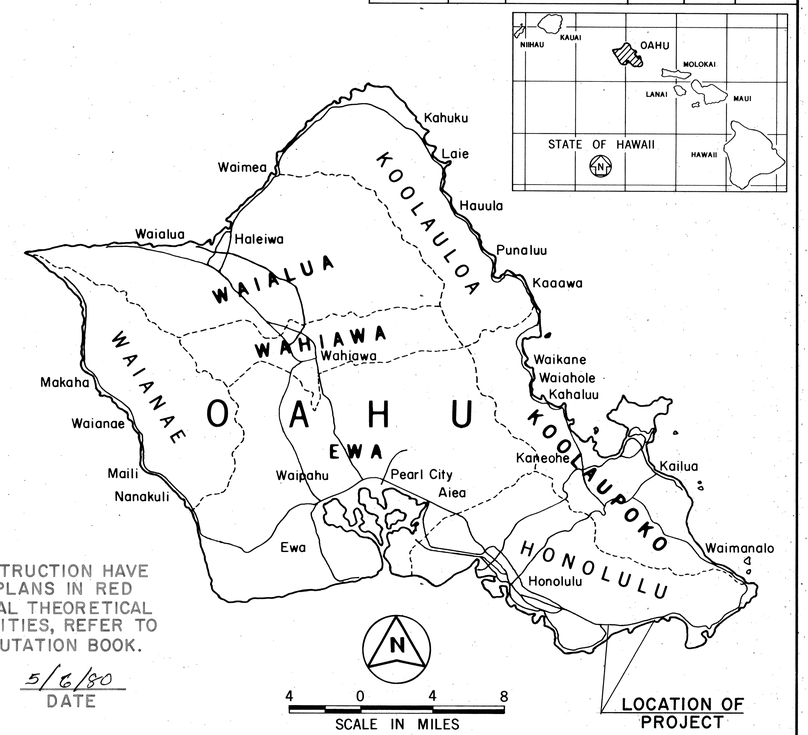

NOTE:

ALL CHANGES MADE DURING CONSTRUCTION HAVE BEEN INCORPORATED ON THESE PLANS IN RED EXCEPT CHANGES IN THE ORIGINAL THEORETICAL QUANTITIES. FOR ACTUAL QUANTITIES, REFER TO PROJECT LEDGER AND/OR COMPUTATION BOOK.

Albert Y. Mahi — RESIDENT ENGINEER — 5/6/80 DATE

RONALD TSUZUKI — DESIGNED AND PS&E BY:
JULY, 1978 — DATE
548-2456 — PHONE

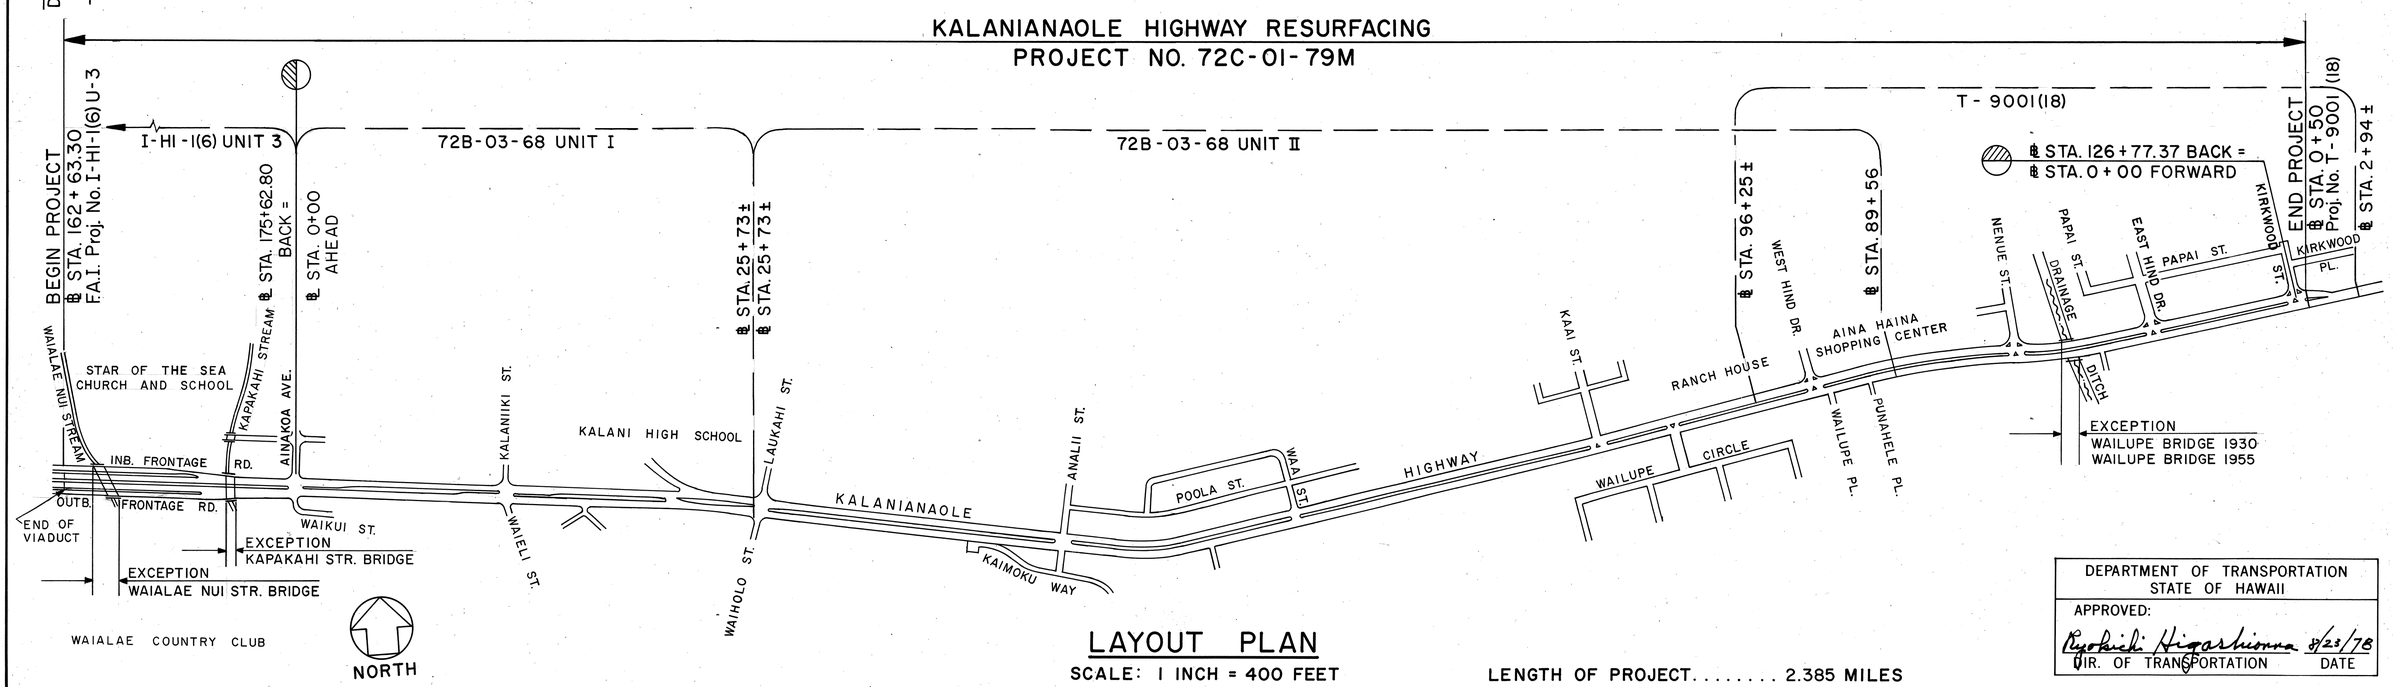

LAYOUT PLAN

SCALE: 1 INCH = 400 FEET

LENGTH OF PROJECT..... 2.385 MILES

DEPARTMENT OF TRANSPORTATION
STATE OF HAWAII

APPROVED:

Ryokichi Higashionna — DIR. OF TRANSPORTATION — 8/23/78 DATE