FED. ROAD DIST. NO.	STATE	~~FED. AID~~ PROJ. NO.	FISCAL YEAR	SHEET NO.	TOTAL SHEETS
HAWAII	HAW.	72A-01-78	1979	3	11

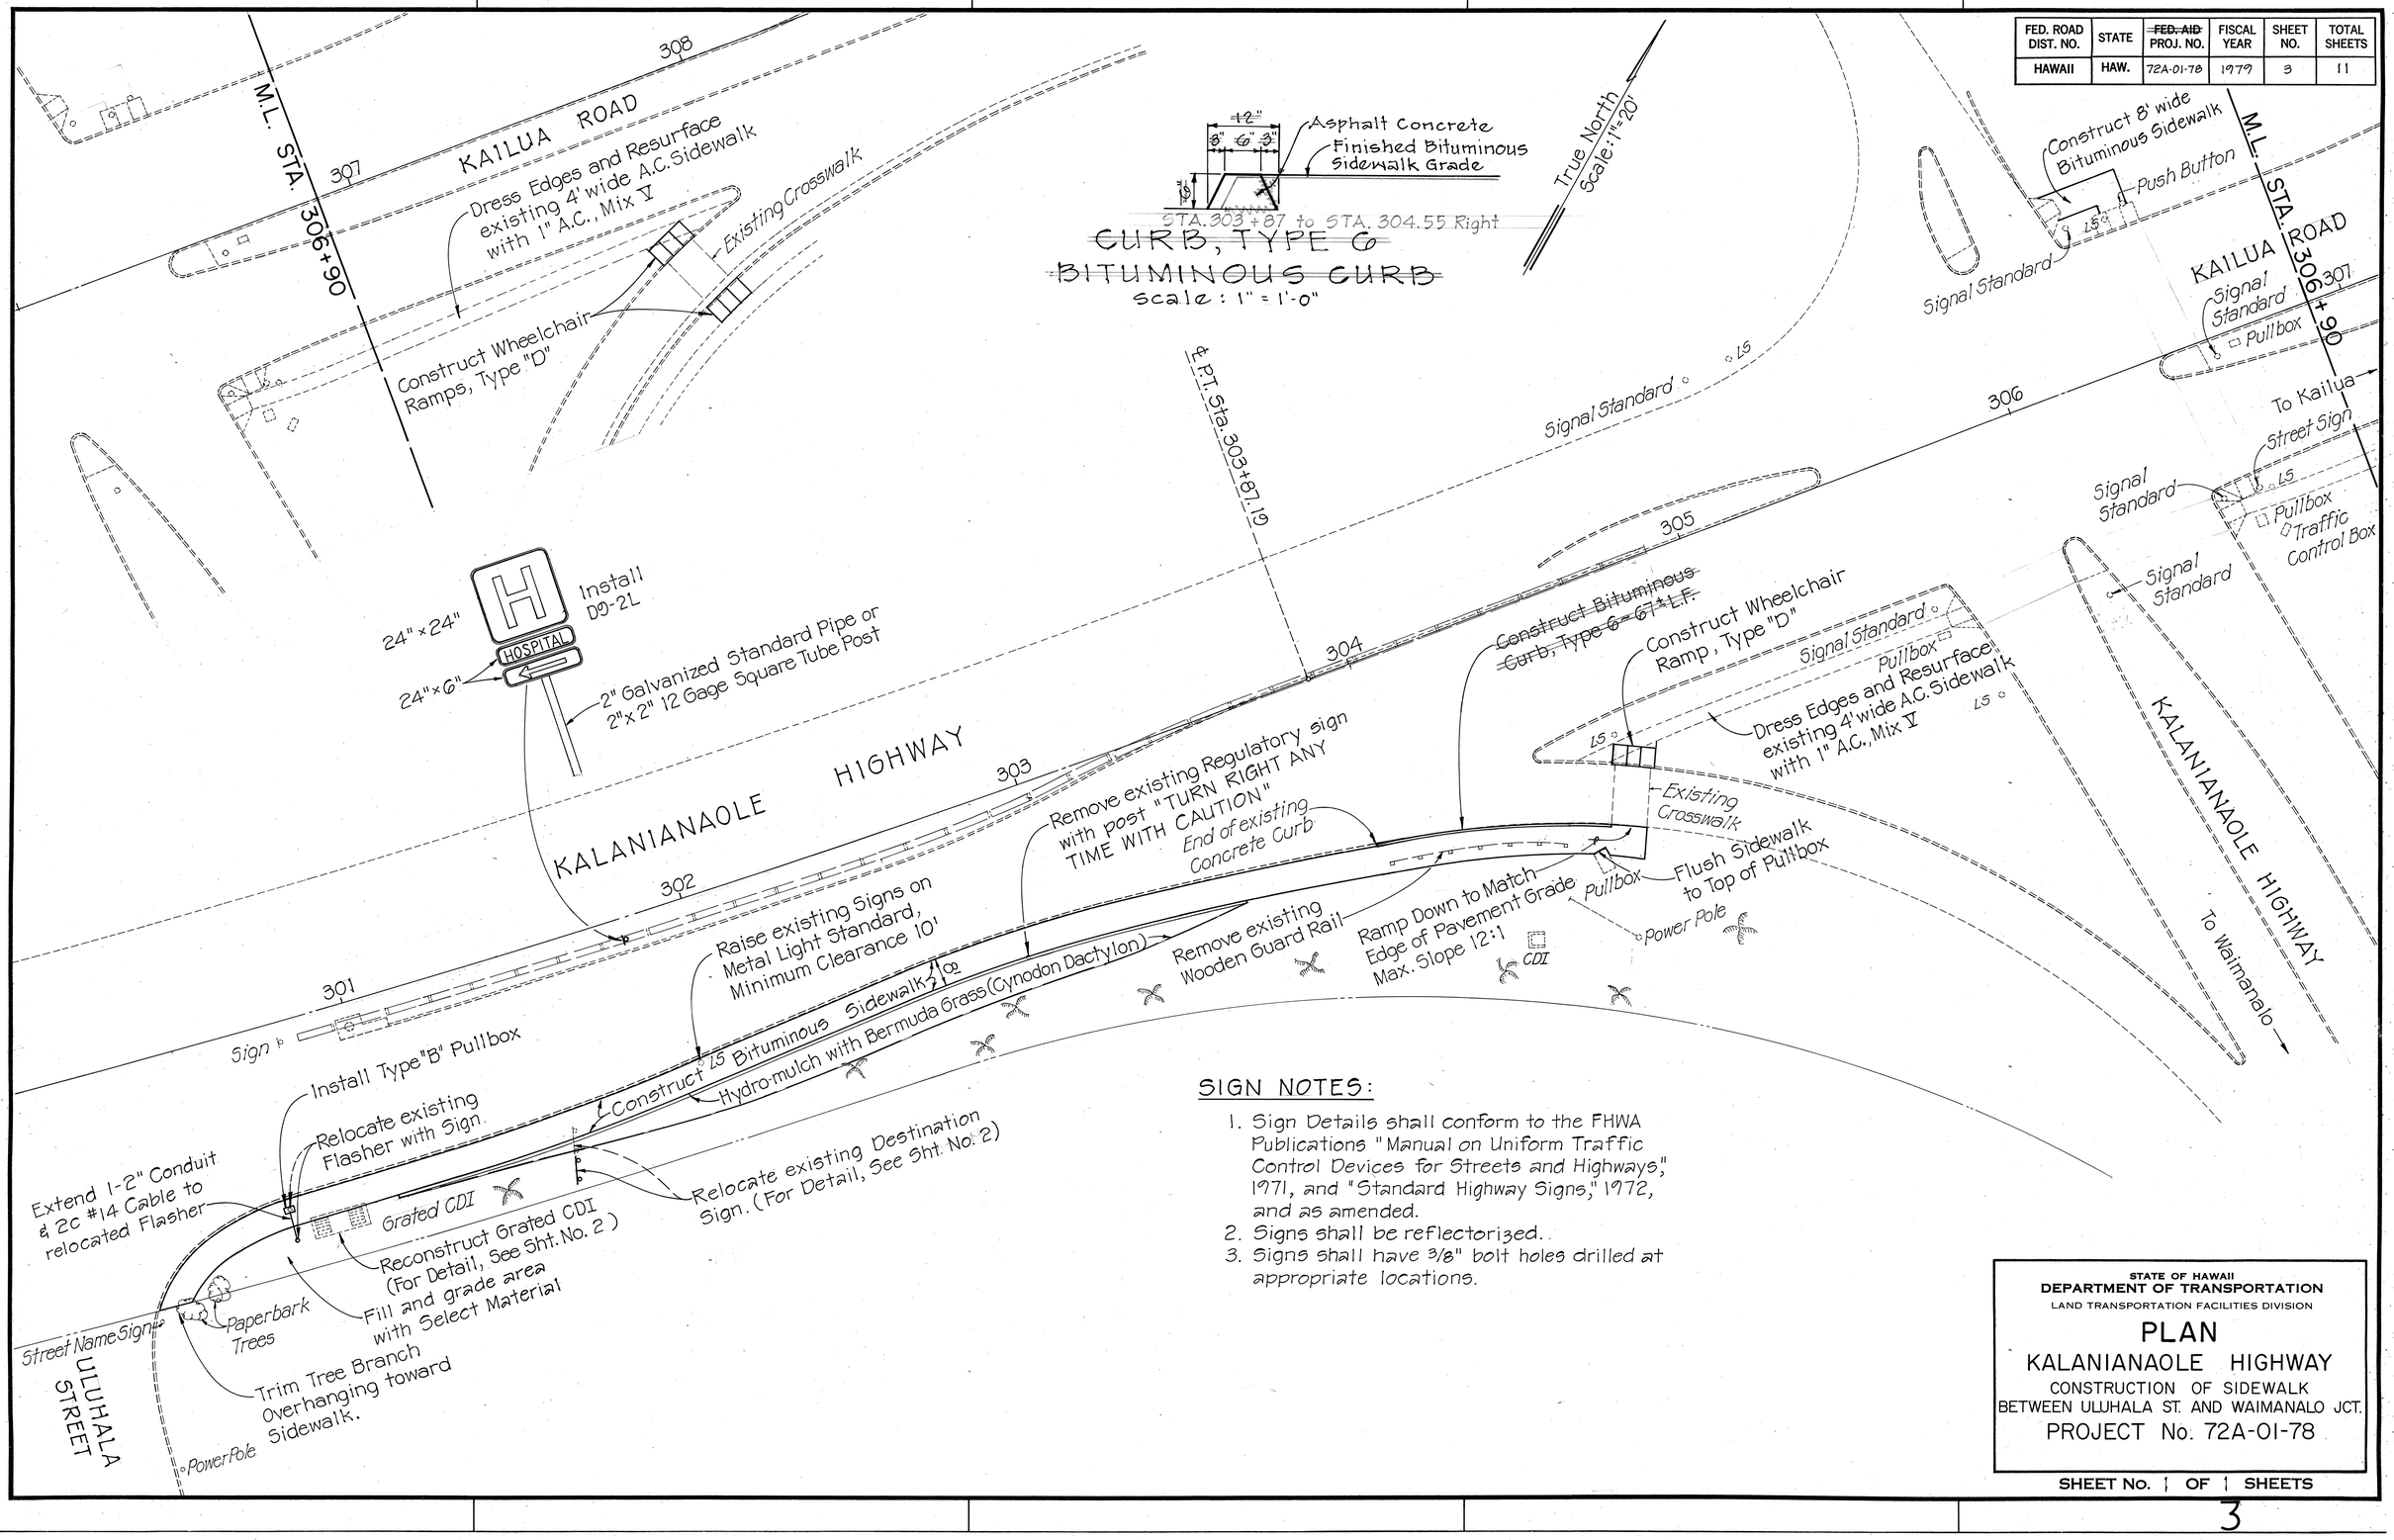

SIGN NOTES:

1. Sign Details shall conform to the FHWA Publications "Manual on Uniform Traffic Control Devices for Streets and Highways," 1971, and "Standard Highway Signs," 1972, and as amended.
2. Signs shall be reflectorized.
3. Signs shall have 3/8" bolt holes drilled at appropriate locations.

ORIGINAL PLAN	SURVEY PLOTTED BY	DATE
NOTE BOOK	DRAWN BY	"
No.	TRACED BY	"
	DESIGNED BY	"
	QUANTITIES BY	"
	CHECKED BY	"

STATE OF HAWAII
DEPARTMENT OF TRANSPORTATION
LAND TRANSPORTATION FACILITIES DIVISION

PLAN

KALANIANAOLE HIGHWAY

CONSTRUCTION OF SIDEWALK
BETWEEN ULUHALA ST. AND WAIMANALO JCT.
PROJECT No. 72A-01-78

SHEET No. 1 OF 1 SHEETS