FED. ROAD DIST. NO.	STATE	PROJ. NO.	FISCAL YEAR	SHEET NO.	TOTAL SHEETS
HAWAII	HAW.	HES-072-1(32)	1985	4	18

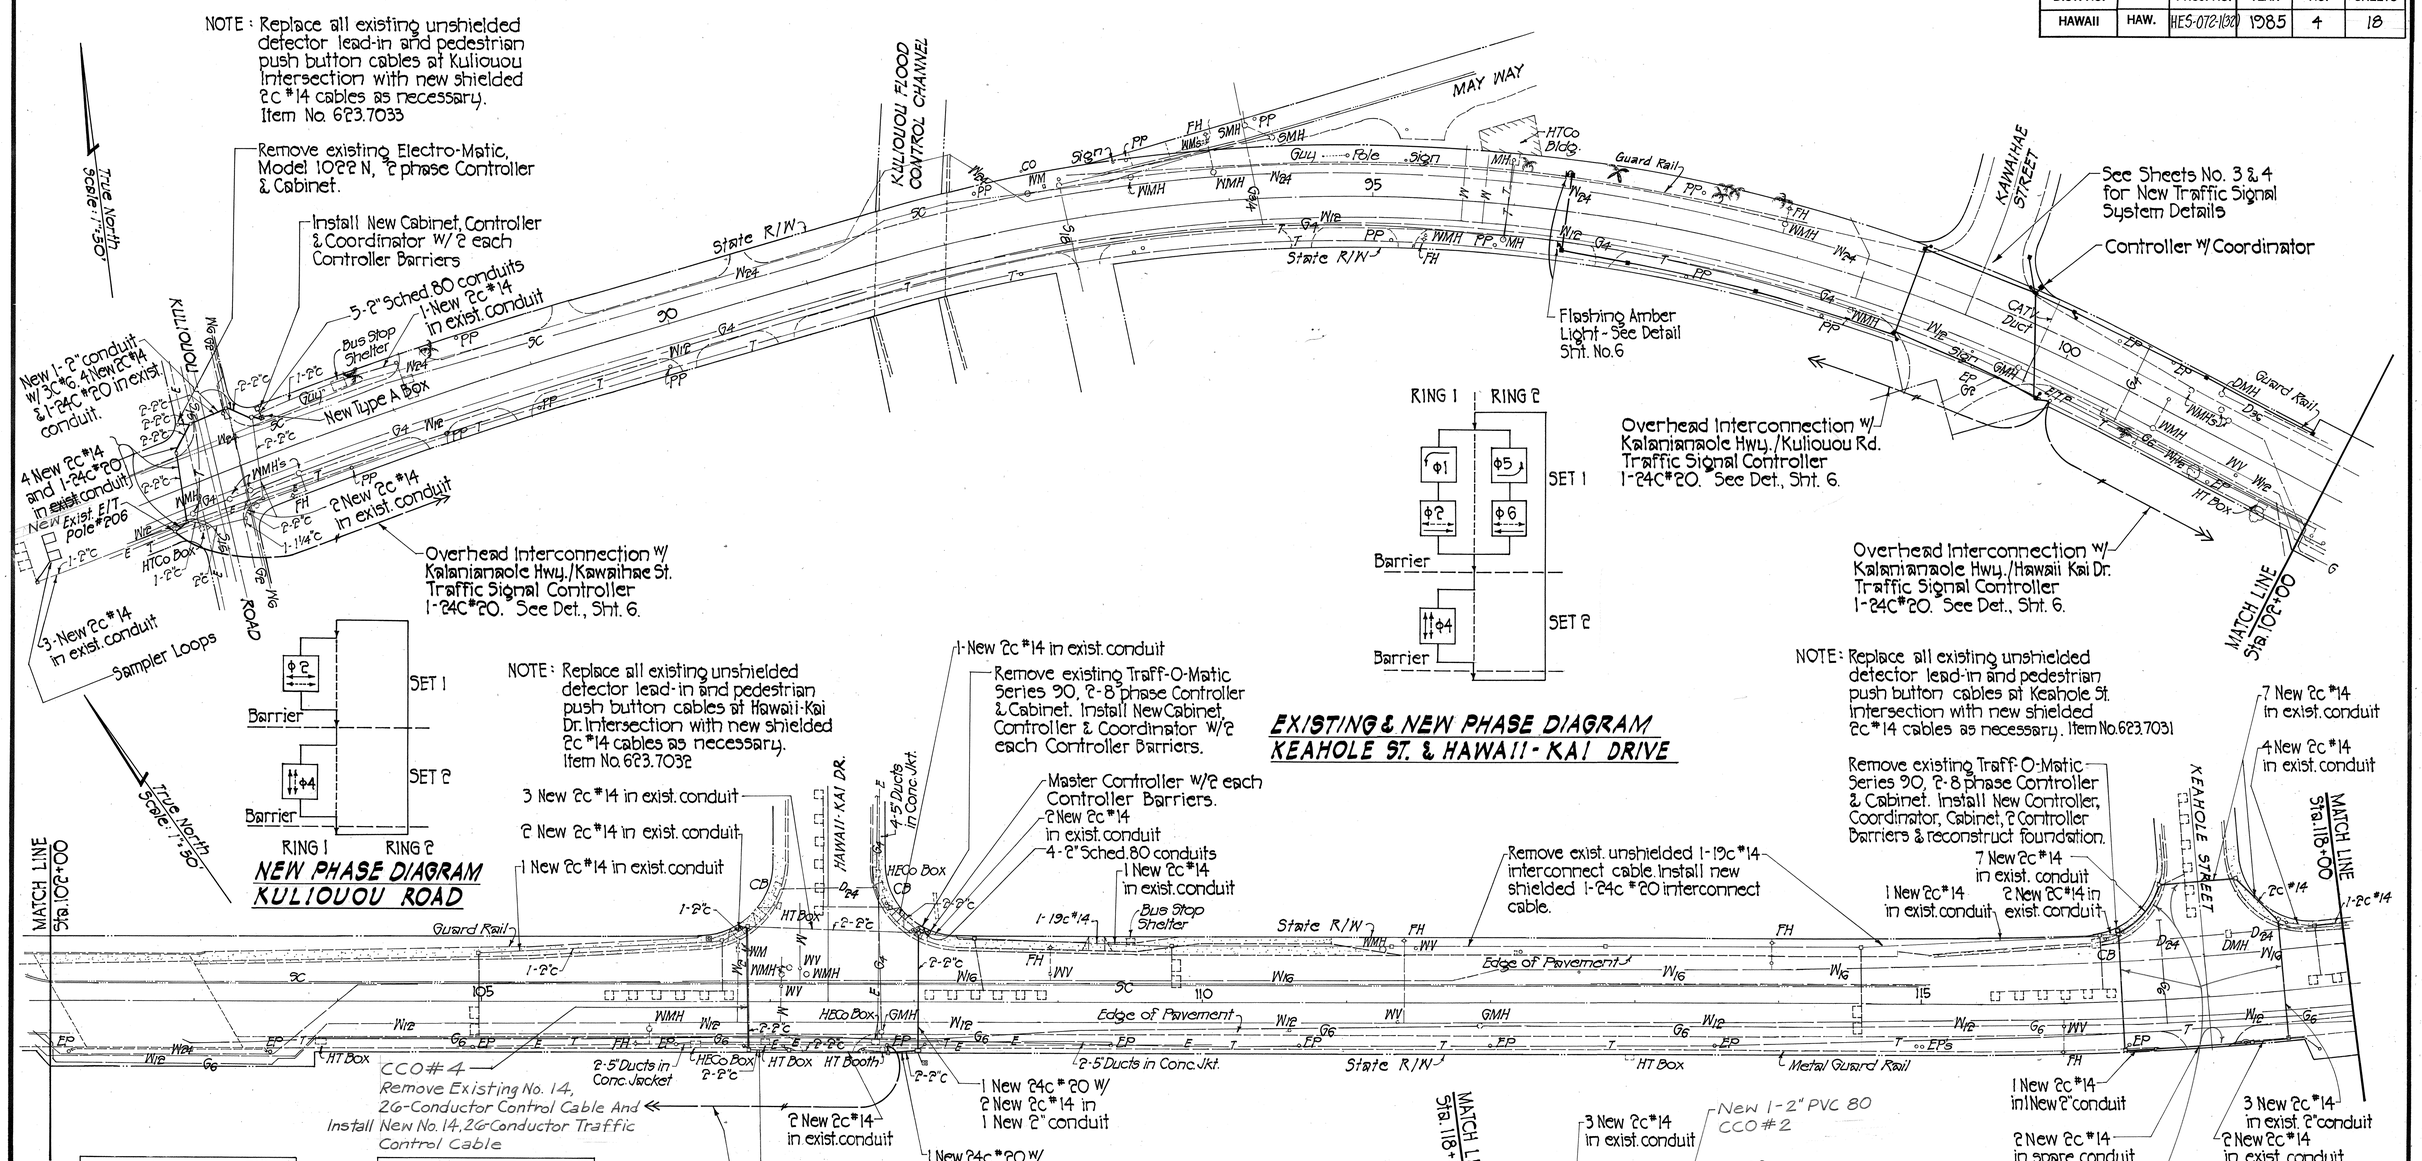

EXISTING & NEW PHASE DIAGRAM
KEAHOLE ST. & HAWAII-KAI DRIVE

NEW PHASE DIAGRAM
KULIOUOU ROAD

PLAN
Scale: 1" = 50'

EXISTING PHASE DIAGRAM - KULIOUOU ROAD

ORIGINAL PLAN		DATE
	SURVEY PLOTTED BY	
	DRAWN BY	
	TRACED BY	
	DESIGNED BY	
NOTE BOOK	QUANTITIES BY	
No.	CHECKED BY	

STATE OF HAWAII
DEPARTMENT OF TRANSPORTATION
HIGHWAYS DIVISION

TRAFFIC SIGNALS ON
KALANIANAOLE HWY. AT KAWAIHAE ST.

KALANIANAOLE HWY. TRAFFIC SIGNAL INTERCONNECTION - KULIOUOU RD. TO KEAHOLE STREET

PROJECT NO. HES-072-1(32)

SCALE: 1" = 50' DATE: Feb. 25, 1985

HAROLD I. YOSHIZAKI REGISTERED PROFESSIONAL ENGINEER No. 2091 HAWAII, U.S.A.

SHEET No. 4 OF 18 SHEETS

D-4-2