FED. ROAD DIST. NO.	STATE	PROJ. NO.	FISCAL YEAR	SHEET NO.	TOTAL SHEETS
HAWAII	HAW.	HWY-0-03-87	1987	1	13

INDEX TO DRAWINGS

SHEET NO.	DESCRIPTION
1	TITLE SHEET
2	LAYOUT PLAN & GENERAL NOTES
3	STANDARD PLANS SUMMARY
4-13	PLANS

STATE OF HAWAII

DEPARTMENT OF TRANSPORTATION

HIGHWAYS DIVISION

HONOLULU, HAWAII

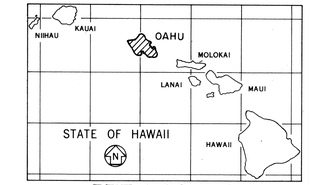

RTE. NOS.
63
65
72
83

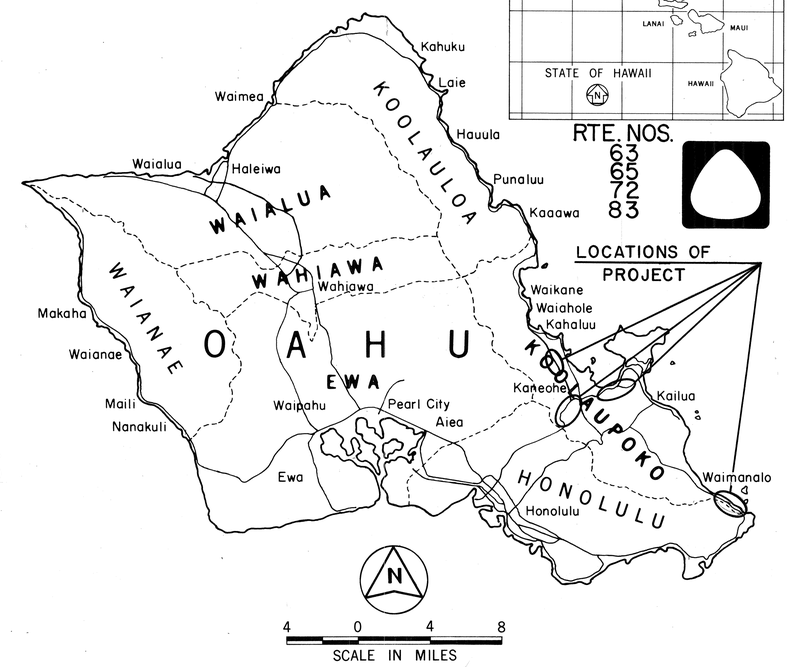

"AS-BUILT"

PLANS FOR

GUARDRAIL AND SHOULDER IMPROVEMENTS AT VARIOUS LOCATIONS ON OAHU

PROJECT NO. HWY-0-03-87

DISTRICT OF KOOLAUPOKO

ISLAND OF OAHU

CHANGES MADE DURING CONSTRUCTION HAVE BEEN INCORPORATED ON THESE PLANS EXCEPT CHANGES IN THE ORIGINAL THEORETICAL QUANTITIES. FOR ACTUAL QUANTITIES, REFER TO PROJECT LEDGER AND/OR COMPUTATION BOOK.

Arthur J. Sibbs 3/13/89
RESIDENT ENGINEER DATE

DEPARTMENT OF TRANSPORTATION
STATE OF HAWAII

APPROVED:

Cheryl D. Soon 1/24/89
DIR. OF TRANSPORTATION DATE

ALLAN T. NISHIMURA 548-7490 OCT., 1986
DESIGNED BY P. S. & E. BY PHONE DATE