FED. ROAD DIST. NO.	STATE	PROJ. NO.	FISCAL YEAR	SHEET NO.	TOTAL SHEETS
HAWAII	HAW.	72B-01-13M	2013	1	34

INDEX TO DRAWINGS

SHEET NO.	DESCRIPTION
1	TITLE SHEET
2	STANDARD PLAN SUMMARY
3	EXISTING BRIDGE PHOTOS
4 - 6	GENERAL NOTES, WATER POLLUTION AND EROSION CONTROL NOTES
7	STRUCTURAL NOTES
1 8	SITE PLAN & PROFILE
2 9 - 10	PLANS - CONCRETE REPAIRS
3 11	ELEVATIONS - CONCRETE REPAIRS
12	LONGITUDINAL SECTIONS - CONCRETE REPAIRS
13 - 16	BENT ELEVATIONS - CONCRETE REPAIRS 4 5 6
7 17	SPALL REPAIR SCHEDULES
18 - 21	CONCRETE COLUMN, BEAMS & CURB REPAIR DETAILS
22	CONSTRUCTION PHASING NOTES
23	FIBERWRAP GENERAL NOTES
24 - 28	FIBERWRAP DETAILS
29	PAINTING NOTES
30	REFERENCE DRAWING
31 - 34	TRAFFIC CONTROL PLANS

Sheet Nos. 1 ADD. 8S-1 to S-3; 2 9S-1 to S-3; 3 11S-1 to S-3; 4 13S-1; 5 14S-1; 6 15S-1; 16S-1 and 7 17S-1 to S-10 are Supplementary Sheets to this project. Total sheet count after "AS-BUILT" posting 57 shts.

STATE OF HAWAII

DEPARTMENT OF TRANSPORTATION

HIGHWAYS DIVISION

HONOLULU, HAWAII

"AS-BUILT"

PLANS FOR

KALANIANAOLE HIGHWAY

EMERGENCY REPAIRS OF IHIIHILAUAKEA BRIDGE

PROJECT NO. 72B-01-13M

DISTRICT OF HONOLULU

ISLAND OF OAHU

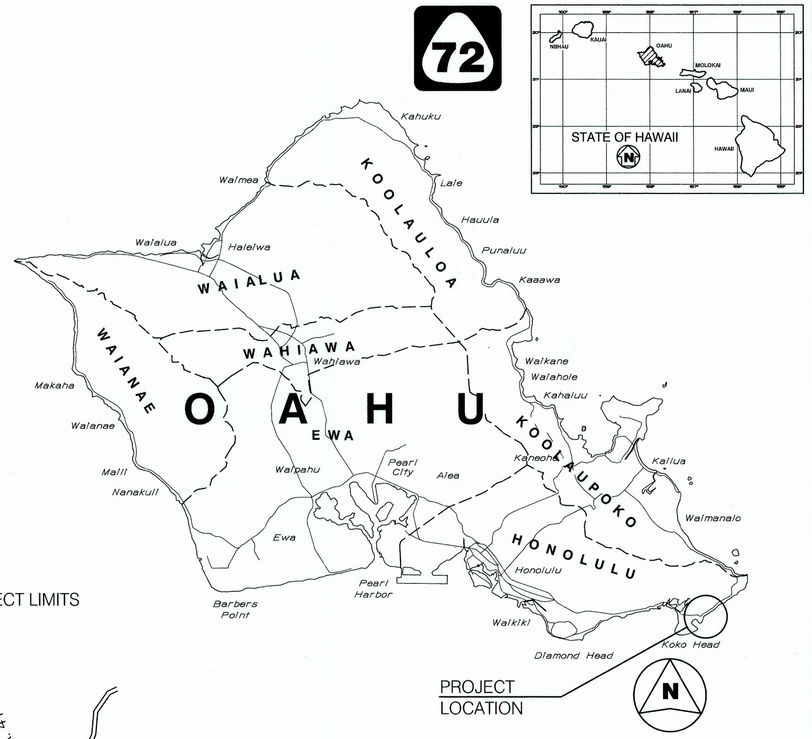

PROJECT LOCATION

SCALE IN MILES

MILE POST 11.65 TO MILE POST 11.66

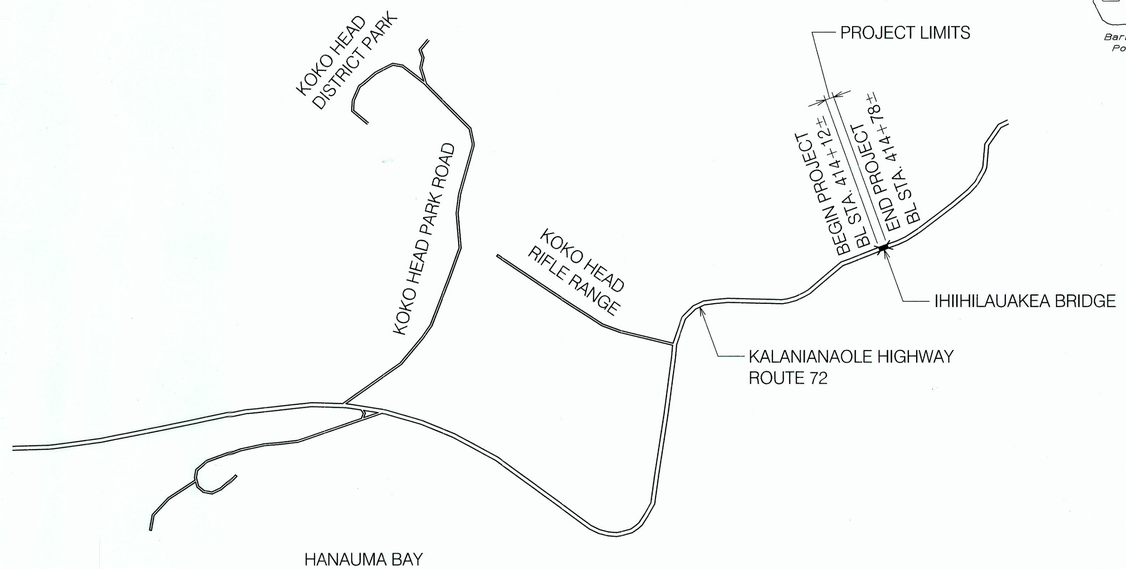

LAYOUT PLAN

NOT TO SCALE

LENGTH OF PROJECT 0.01 MILES

CHANGES MADE DURING CONSTRUCTION HAVE BEEN INCORPORATED ON THESE PLANS EXCEPT CHANGES IN THE ORIGINAL THEORETICAL QUANTITIES. FOR ACTUAL QUANTITIES, REFER TO PROJECT LEDGER AND/OR COMPUTATION BOOK.

RESIDENT ENGINEER 2/5/2016 DATE

DEPARTMENT OF TRANSPORTATION
STATE OF HAWAII

APPROVED:

for DIR. OF TRANSPORTATION 1/23/13 DATE

NAGAMINE OKAWA ENGINEERS INC. DESIGNED BY | HWY-DD MANAGED BY | 692-7581 PHONE | JAN 2013 DATE