84732

FED. ROAD DIST. NO.	STATE	FED. AID PROJ. NO.	FISCAL YEAR	SHEET NO.	TOTAL SHEETS
HAWAII	HAW.	STP-072-1(88)	1993	206	340

ASPHALT CONCRETE PAVEMENT

PORTLAND CEMENT CONCRETE PAVEMENT

ASPHALT BASE COURSE

AGGREGATE SUBBASE COURSE

EXISTING GROUND (GND)

E.P. EXISTING EDGE OF PAVEMENT (SHOULDER)

6.20 FINISH PAVEMENT ELEVATION

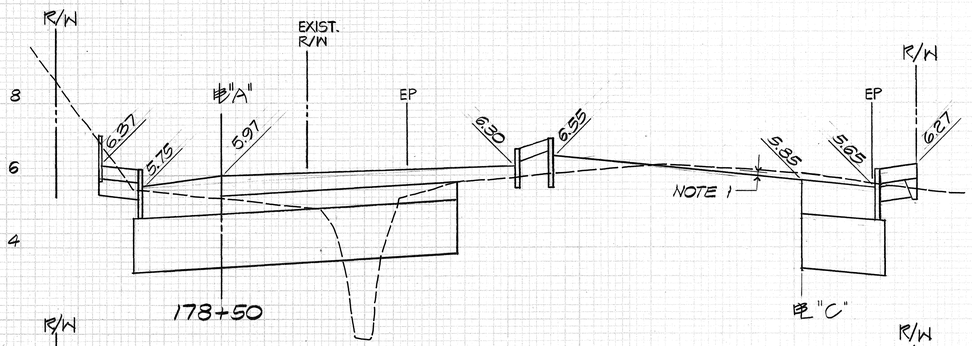

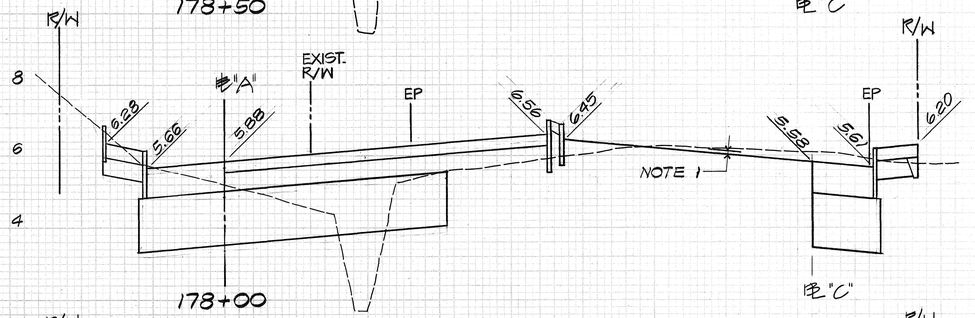

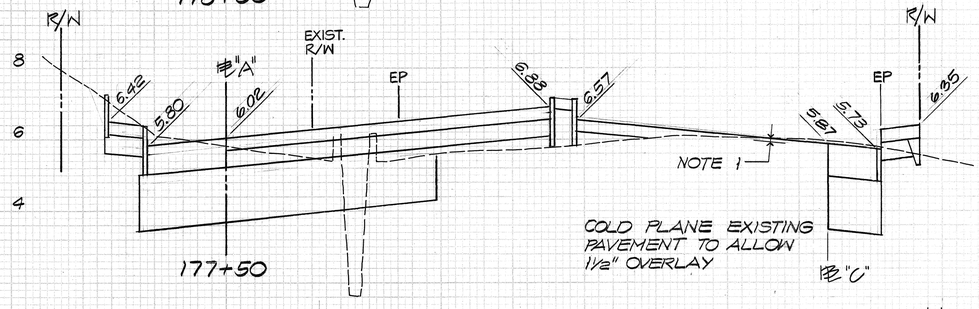

COLD PLANE EXISTING PAVEMENT TO ALLOW 1½" OVERLAY

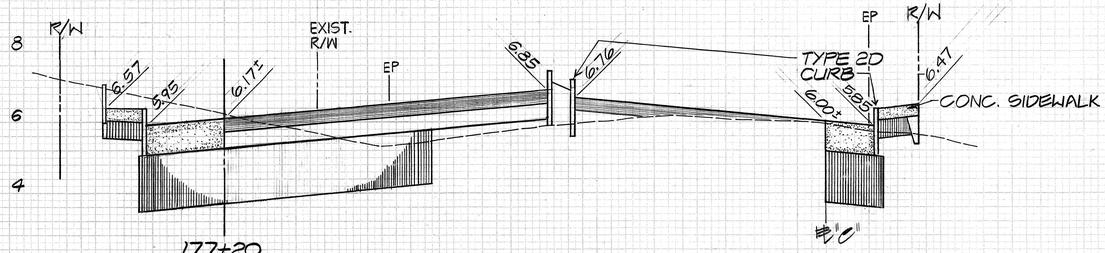

SCALES: HORIZ. 1" = 10'
VERT. 1" = 2'

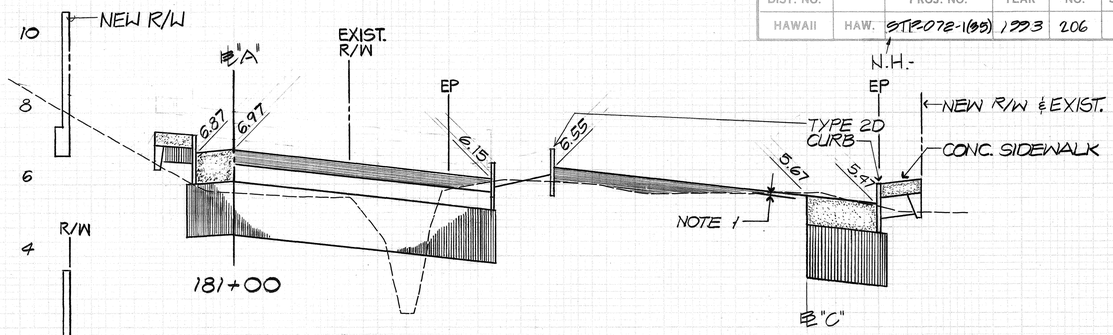

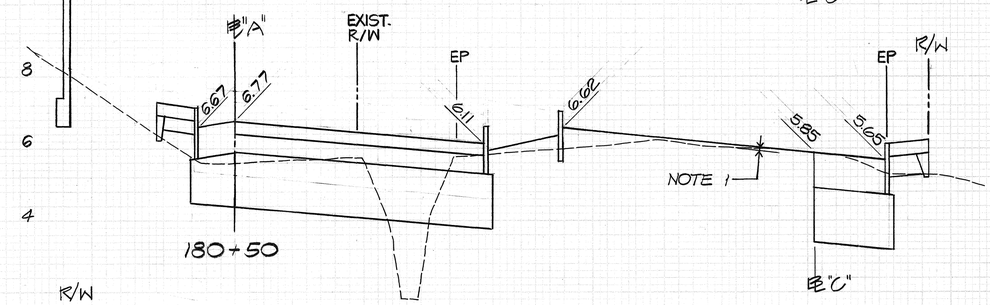

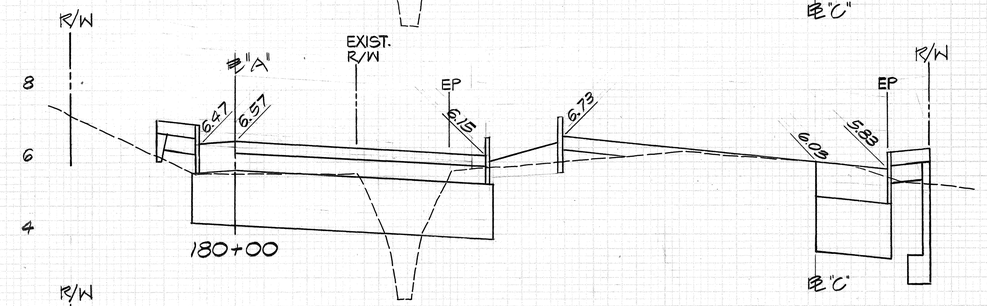

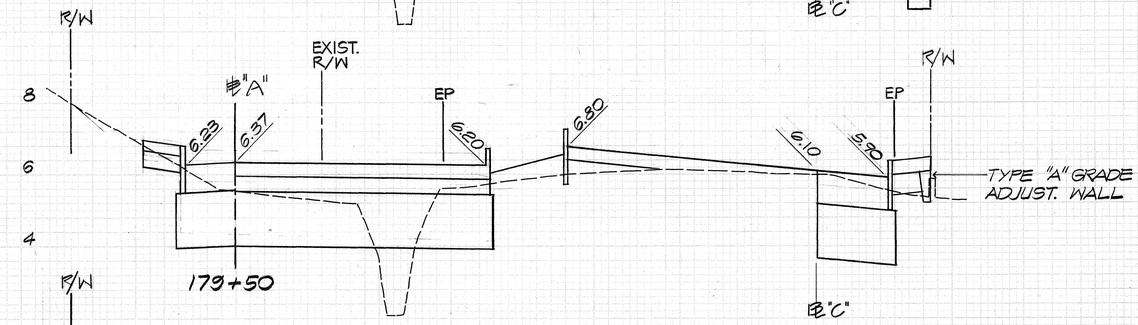

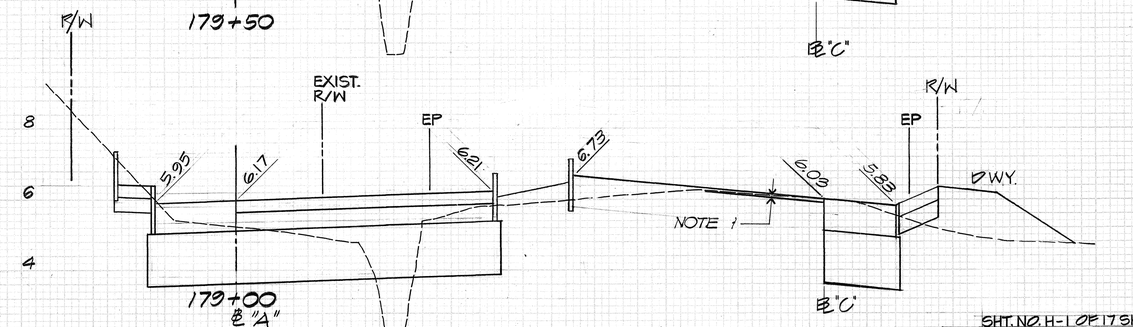

20 0 20 40 60 80 100

SHT. NO. H-1 OF 17 SHTS.

206

FINAL SURVEY — SURVEYED, PLOTTED, TEMPLATE, AREAS, AREAS CHECKED, NOTE BOOK, NO., BY, DATE

ORIGINAL SURVEY — SURVEYED, PLOTTED, TEMPLATE, AREAS, AREAS CHECKED, NOTE BOOK, NO., BY, DATE

FED. ROAD DIST. NO.	STATE	FED. AID PROJ. NO.	FISCAL YEAR	SHEET NO.	TOTAL SHEETS
HAWAII	HAW.	STP 078-1(88)	1993	207	340

FINAL SURVEY — NO. | NOTE BOOK | SURVEYED | REVISED | TEMPLATE | AREAS | AREAS CHECKED | BY | DATE

ORIGINAL SURVEY — NO. | NOTE BOOK | SURVEYED | REVISED | TEMPLATE | AREAS | AREAS CHECKED

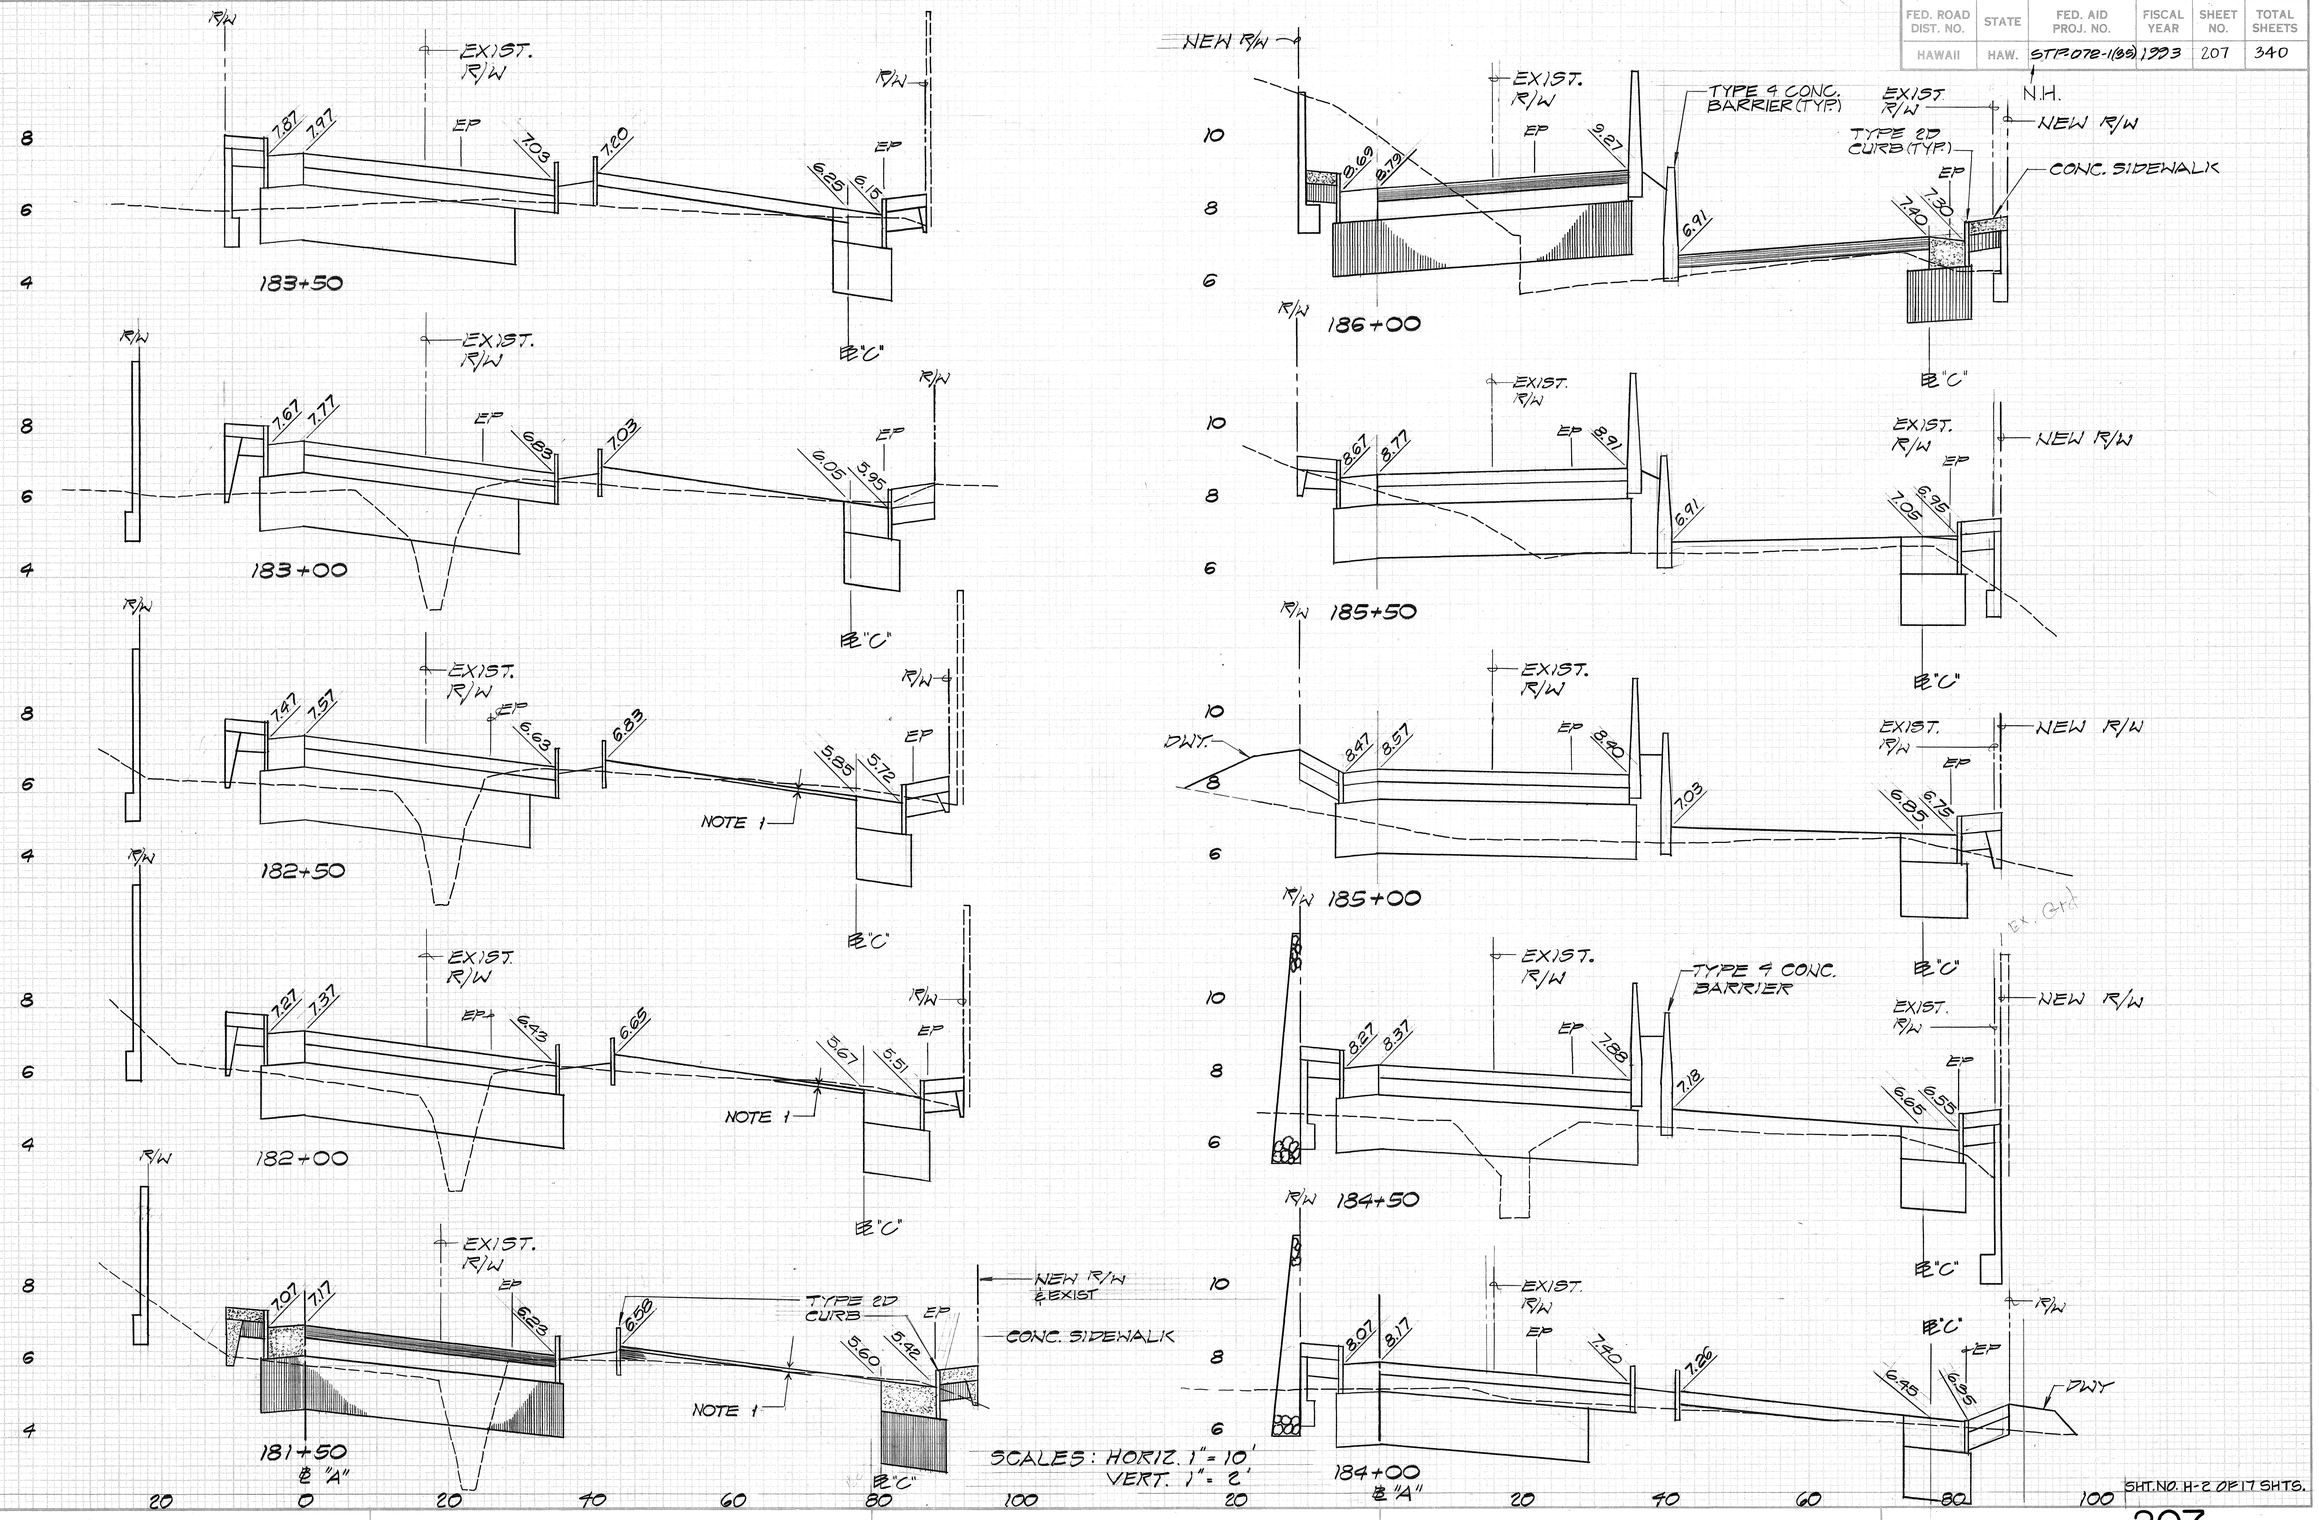

SHT. NO. H-2 OF 17 SHTS.

84732

FED. ROAD DIST. NO.	STATE	FED. AID PROJ. NO.	FISCAL YEAR	SHEET NO.	TOTAL SHEETS
HAWAII	HAW.	STP 072-1(88)	1993	208	340

ORIGINAL SURVEY	SURVEYED	BY	DATE
	PLOTTED		
NOTE BOOK	TEMPLATE		
NO.	AREAS		
	AREAS CHECKED		

FINAL SURVEY	SURVEYED	BY	DATE
	PLOTTED		
NOTE BOOK	TEMPLATE		
NO.	AREAS		
	AREAS CHECKED		

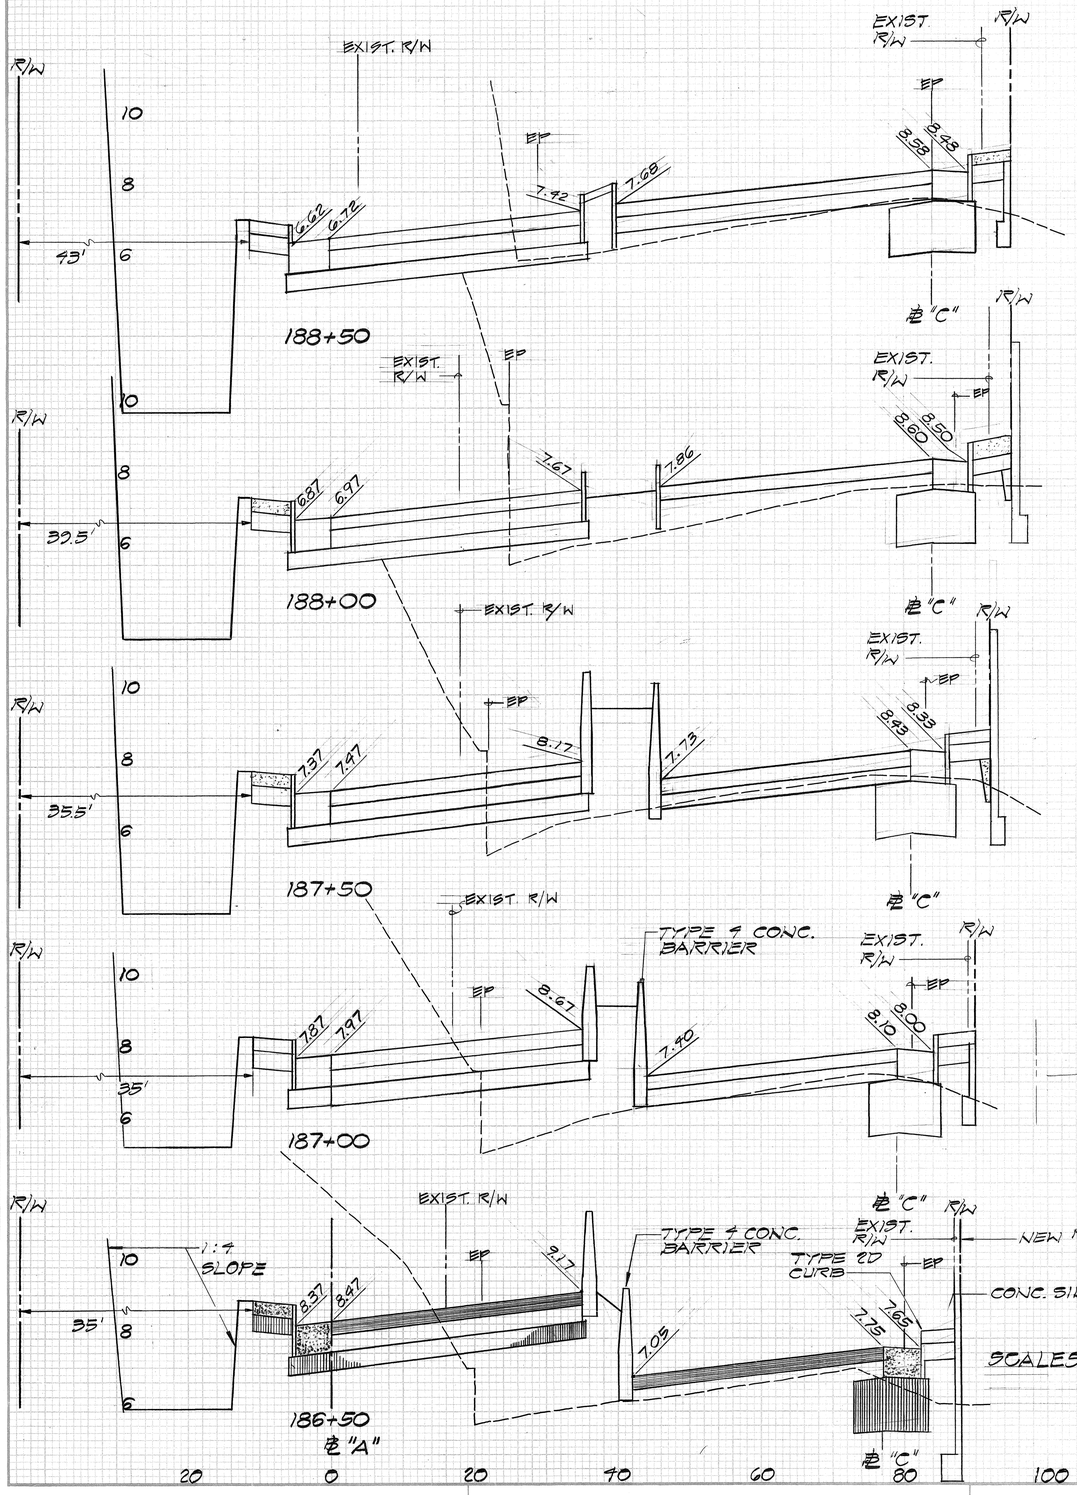

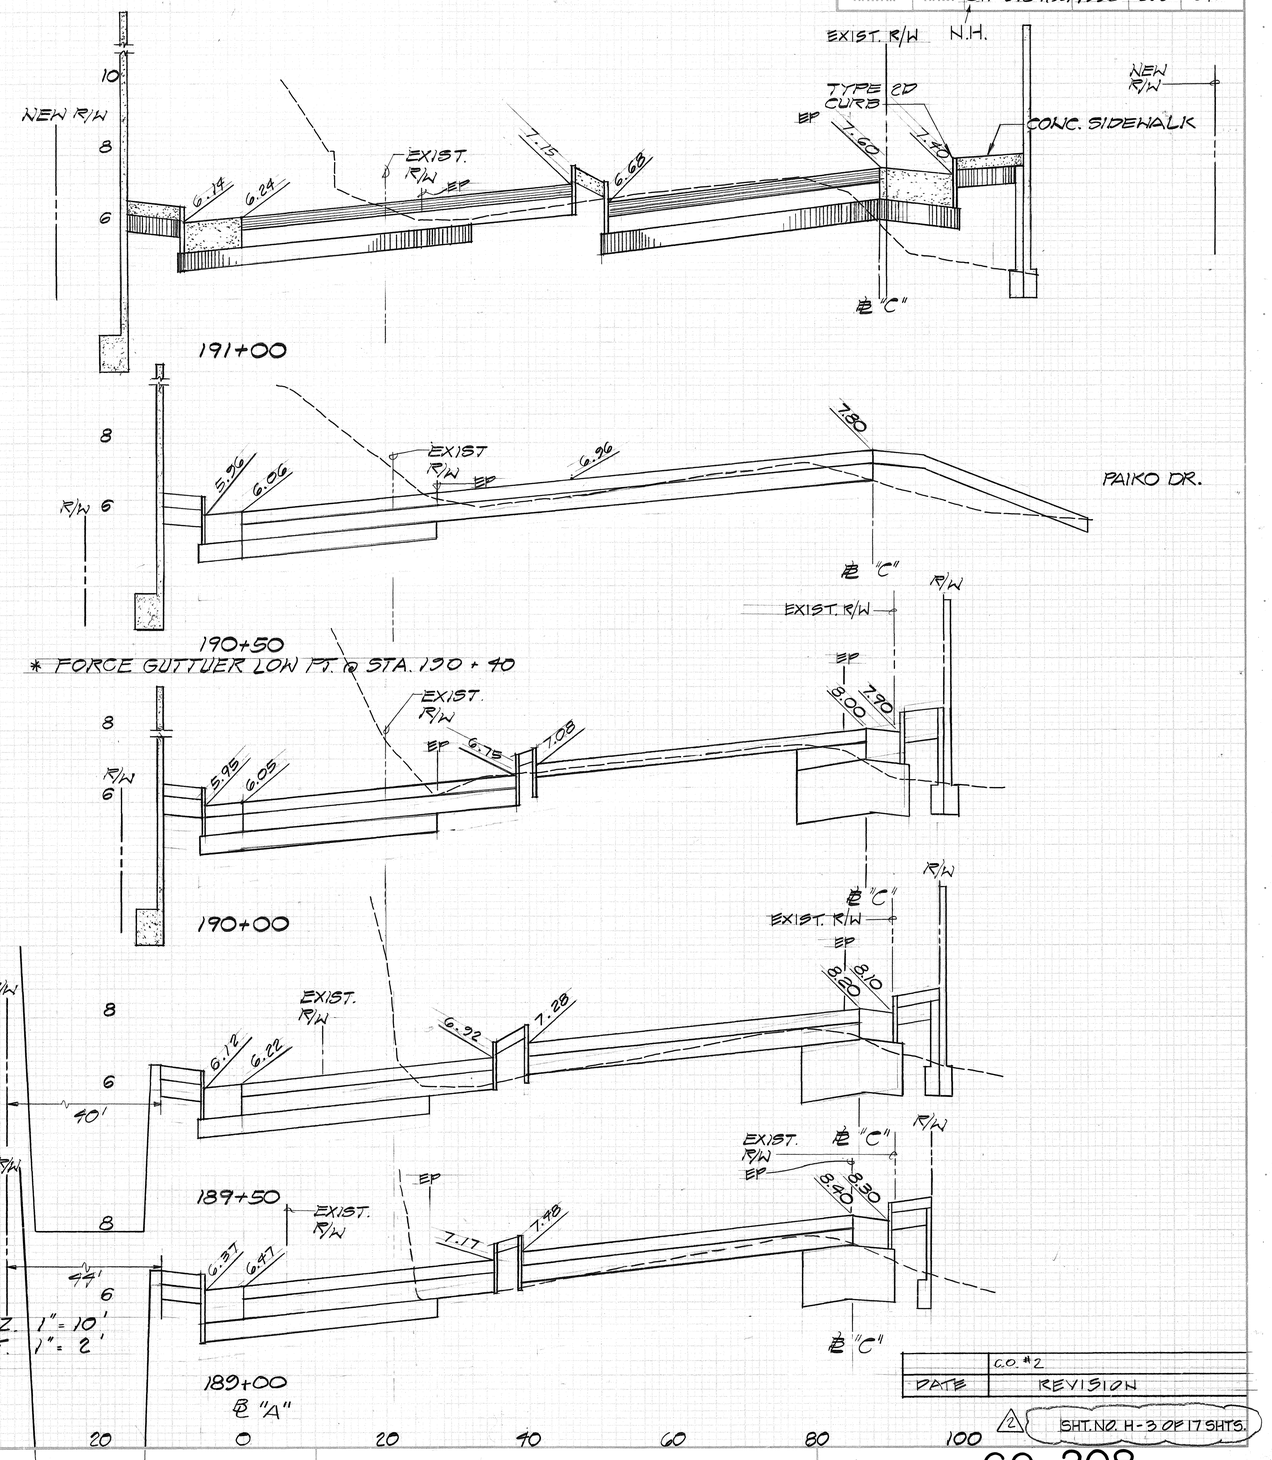

	C.O. #2
DATE	REVISION

2 SHT. NO. H-3 OF 17 SHTS.

C.O. 208

FED. ROAD DIST. NO.	STATE	FED. AID PROJ. NO.	FISCAL YEAR	SHEET NO.	TOTAL SHEETS
HAWAII	HAW.	STR078-1(35)	1993	209	340

FINAL SURVEY — NO. | NOTE BOOK | AREAS | TEMPLATE | SURVEYED | PLOTTED | BY | DATE | AREAS CHECKED

ORIGINAL SURVEY — NO. | NOTE BOOK | AREAS | TEMPLATE | SURVEYED | PLOTTED | BY | DATE | AREAS CHECKED

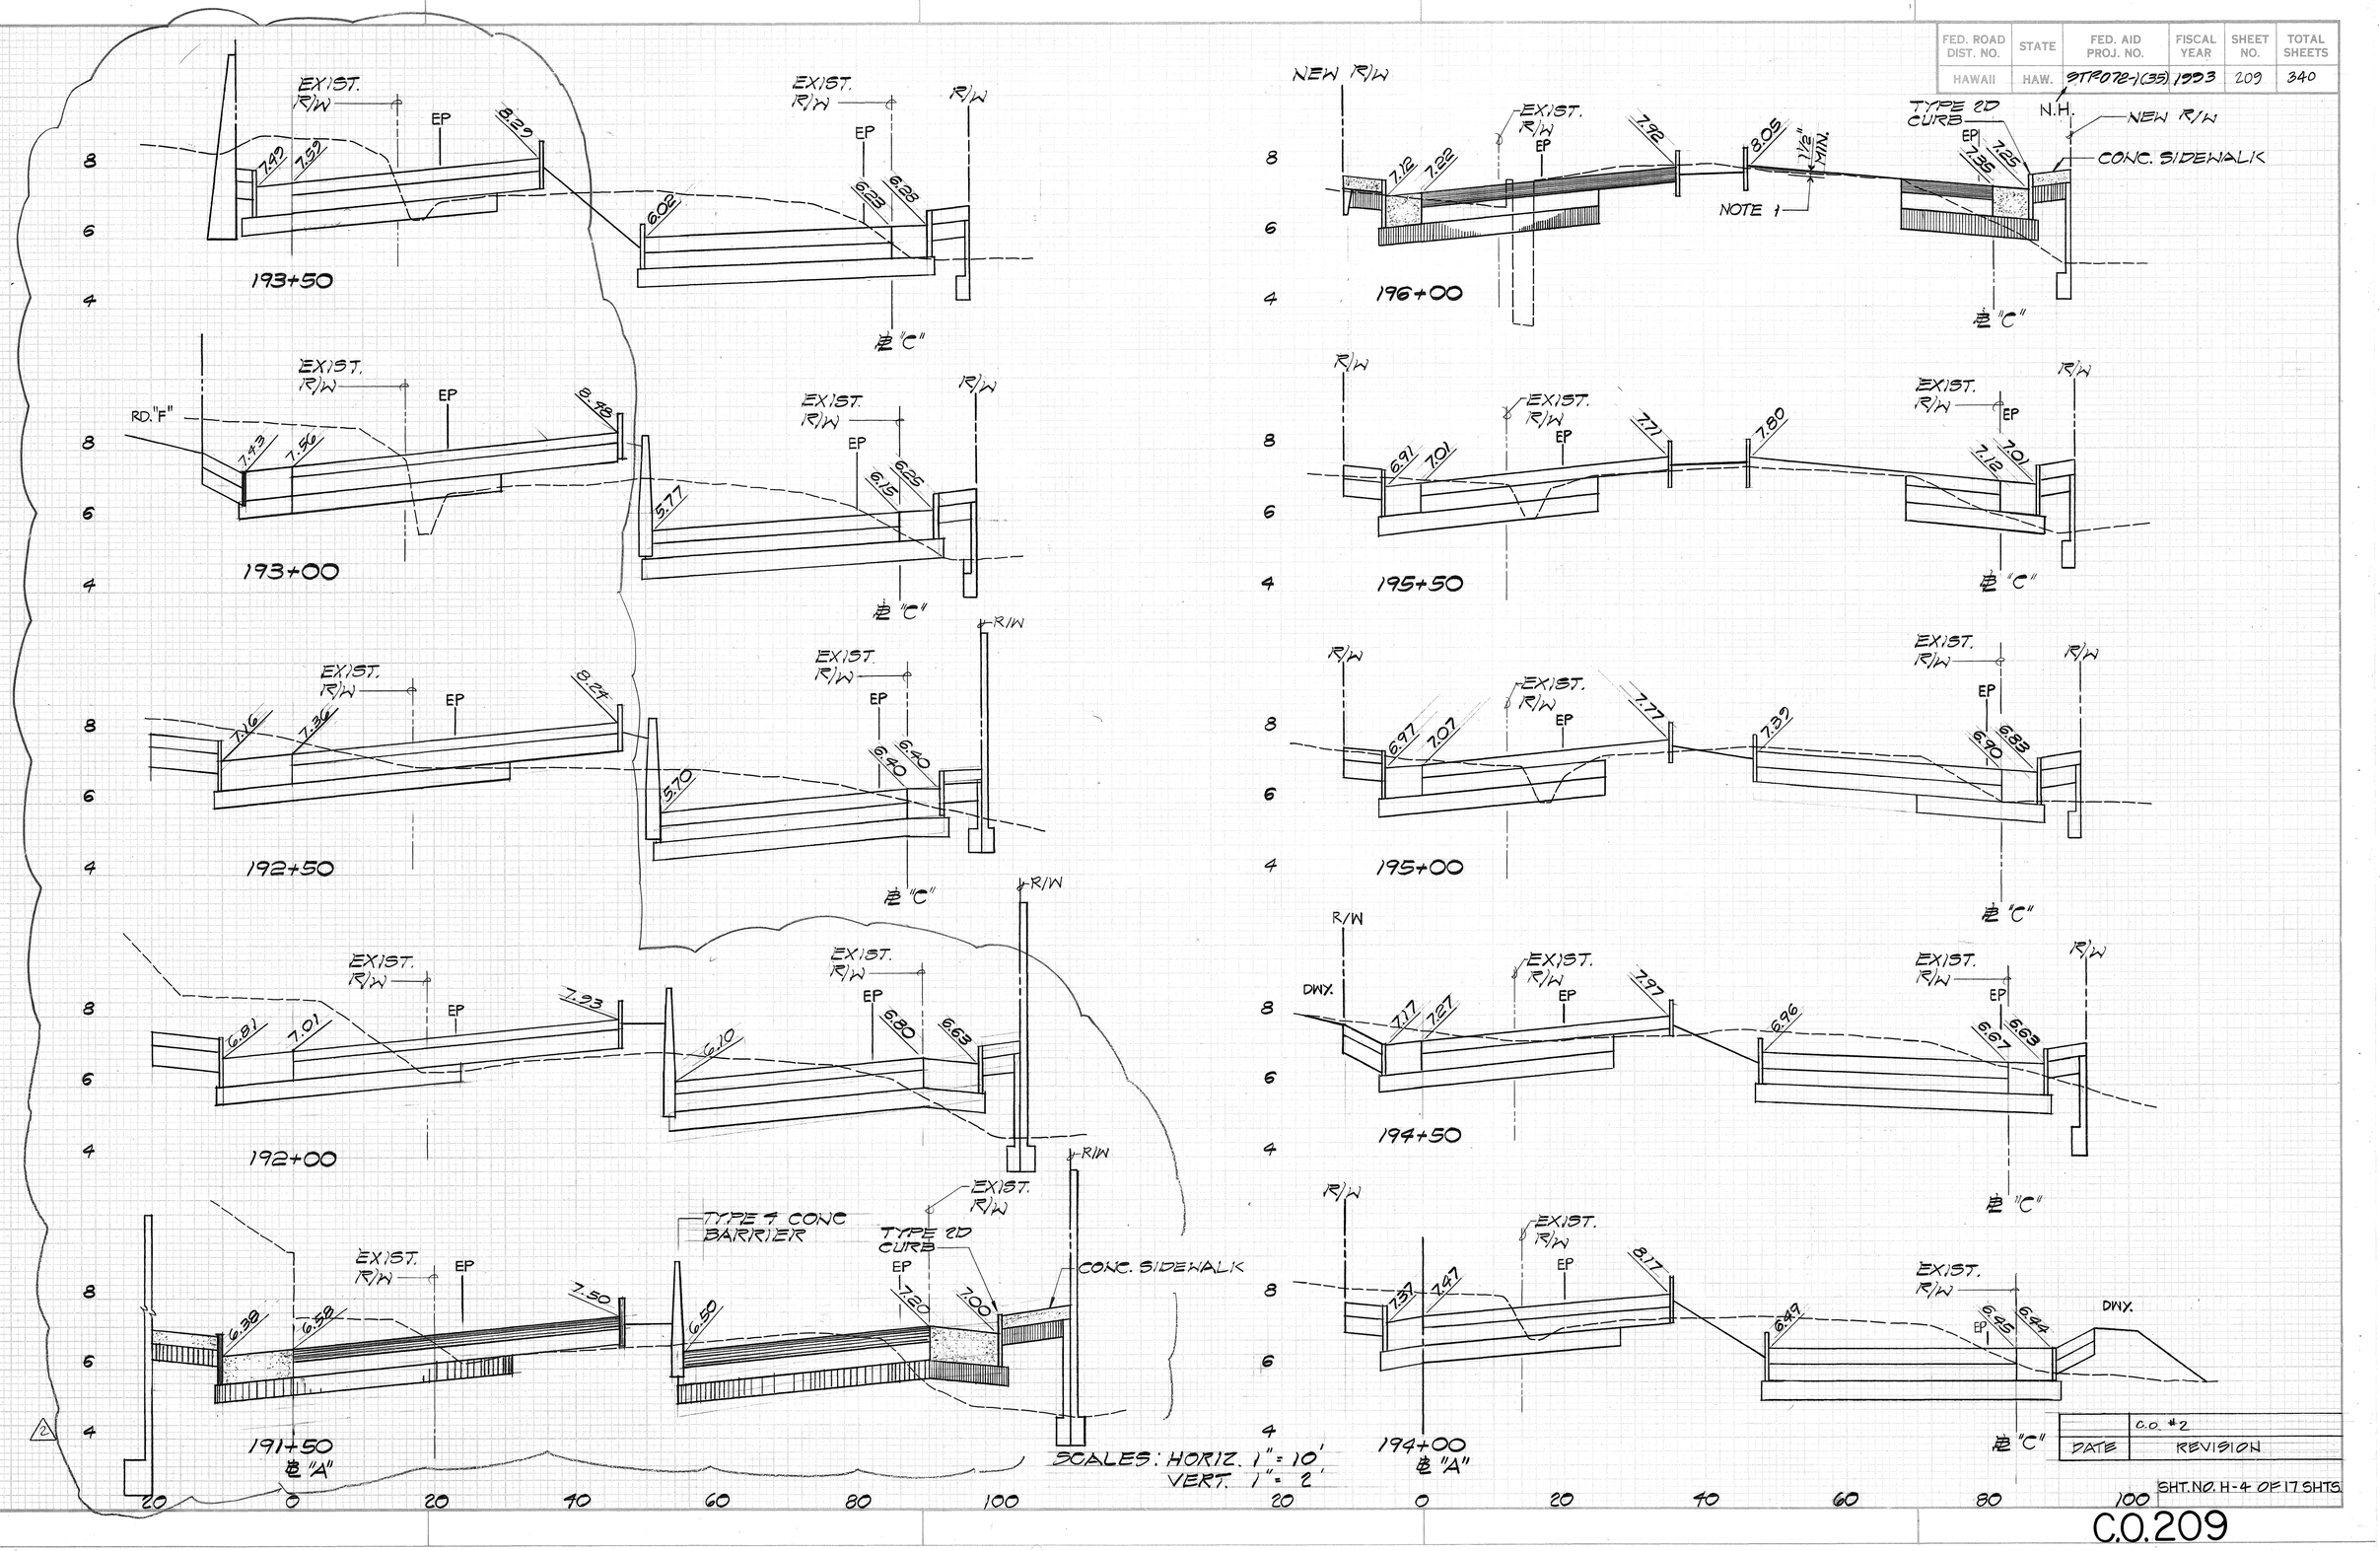

SCALES: HORIZ. 1" = 10'
VERT. 1" = 2'

C.O. # 2	
DATE	REVISION

SHT. NO. H-4 OF 17 SHTS.

C.O. 209

FED. ROAD DIST. NO.	STATE	FED. AID PROJ. NO.	FISCAL YEAR	SHEET NO.	TOTAL SHEETS
HAWAII	HAW.	STR072-1(35)	1993	210	340

ORIGINAL SURVEY	FINAL SURVEY
SURVEYED	SURVEYED
PLOTTED	PLOTTED
NOTE BOOK	TEMPLATE
NO.	AREAS
	AREAS CHECKED
BY	
DATE	

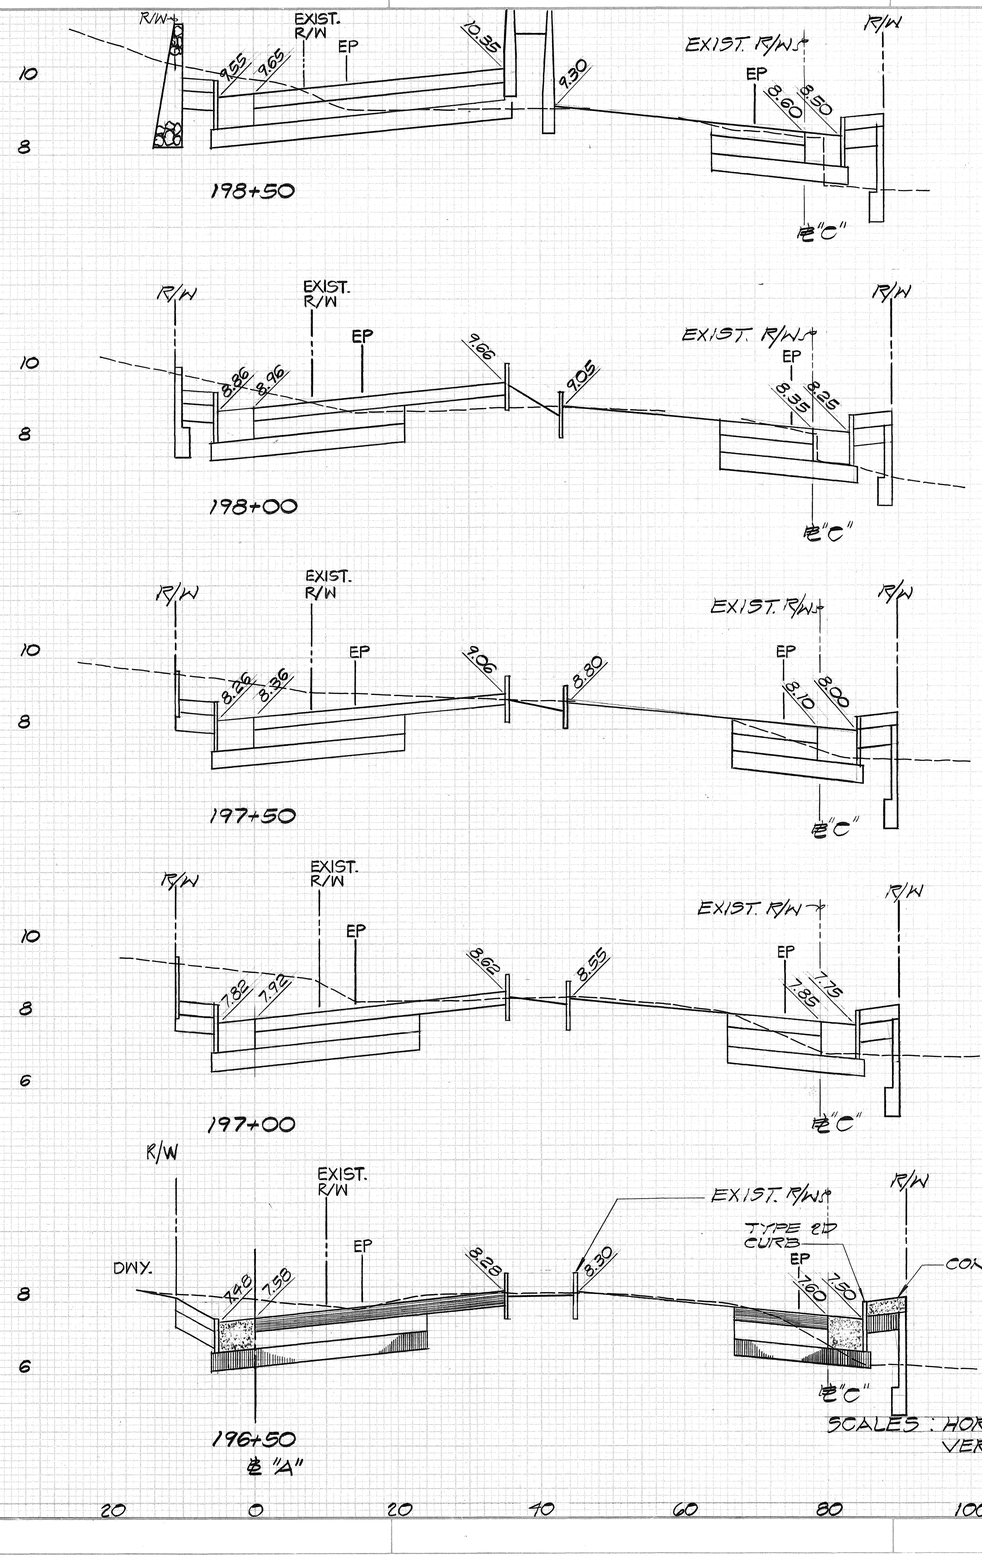

SCALES: HORIZ. 1" = 10'
VERT. 1" = 2'

84732

FED. ROAD DIST. NO.	STATE	FED. AID PROJ. NO.	FISCAL YEAR	SHEET NO.	TOTAL SHEETS
HAWAII	HAW.	STP-072-(35)	1993	211	340

N.H.

FINAL SURVEY	SURVEYED	BY	DATE
	PLOTTED		
NOTE BOOK	TEMPLATE		
NO.	AREAS		
	AREAS CHECKED		

ORIGINAL SURVEY	SURVEYED	BY	DATE
	PLOTTED		
NOTE BOOK	TEMPLATE		
NO.	AREAS		
	AREAS CHECKED		

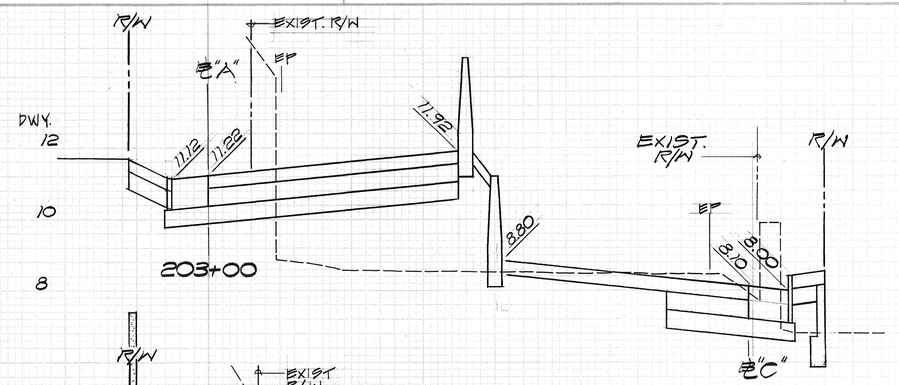

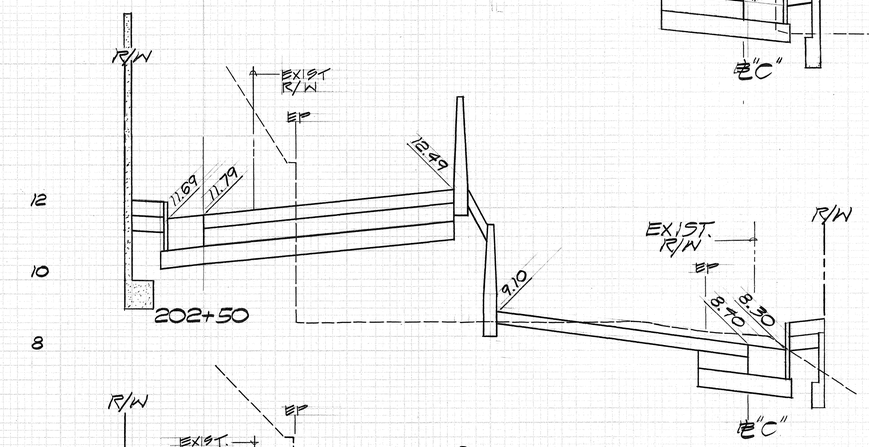

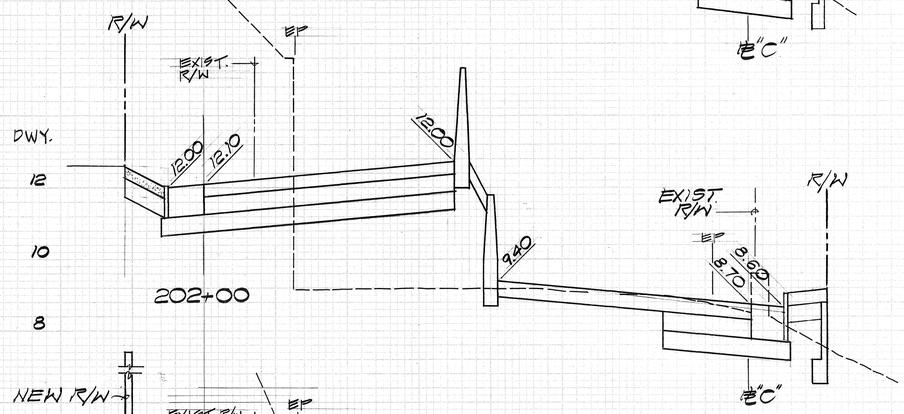

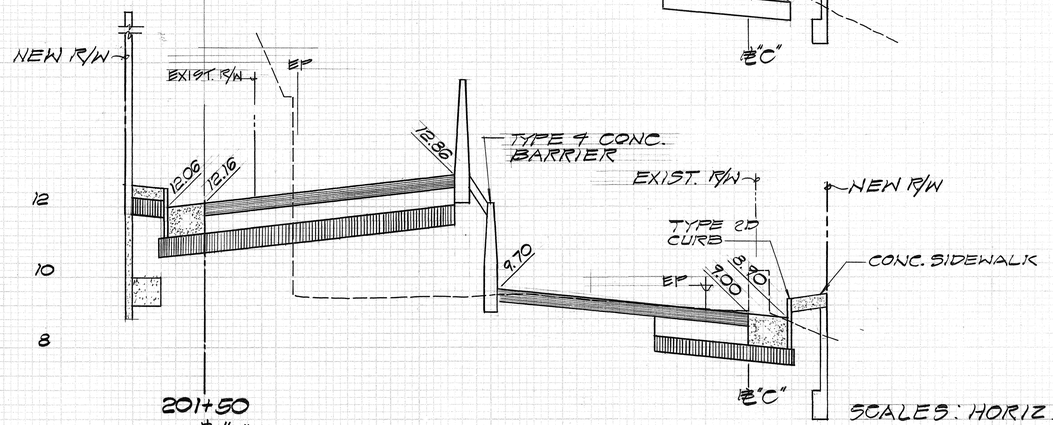

SCALES: HORIZ. 1" = 10'
VERT. 1" = 2'

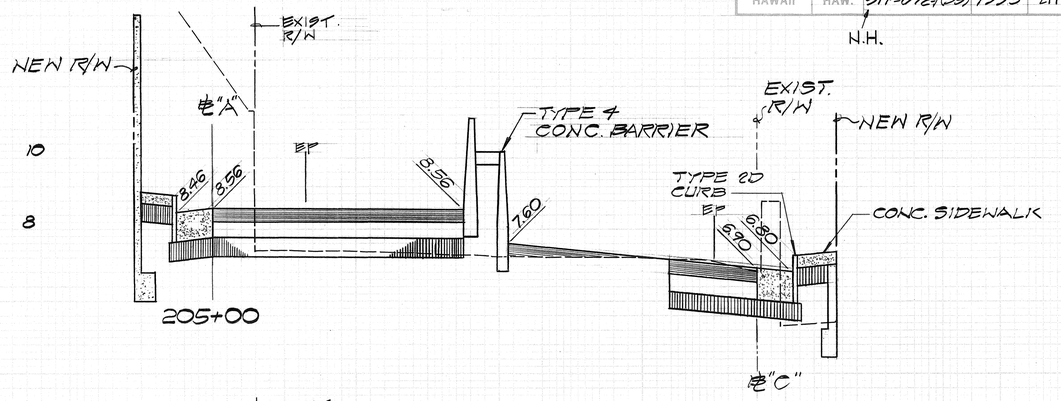

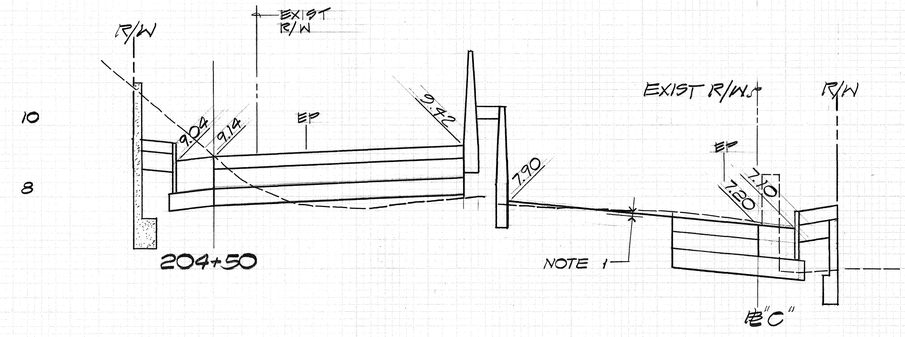

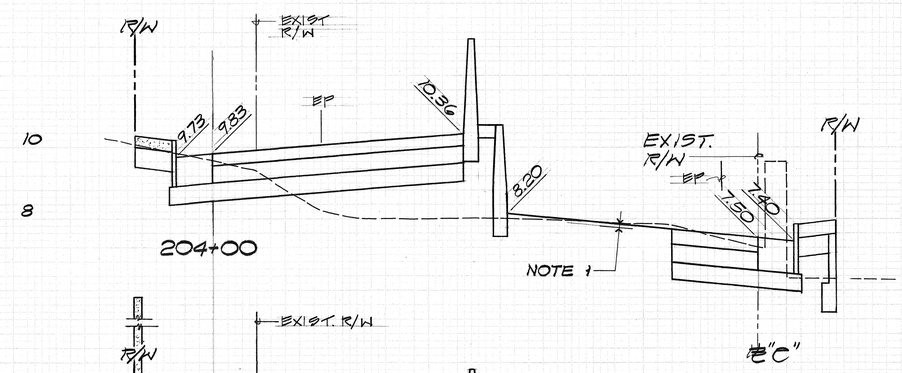

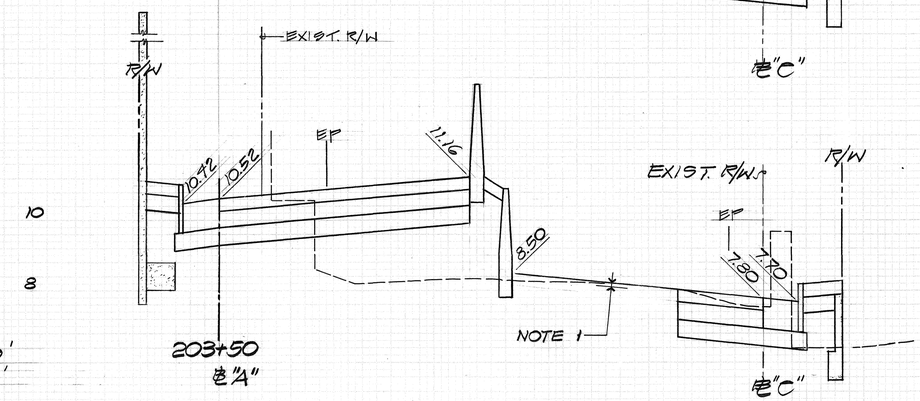

20 0 20 40 60 80 100 20 0 20 40 60 80 100

SHT. NO. H-6 OF 17 SHTS.

211

FED. ROAD DIST. NO.	STATE	FED. AID PROJ. NO.	FISCAL YEAR	SHEET NO.	TOTAL SHEETS
HAWAII	HAW.	STP-0072-1(35)	1993	212	340

N.H

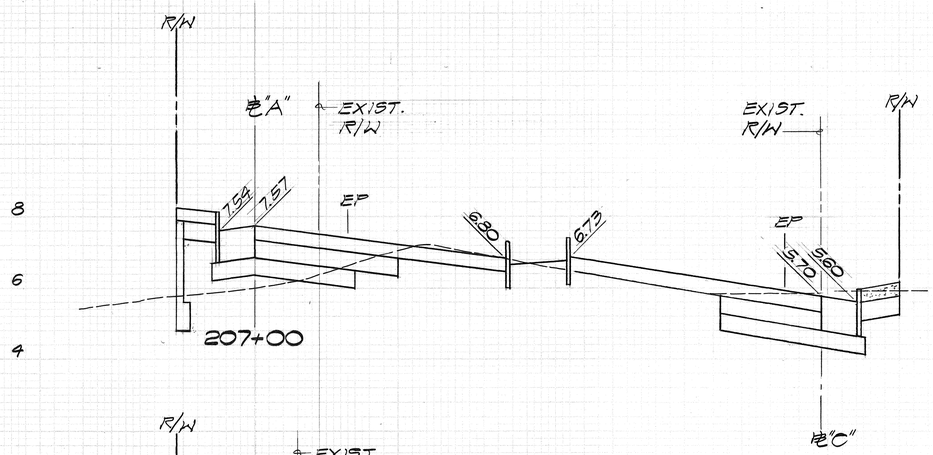

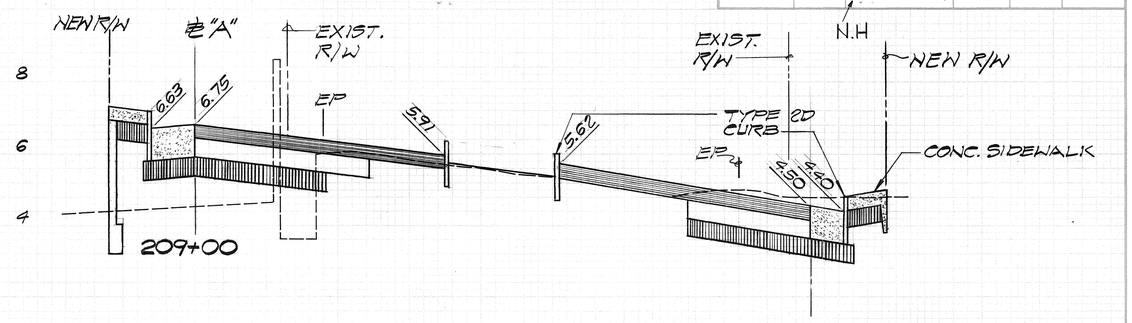

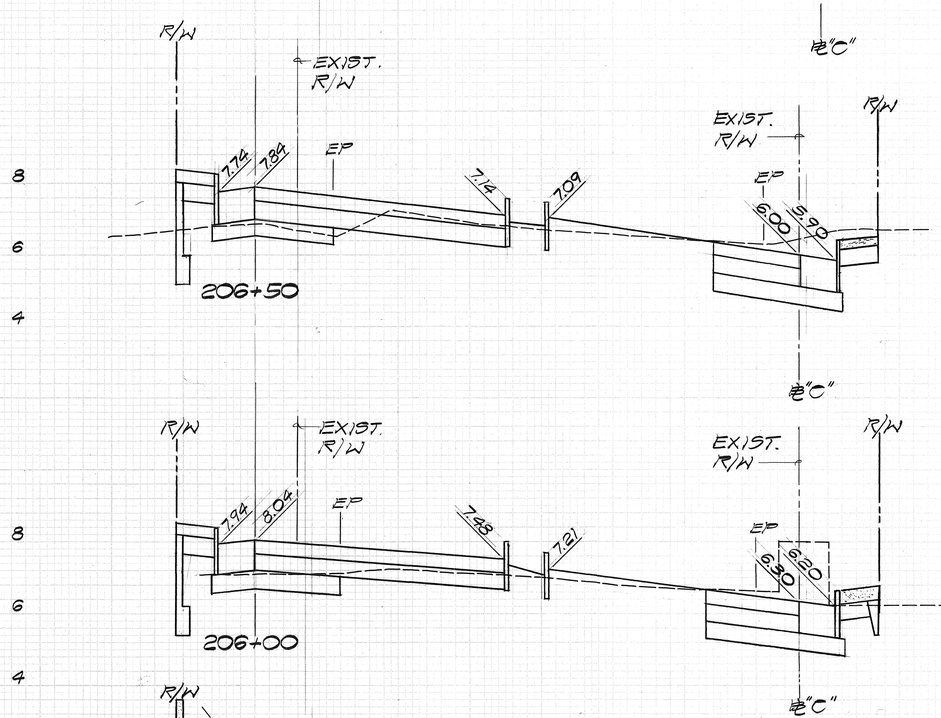

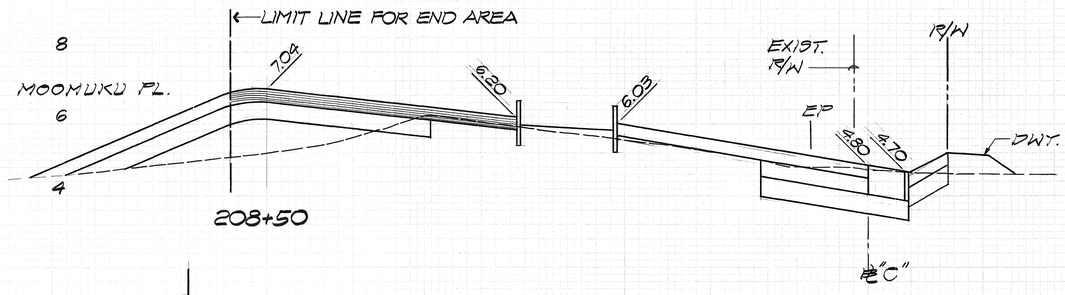

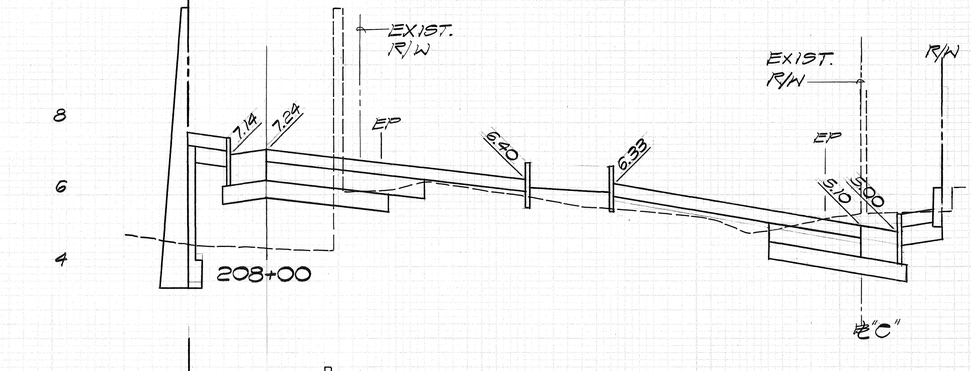

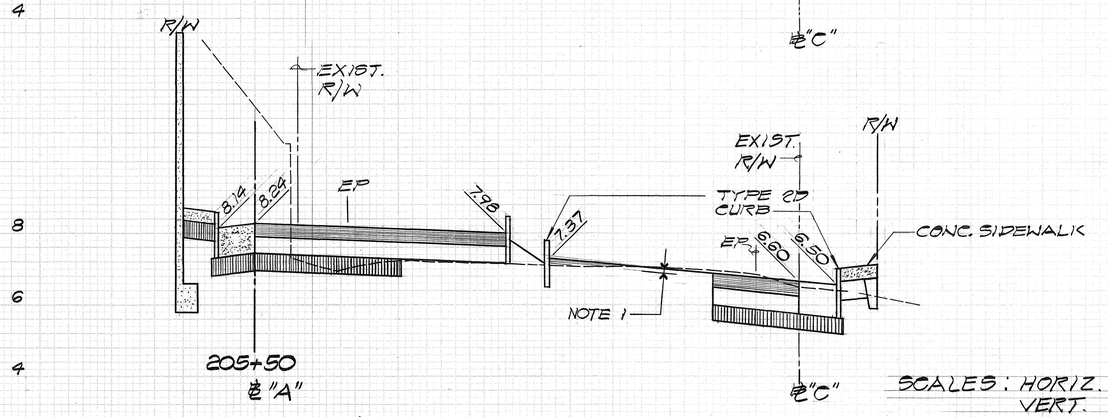

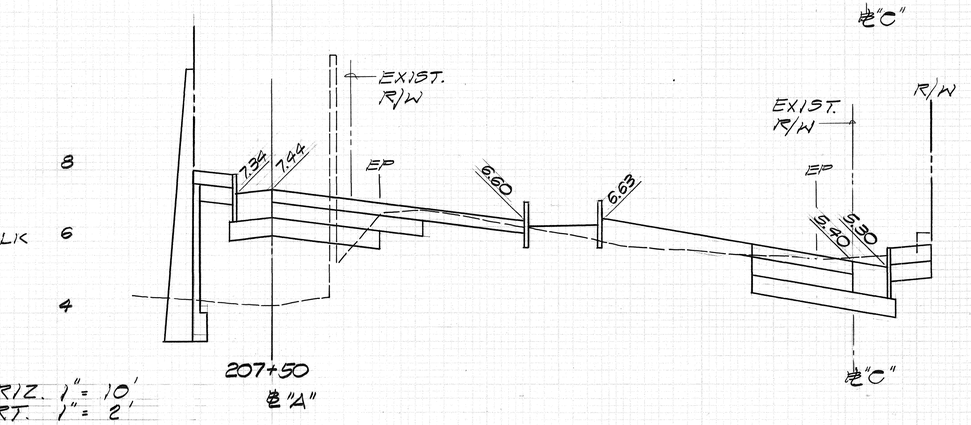

SCALES: HORIZ. 1" = 10'
VERT. 1" = 2'

20 0 20 40 60 80 100 20 0 20 40 60 80 100

SHT. NO. H-7 OF 17 SHTS.

212

FINAL SURVEY	SURVEYED	DATE
	PLOTTED	
NOTE BOOK	TEMPLATE	BY
NO.	AREAS	
	AREAS CHECKED	

ORIGINAL SURVEY	SURVEYED	DATE
	PLOTTED	
NOTE BOOK	TEMPLATE	BY
NO.	AREAS	
	AREAS CHECKED	

84732

FED. ROAD DIST. NO.	STATE	FED. AID PROJ. NO.	FISCAL YEAR	SHEET NO.	TOTAL SHEETS
HAWAII	HAW.	STP-072-1(35)	1993	213	340

FINAL SURVEY — NOTE BOOK — NO. — SURVEYED — PLOTTED — TEMPLATE — AREAS — AREAS CHECKED — BY — DATE

ORIGINAL SURVEY — NOTE BOOK — NO. — SURVEYED — PLOTTED — TEMPLATE — AREAS — AREAS CHECKED — BY — DATE

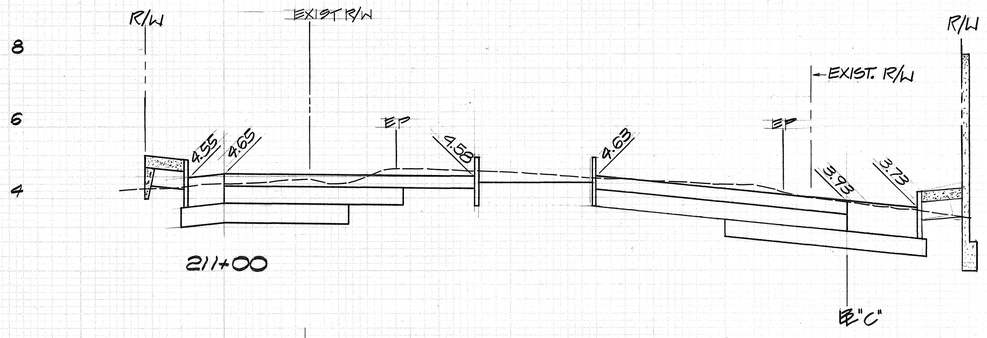

211+00

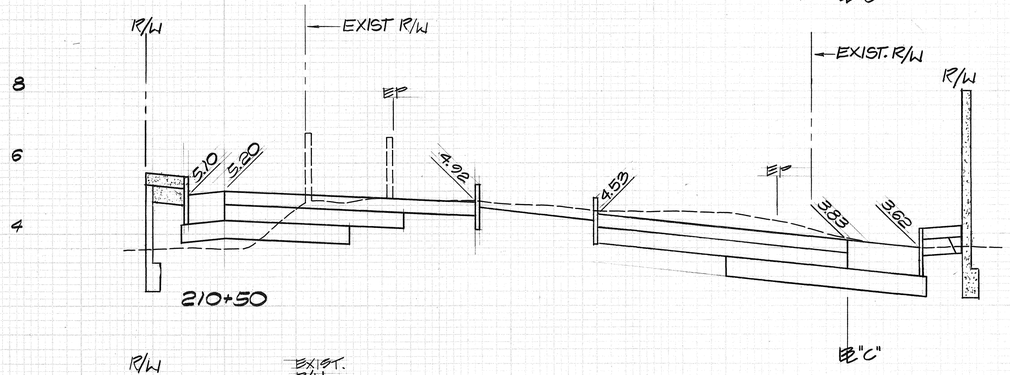

210+50

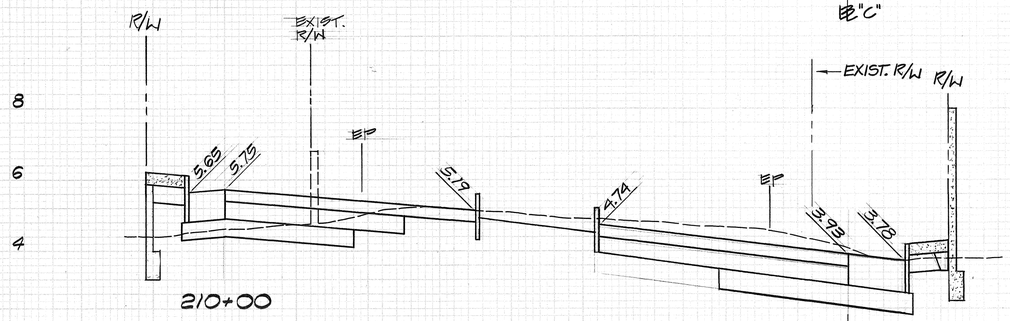

210+00

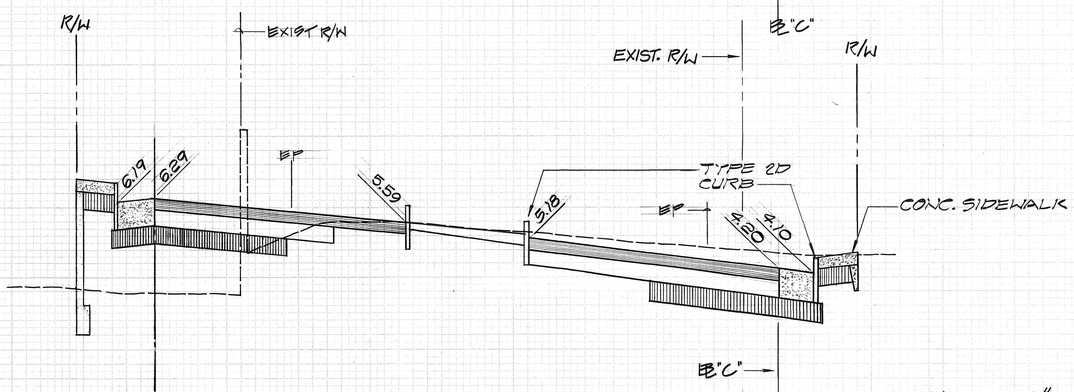

209+50
℄ "A"

SCALES: HORIZ. 1" = 10'
VERT. 1" = 2'

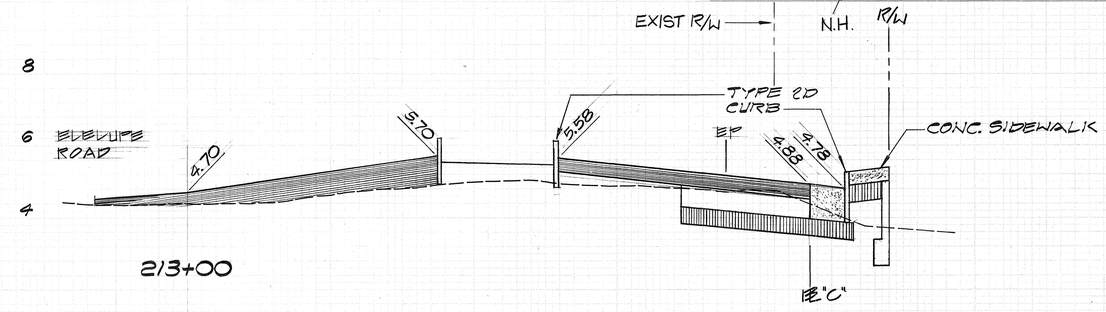

213+00

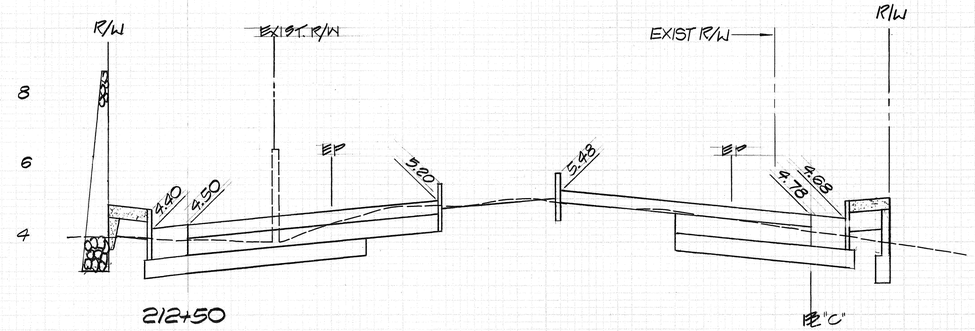

212+50

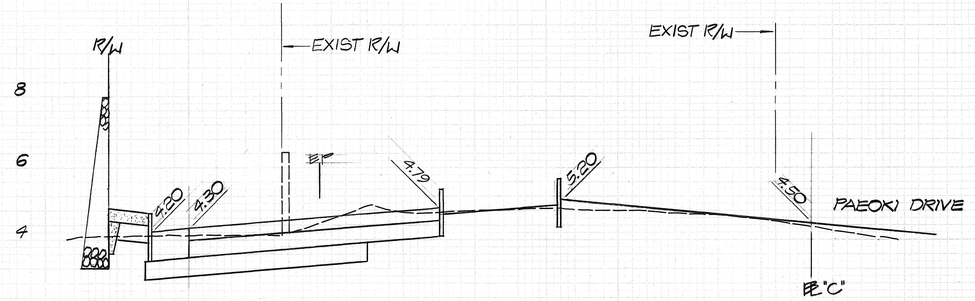

212+00

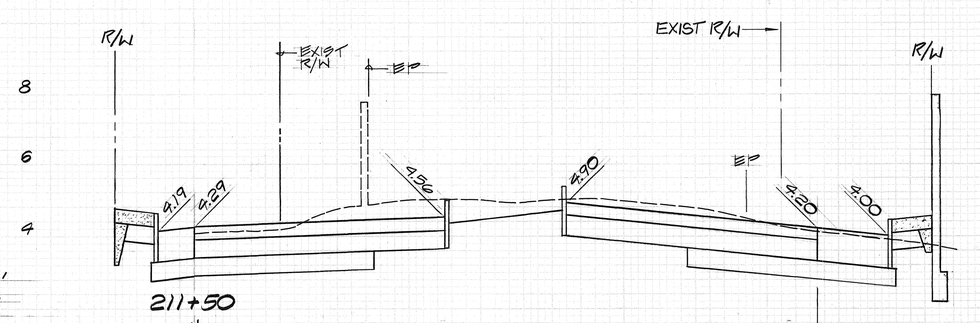

211+50
℄ "A"

20 0 20 40 60 80 100 20 0 20 40 60 80 100

SHT. NO. H-8 OF 17 SHTS.

213

FED. ROAD DIST. NO.	STATE	FED. AID PROJ. NO.	FISCAL YEAR	SHEET NO.	TOTAL SHEETS
HAWAII	HAW.	STP 072-1(35)	1993	214	340

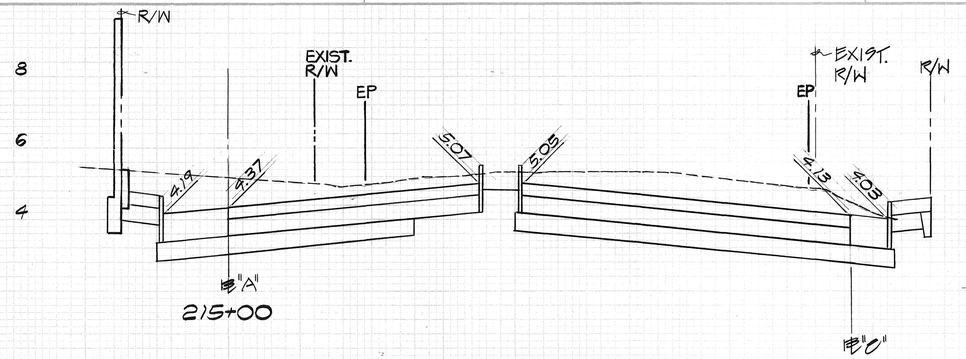

215+00

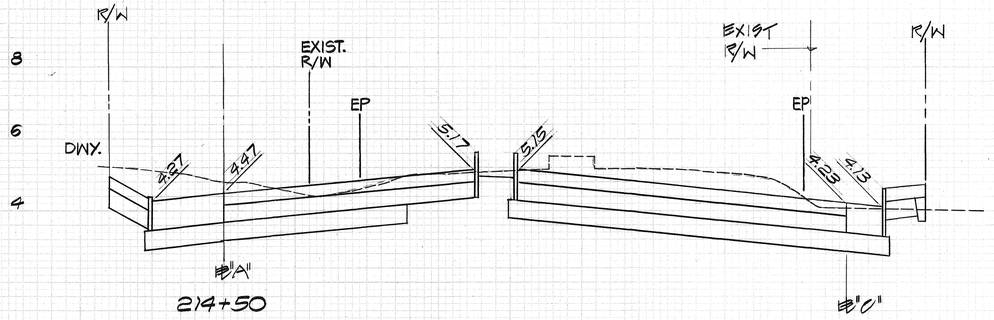

214+50

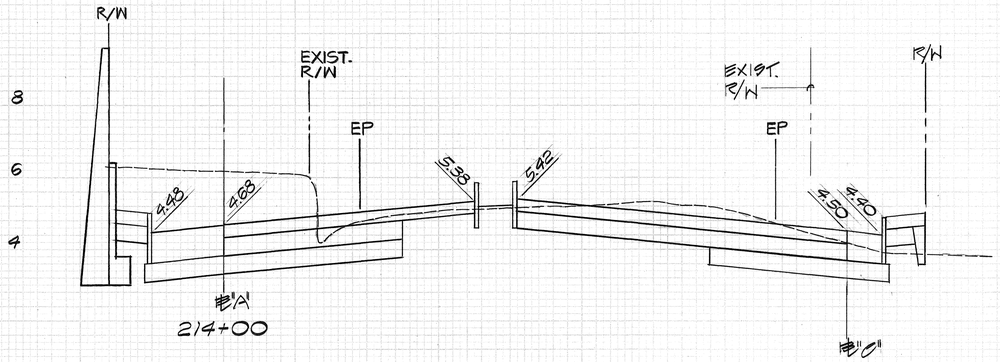

214+00

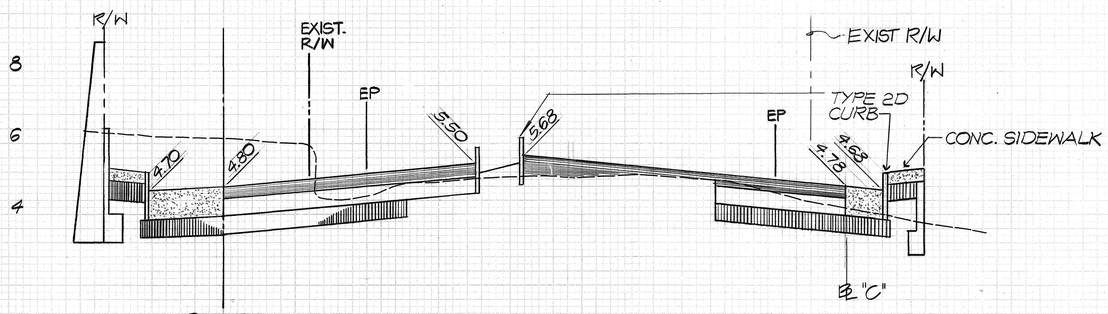

213+50
℄"A"

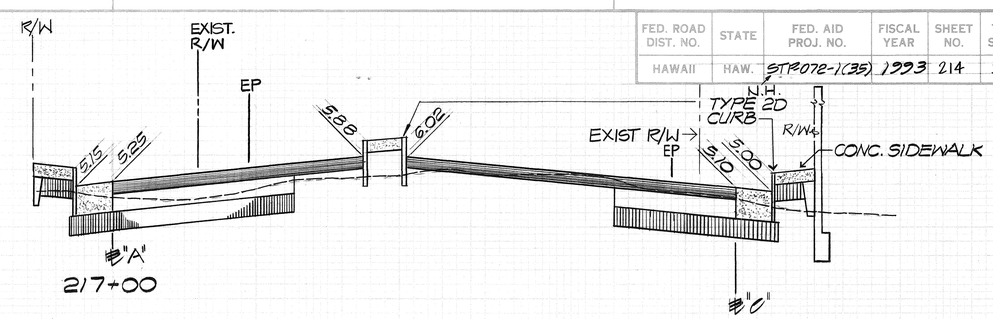

217+00

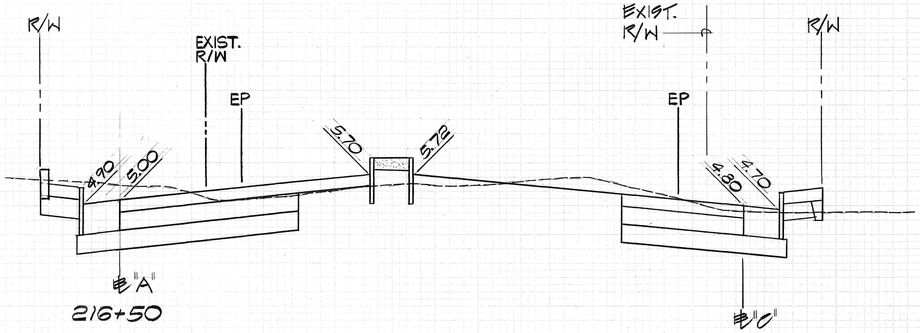

216+50

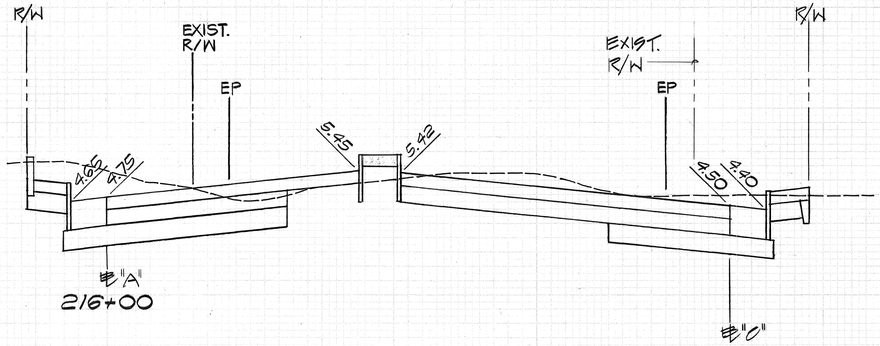

216+00

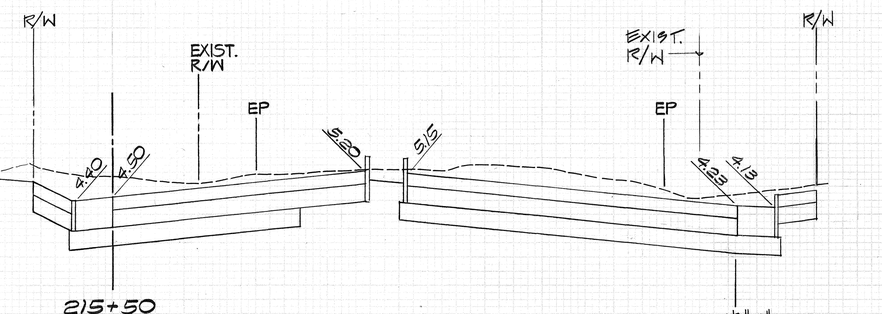

215+50
℄"A"

SCALES: HORIZ. 1" = 10'
VERT. 1" = 2'

20 0 20 40 60 80 100 20 0 20 40 60 80 100

SHT. NO H-9 OF 17 SHTS.

214

FINAL SURVEY	SURVEYED	DATE
	PLOTTED	BY
NOTE BOOK	TEMPLATE	
NO.	AREAS	
	AREAS CHECKED	

ORIGINAL SURVEY	SURVEYED	DATE
	PLOTTED	BY
NOTE BOOK	TEMPLATE	
NO.	AREAS	
	AREAS CHECKED	

FED. ROAD DIST. NO.	STATE	FED. AID PROJ. NO.	FISCAL YEAR	SHEET NO.	TOTAL SHEETS
HAWAII	HAW.	STP-072-1(35)	1993	215	340

N.H.-

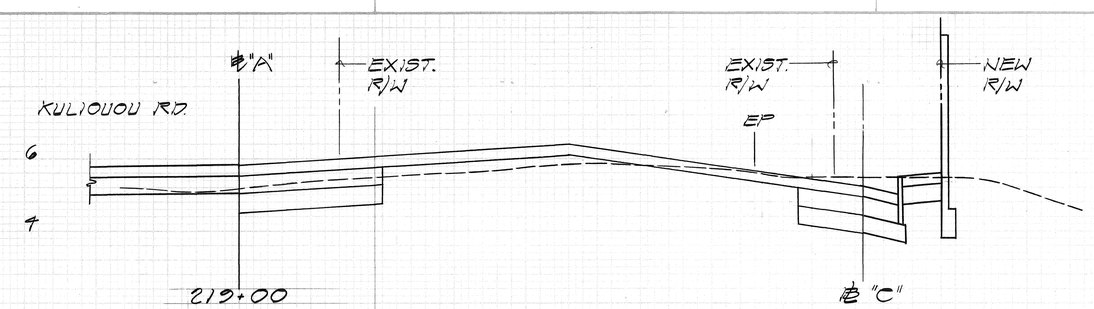

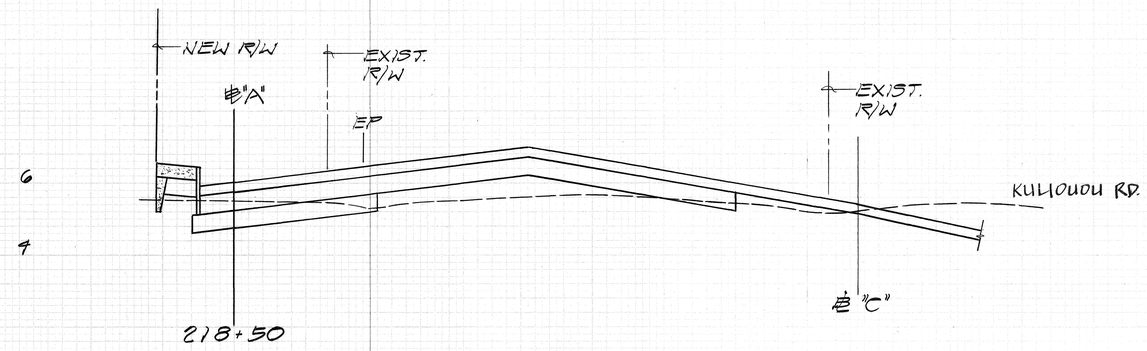

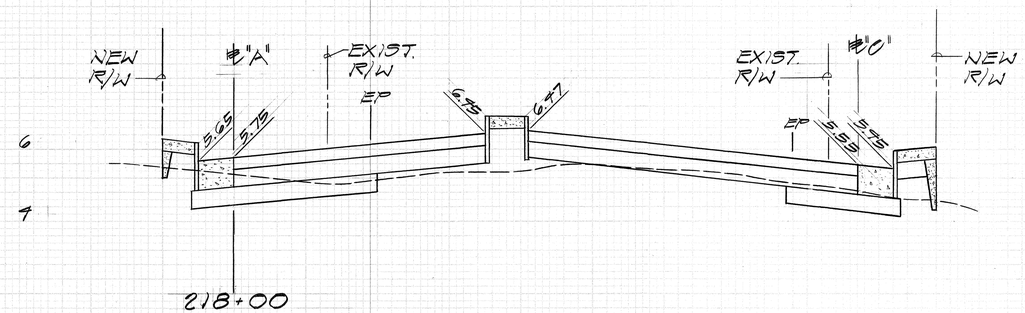

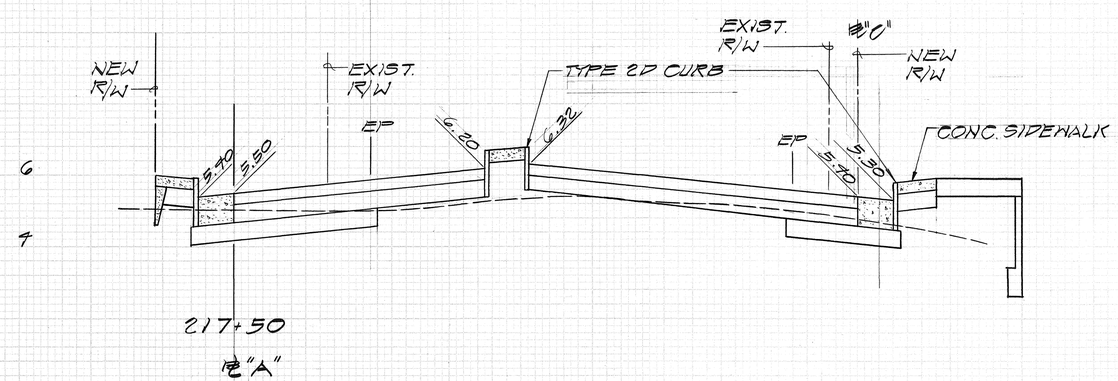

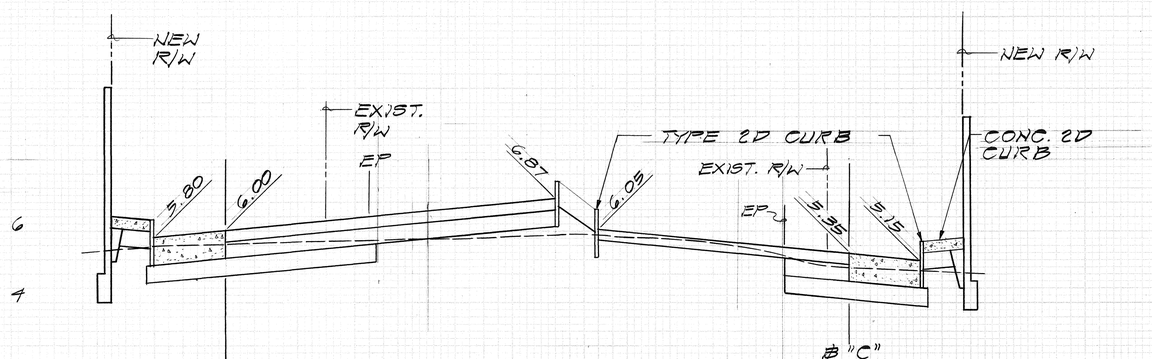

SHT. NO. H-10 OF 17 SHTS.

215

FINAL SURVEY — DATE / BY / SURVEYED / PLOTTED / TEMPLATE / AREAS / AREAS CHECKED / NOTE BOOK / NO.

ORIGINAL SURVEY — DATE / BY / SURVEYED / PLOTTED / TEMPLATE / AREAS / AREAS CHECKED / NOTE BOOK / NO.

FED. ROAD DIST. NO.	STATE	FED. AID PROJ. NO.	FISCAL YEAR	SHEET NO.	TOTAL SHEETS
HAWAII	HAW.	STP-072-1(65)	1993	216	340

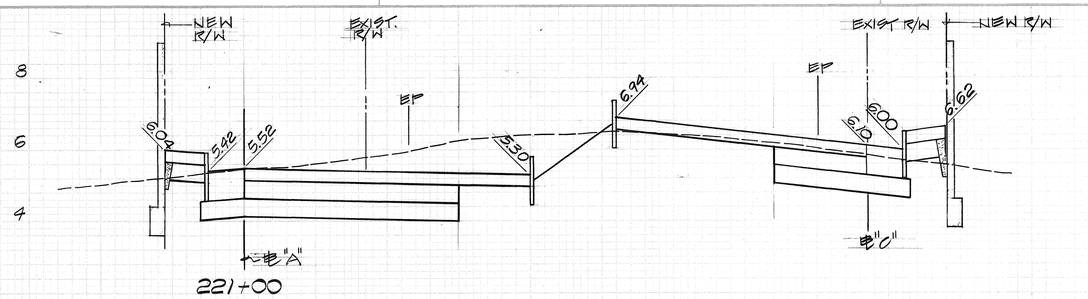

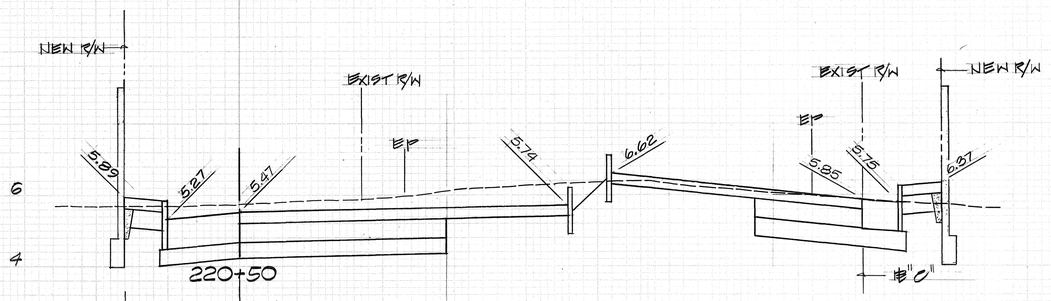

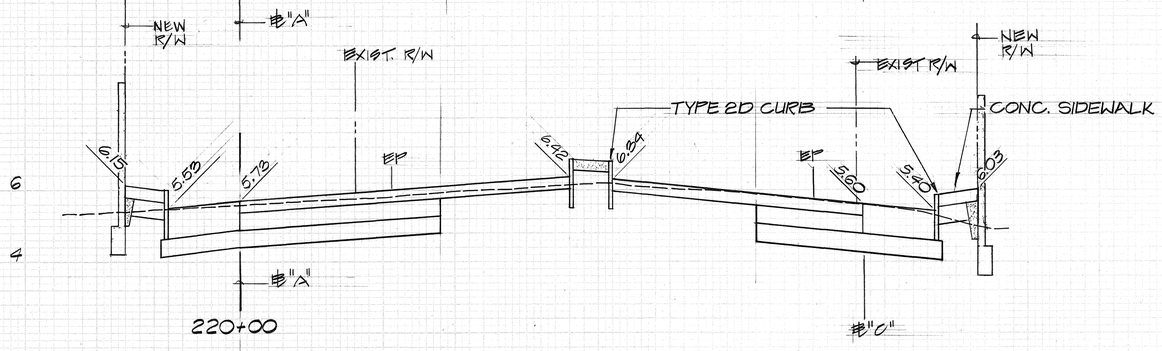

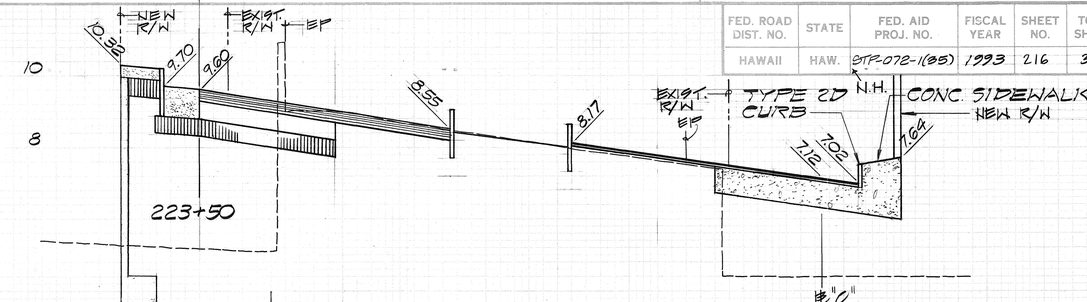

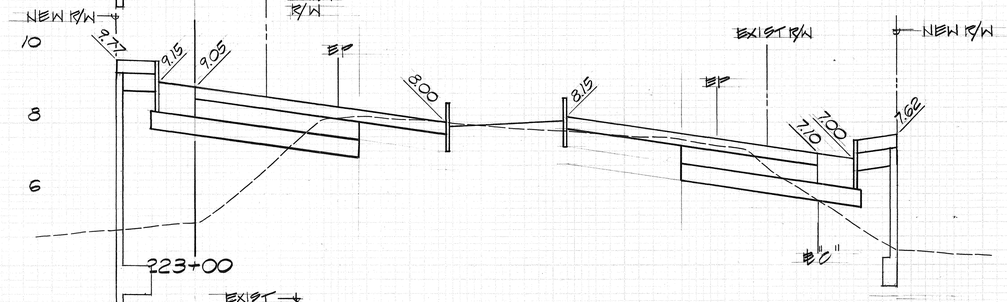

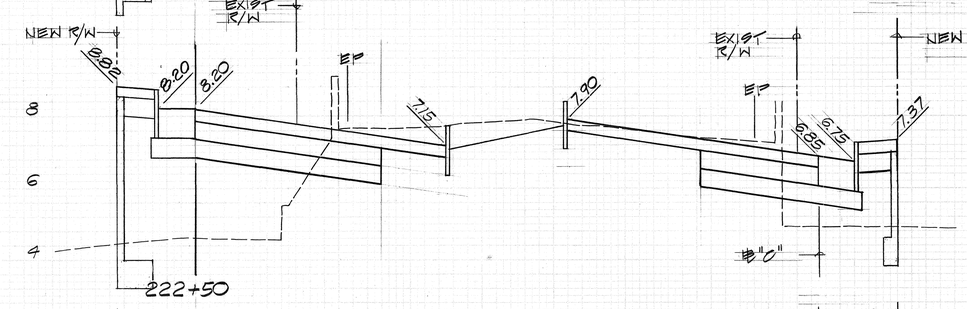

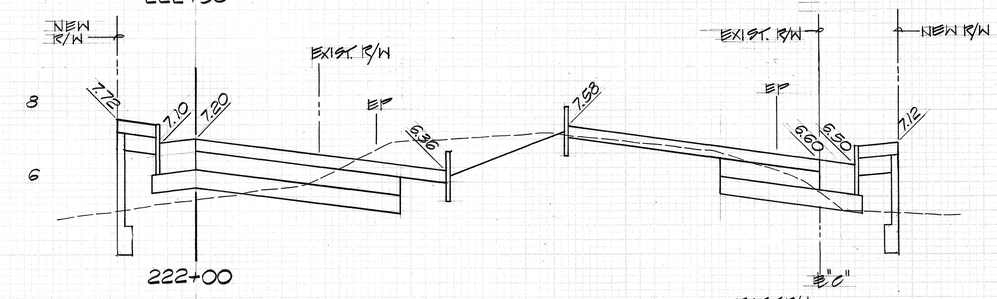

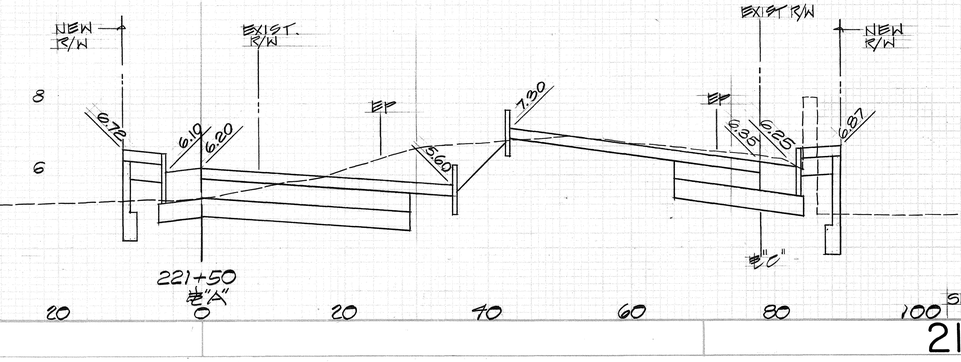

SCALES: HORIZ. 1" = 10'
VERT. 1 = 2'

20 0 20 40 60 80 100 20 0 20 40 60 80 100

SHT. NO. H-11 OF 17 SHTS

216

FINAL SURVEY	SURVEYED	BY	DATE
	PLOTTED		
NOTE BOOK	TEMPLATE		
NO.	AREAS		
	AREAS CHECKED		

ORIGINAL SURVEY	SURVEYED	BY	DATE
	PLOTTED		
NOTE BOOK	TEMPLATE		
NO.	AREAS		
	AREAS CHECKED		

84732

FED. ROAD DIST. NO.	STATE	FED. AID PROJ. NO.	FISCAL YEAR	SHEET NO.	TOTAL SHEETS
HAWAII	HAW.	STP-078-1(35)	1993	217	340

N.H.

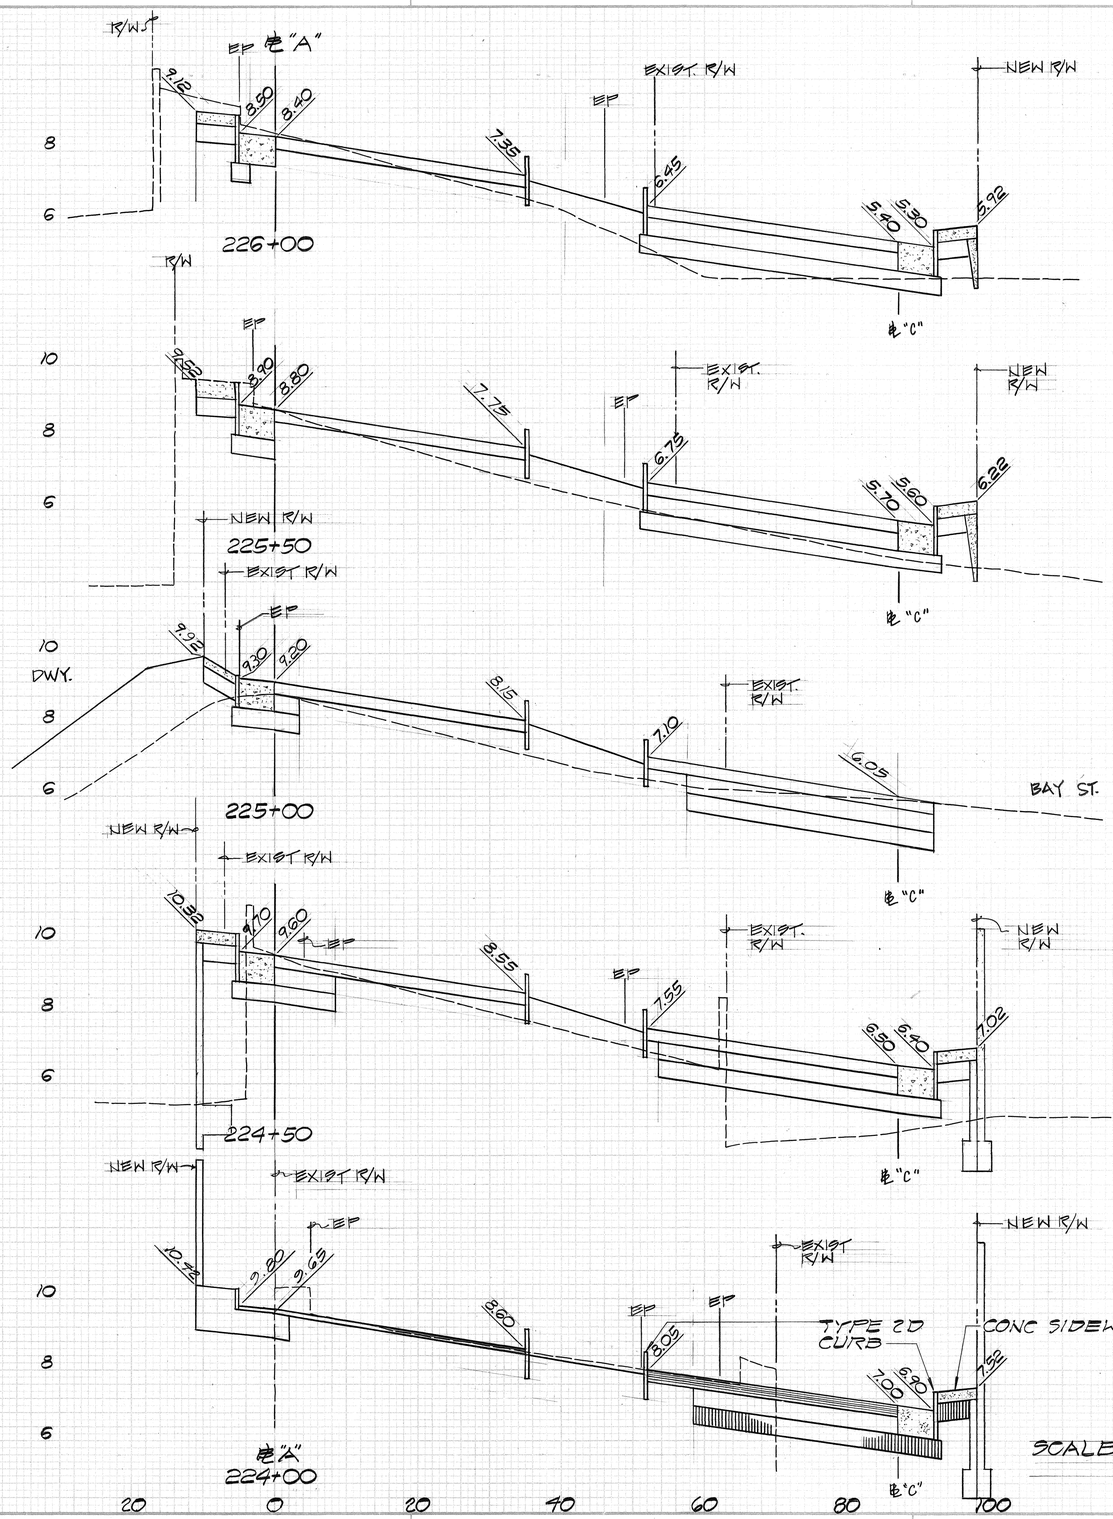

SCALES: HORIZ. 1" = 10'
VERT. 1" = 2'

SHT. NO. H-12 OF 17 SHTS.

217

FINAL SURVEY — DATE, BY, SURVEYED, PLOTTED, TEMPLATE, AREAS, AREAS CHECKED, NOTE BOOK, NO.

ORIGINAL SURVEY — DATE, BY, SURVEYED, PLOTTED, TEMPLATE, AREAS, AREAS CHECKED, NOTE BOOK, NO.

FED. ROAD DIST. NO.	STATE	FED. AID PROJ. NO.	FISCAL YEAR	SHEET NO.	TOTAL SHEETS
HAWAII	HAW.	STP 072-1(86)	1993	218	340

84732

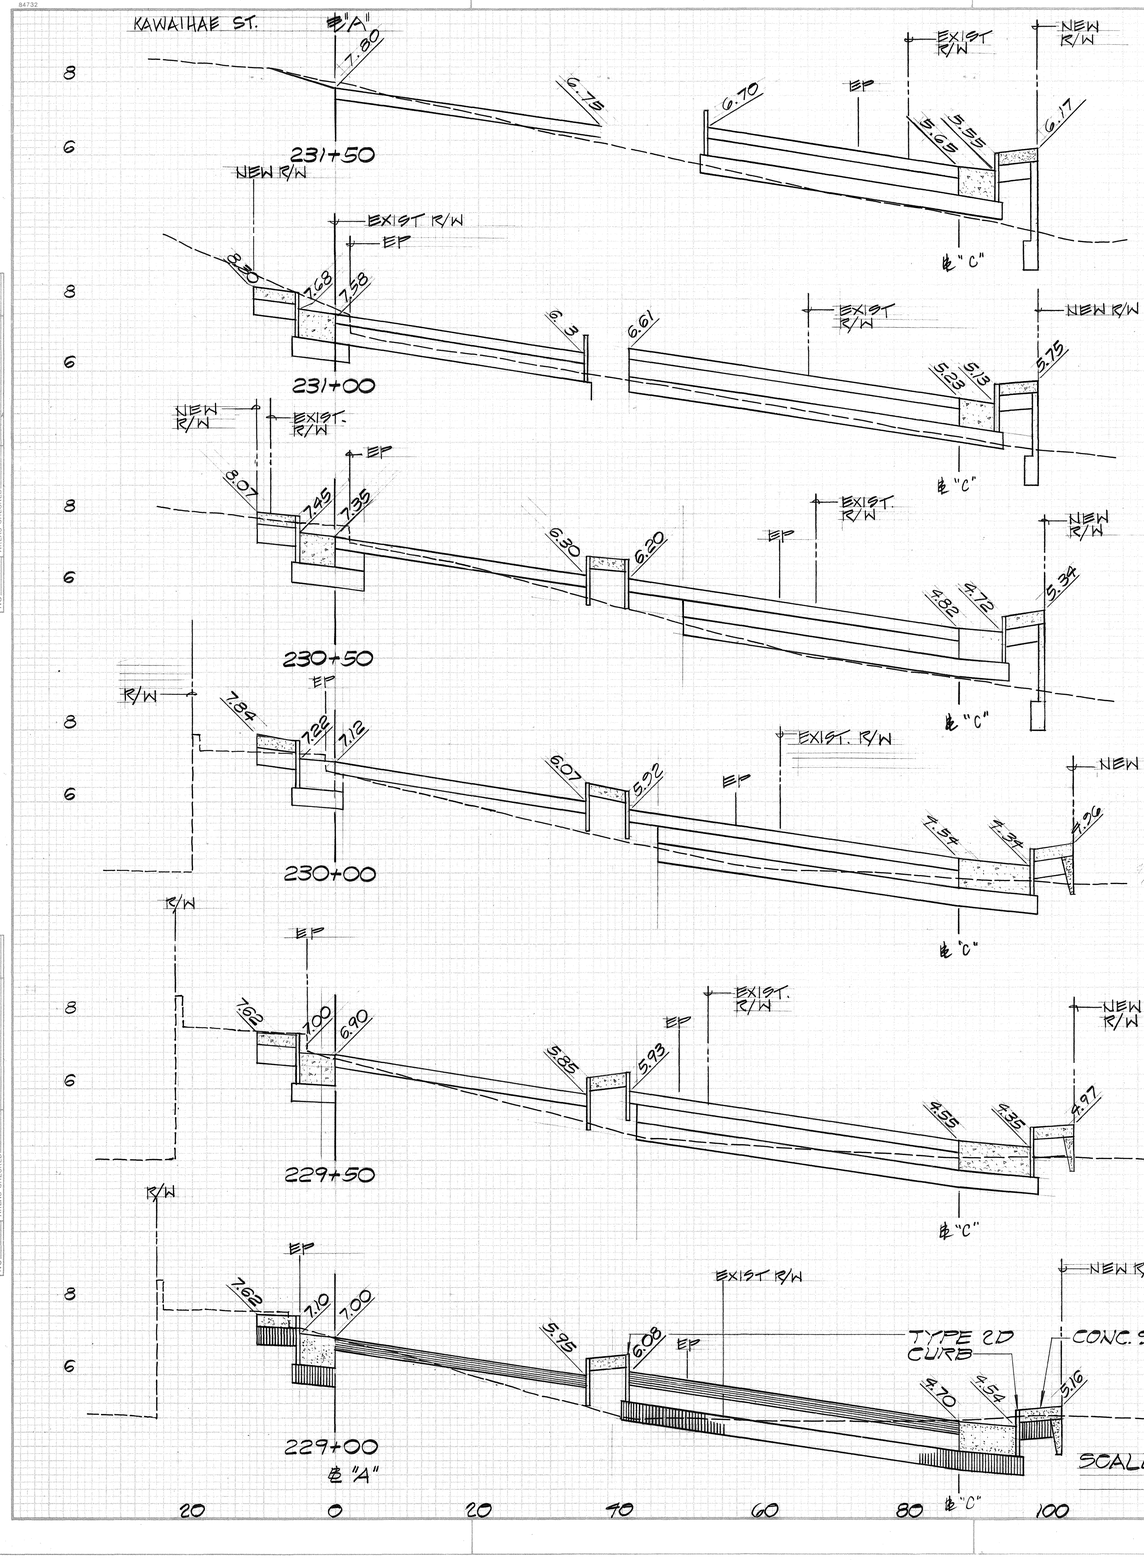

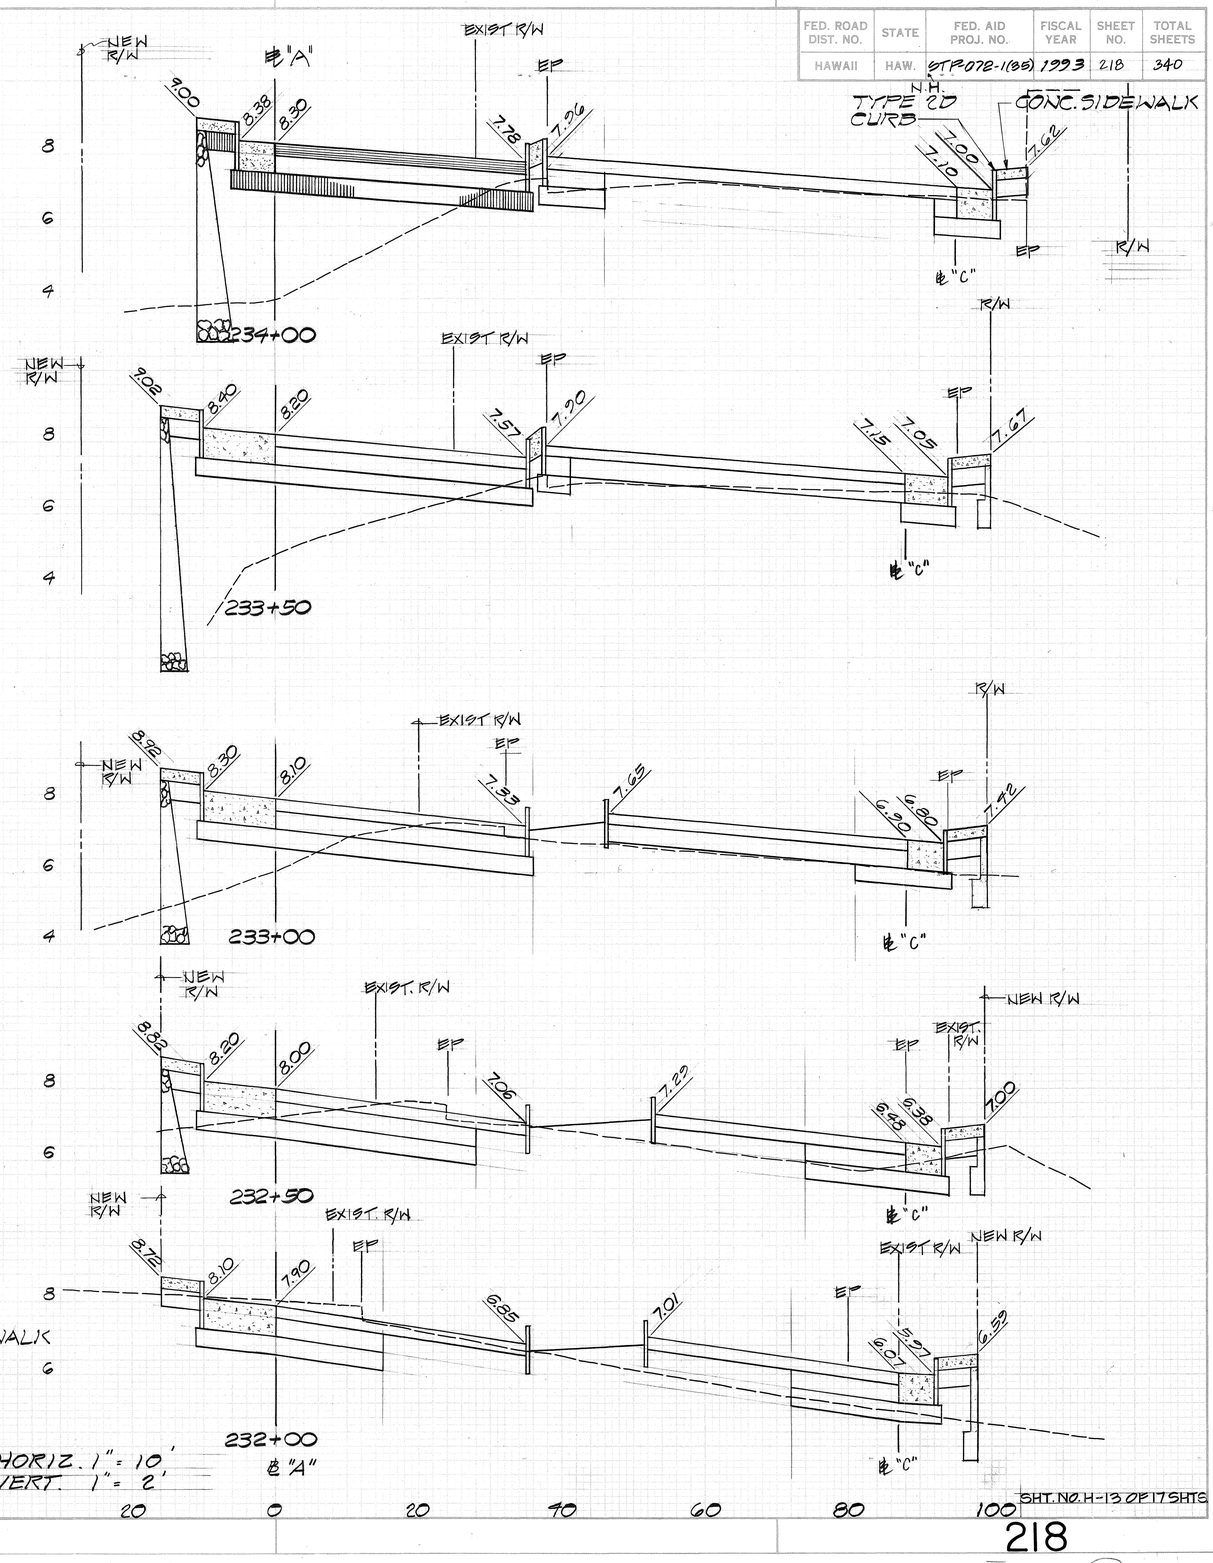

SCALES: HORIZ. 1" = 10'
VERT. 1" = 2'

20 0 20 40 60 80 100 20 0 20 40 60 80 100

SHT. NO. H-13 OF 17 SHTS

218

FINAL SURVEY — DATE, BY, SURVEYED, PLOTTED, TEMPLATE, AREAS, AREAS CHECKED, NOTE BOOK, NO.

ORIGINAL SURVEY — DATE, BY, SURVEYED, PLOTTED, TEMPLATE, AREAS, AREAS CHECKED, NOTE BOOK, NO.

FED. ROAD DIST. NO.	STATE	FED. AID PROJ. NO.	FISCAL YEAR	SHEET NO.	TOTAL SHEETS
HAWAII	HAW.	STP-072-1(35)	1993	219	340

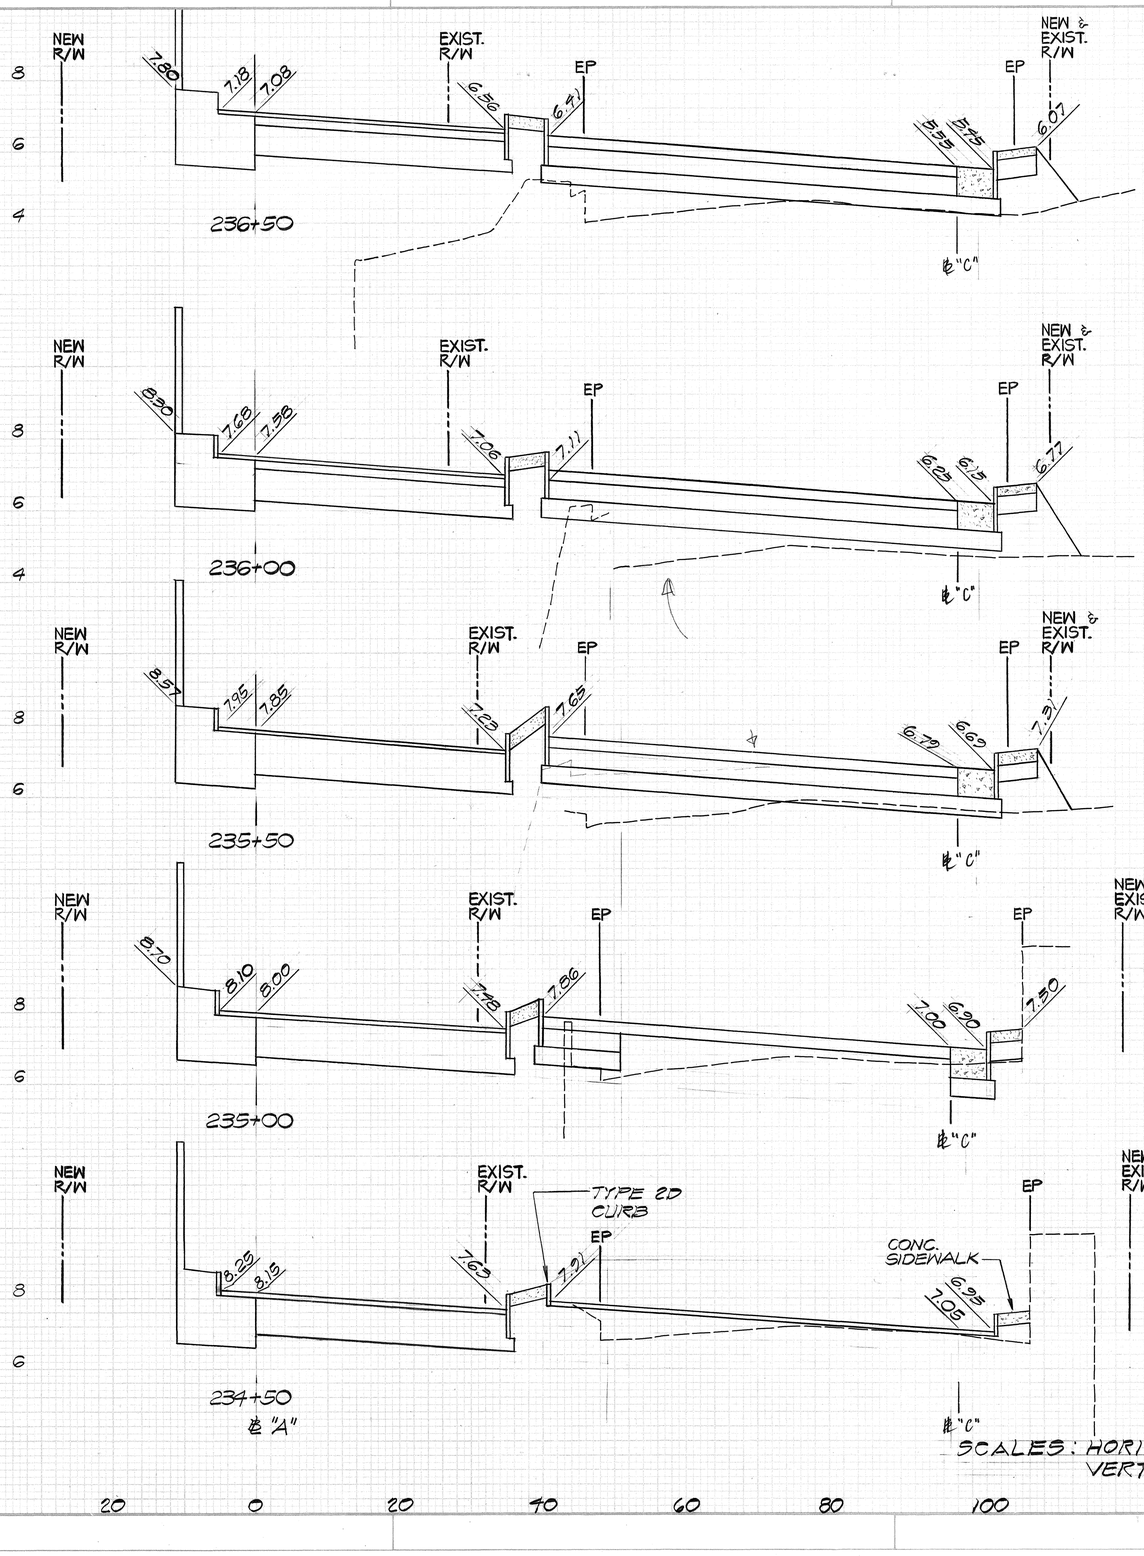

SCALES: HORIZ. 1" = 10'
VERT. 1" = 2'

SHT. NO. H-14 OF 17 SHTS.

219

II

(4)

FINAL SURVEY — SURVEYED, PLOTTED, TEMPLATE, AREAS, AREAS CHECKED, NOTE BOOK, NO., BY, DATE

ORIGINAL SURVEY — SURVEYED, PLOTTED, TEMPLATE, AREAS, AREAS CHECKED, NOTE BOOK, NO., BY, DATE

84732

FED. ROAD DIST. NO.	STATE	FED. AID PROJ. NO.	FISCAL YEAR	SHEET NO.	TOTAL SHEETS
HAWAII	HAW.	STP 072-1(35)	1993	220	340

N.H.

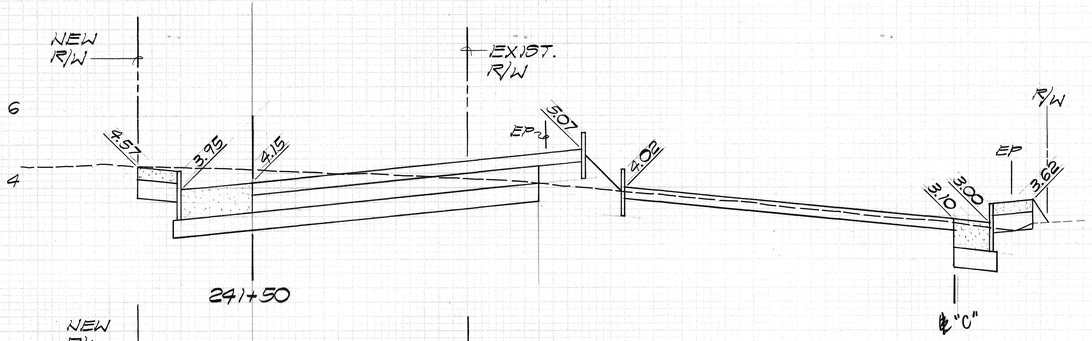

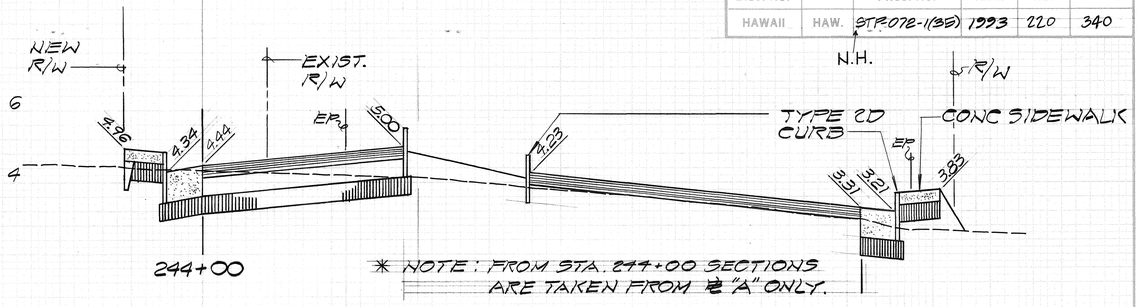

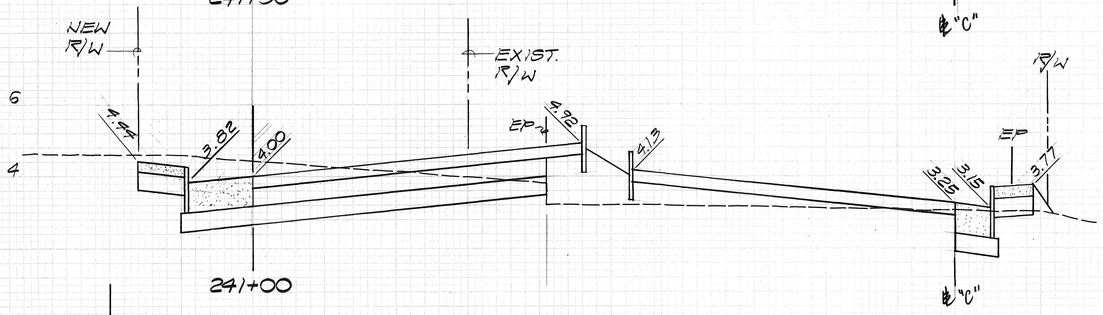

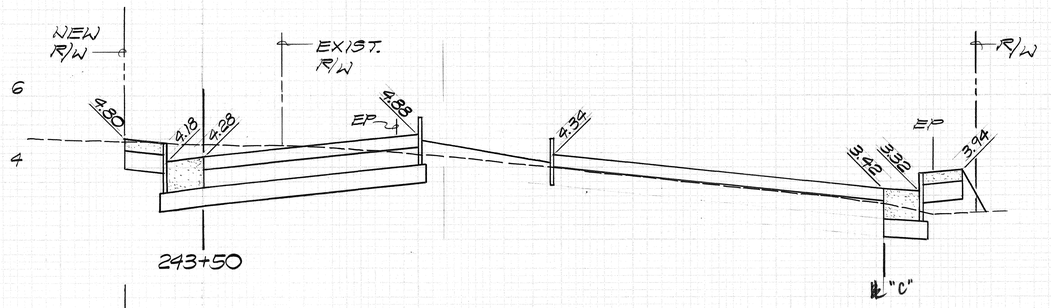

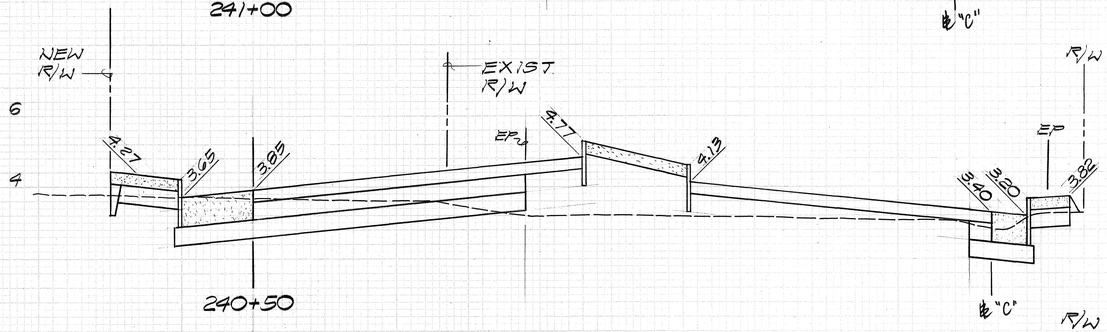

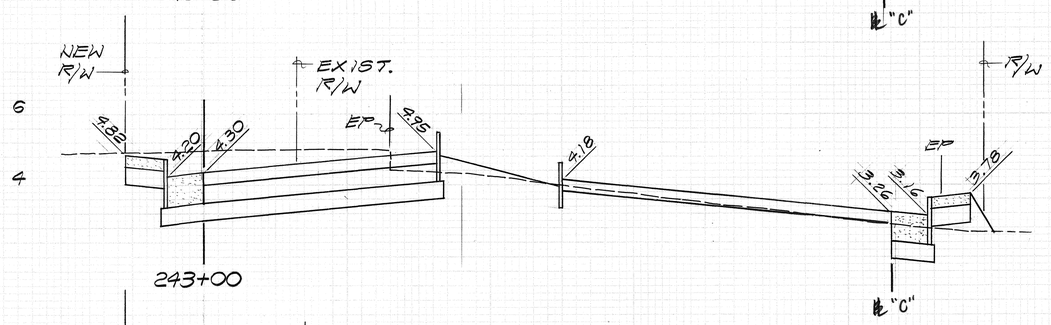

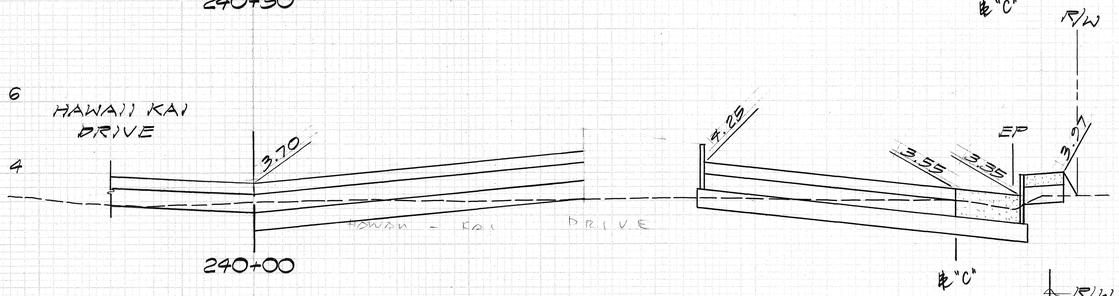

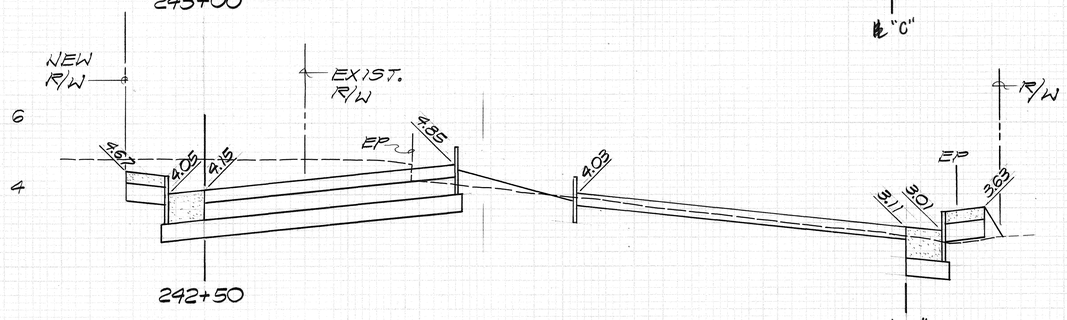

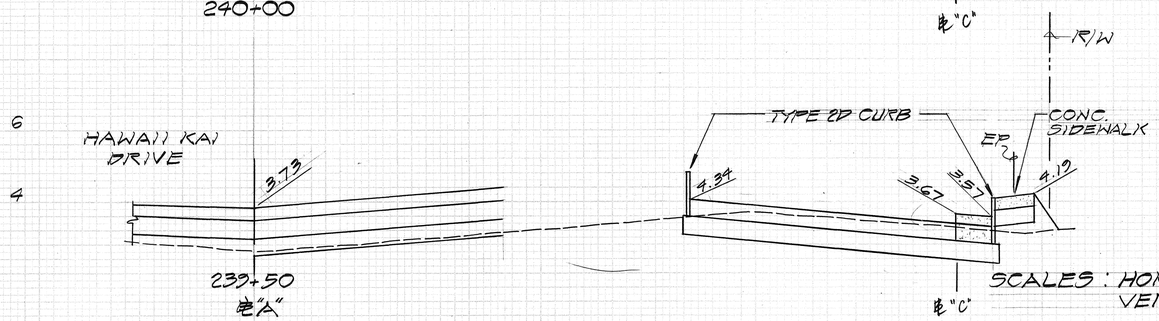

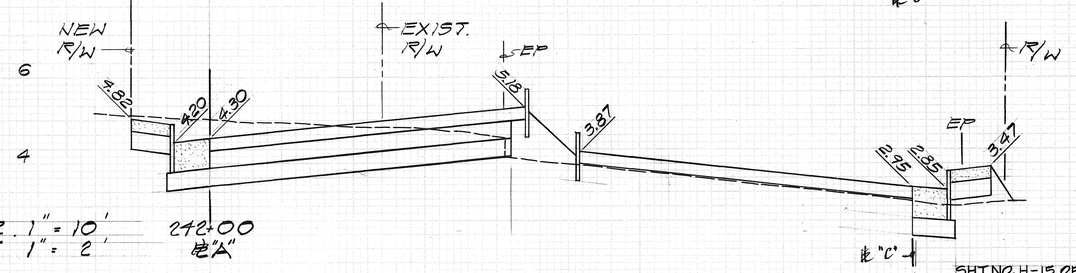

SCALES: HORIZ. 1" = 10'
VERT. 1" = 2'

20 0 20 40 60 80 100 20 0 20 40 60 80 100

SHT. NO. H-15 OF 17 SHTS.

220

ORIGINAL SURVEY / FINAL SURVEY — SURVEYED, PLOTTED, TEMPLATE, AREAS, AREAS CHECKED, NOTE BOOK, NO., BY, DATE

84732

FED. ROAD DIST. NO.	STATE	FED. AID PROJ. NO.	FISCAL YEAR	SHEET NO.	TOTAL SHEETS
HAWAII	HAW.	STP-072-1(85)	1993	221	340

N.H.-

FINAL SURVEY	ORIGINAL SURVEY	BY	DATE
NOTE BOOK			
NO.			
SURVEYED			
PLOTTED			
TEMPLATE			
AREAS			
AREAS CHECKED			

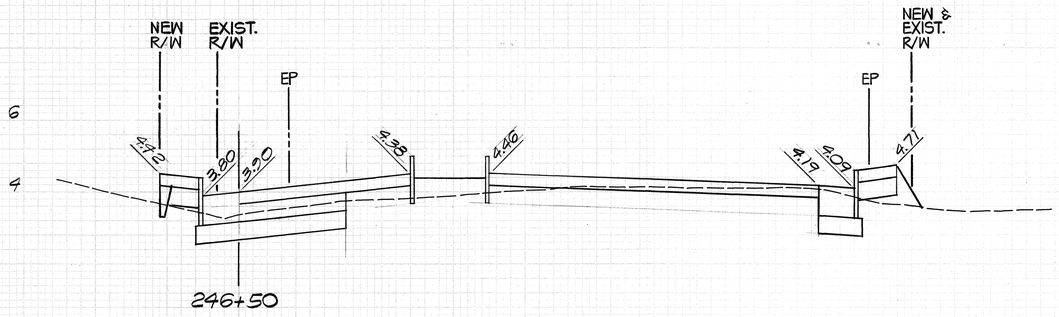

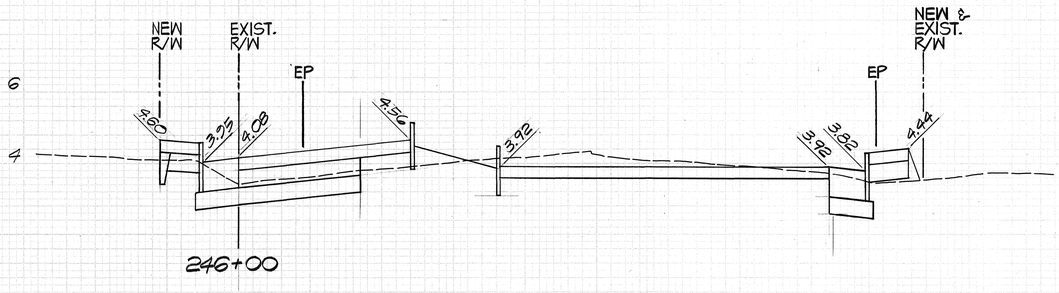

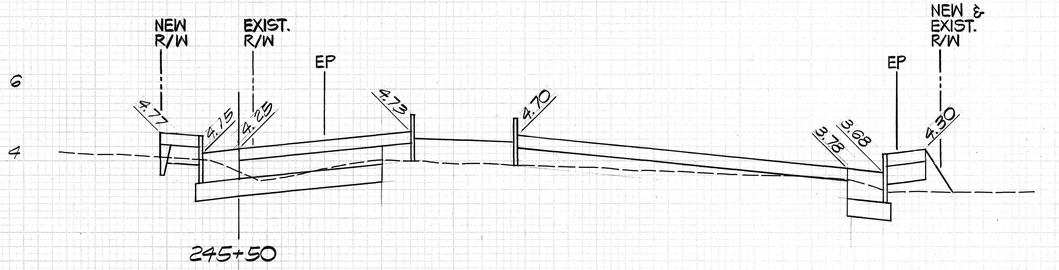

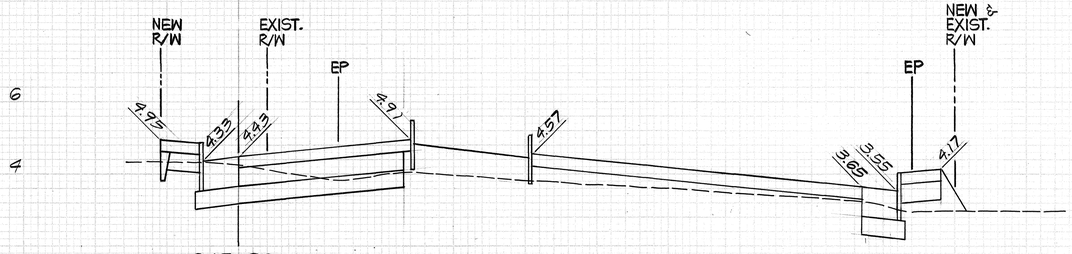

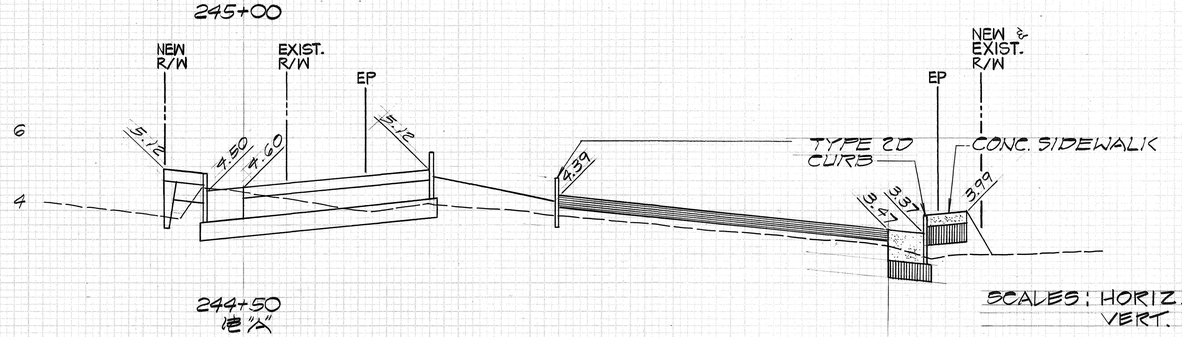

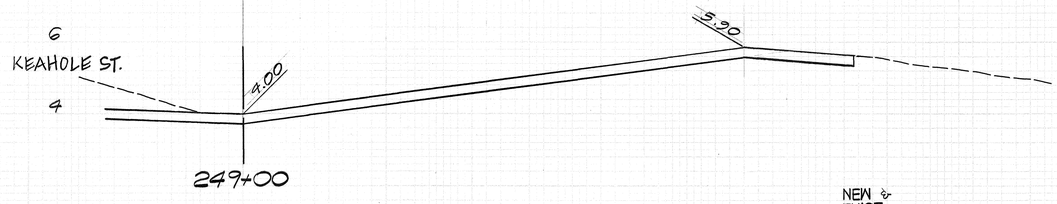

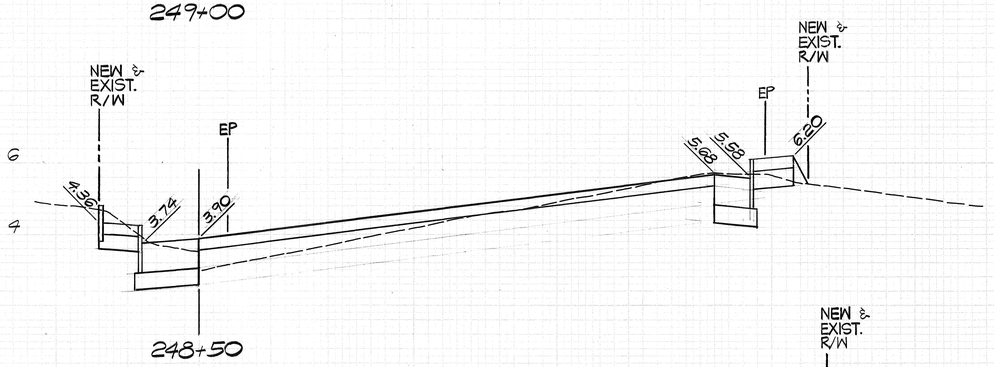

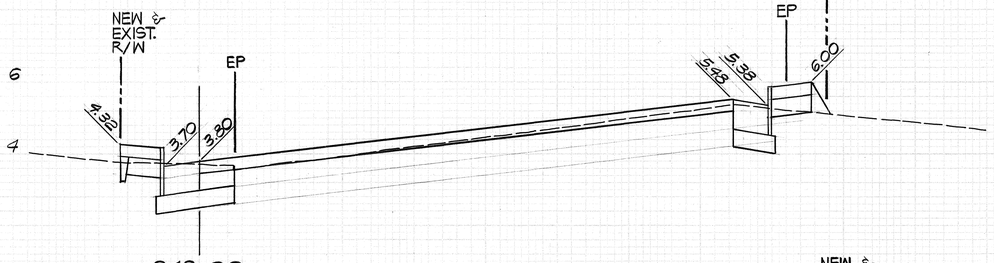

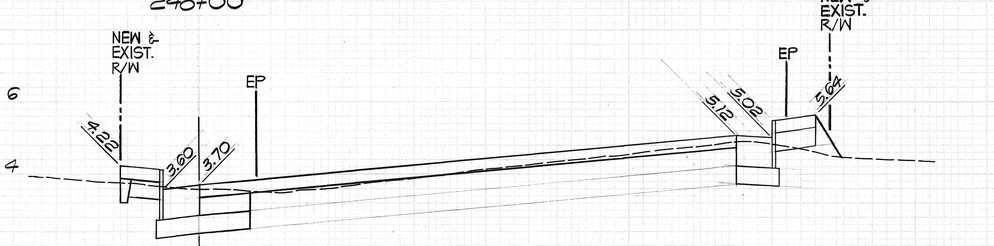

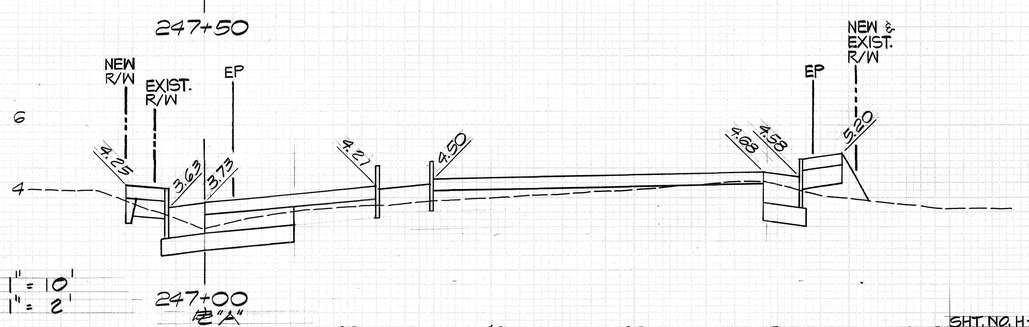

SCALES: HORIZ. 1" = 10'
VERT. 1" = 2'

SHT. NO. H-16 OF 17 SHTS.

221

84732

FED. ROAD DIST. NO.	STATE	FED. AID PROJ. NO.	FISCAL YEAR	SHEET NO.	TOTAL SHEETS
HAWAII	HAW.	STP-078-1(36)	1993	222	340

N.H.

FINAL SURVEY — NOTE BOOK — NO. — SURVEYED — PLOTTED — TEMPLATE — AREAS — AREAS CHECKED — BY — DATE

ORIGINAL SURVEY — NOTE BOOK — NO. — SURVEYED — PLOTTED — TEMPLATE — AREAS — AREAS CHECKED — BY — DATE

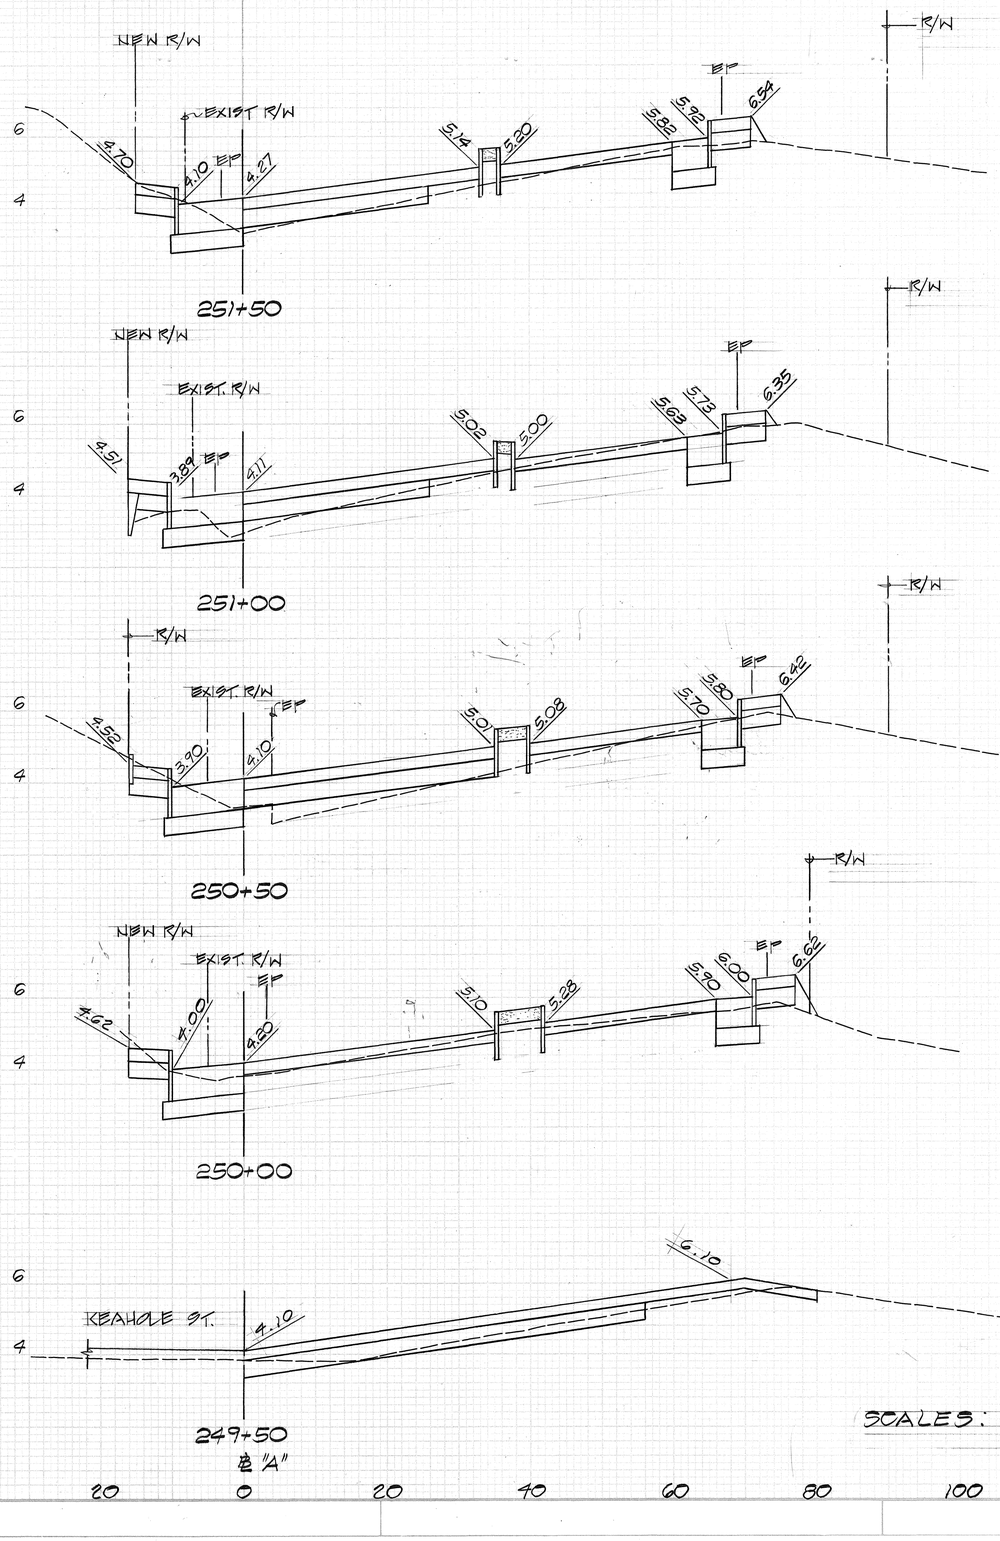

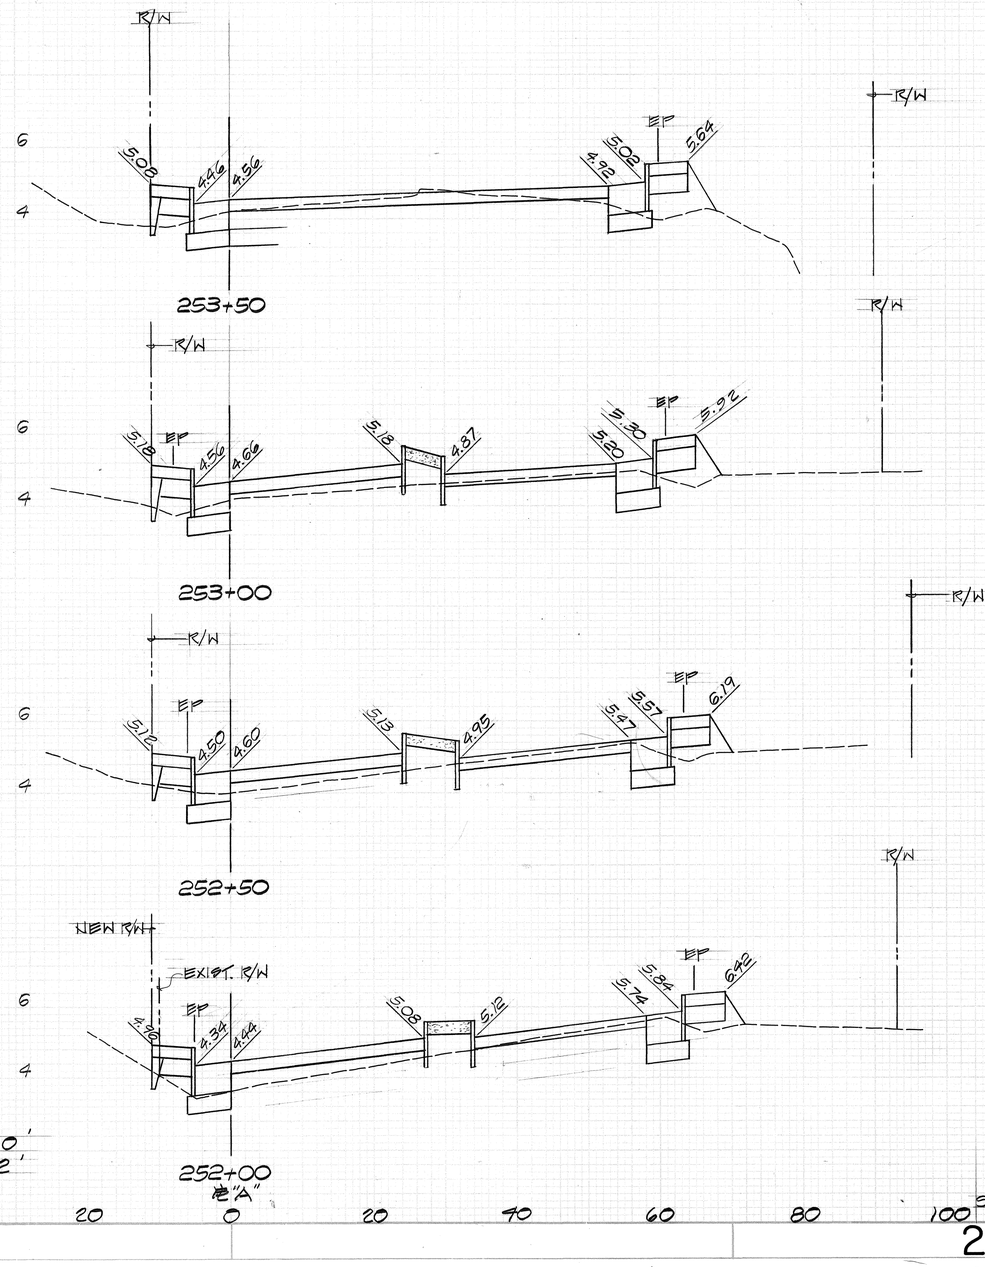

SCALES: HORIZ. 1" = 10'
VERT. 1" = 2'

20 0 20 40 60 80 100

SHT. NO. H-17 OF 17 SHTS

222