FED. ROAD DIST. NO.	STATE	FED. AID PROJ. NO.	FISCAL YEAR	SHEET NO.	TOTAL SHEETS
HAWAII	HAW.	STP-072-1(40)	1993	1	20

INDEX TO DRAWINGS

SHEET NO.	DESCRIPTION
1	TITLE SHEET
2	STANDARD PLANS SUMMARY
3	GENERAL NOTES AND LEGEND
① 4 – 6	TYPICAL SECTIONS
② 7 – 12	ROADWAY PLANS
13	PAVEMENT MARKING, LEGEND, DETAILS AND NOTES
14 – 19	PAVEMENT MARKING AND SIGNING PLAN
③ 20	TRAFFIC SUMMARIES

Plan Shts. No. ①4S-1, ②C.0.12S-1 and ③C.0.20S-1 through C.0.20S-5 are supplemental sheets to this project. TOTAL SHEET COUNT after "AS-BUILT" posting 27 Sheets.

STATE OF HAWAII

DEPARTMENT OF TRANSPORTATION

HIGHWAYS DIVISION

HONOLULU, HAWAII

"AS-BUILT"

PLANS FOR

KALANIANAOLE HIGHWAY RESURFACING

MAKAPUU LIGHTHOUSE ROAD TO BLOWHOLE LOOKOUT

FEDERAL AID PROJECT NO. STP-072-1(40)

DISTRICT OF HONOLULU

ISLAND OF OAHU

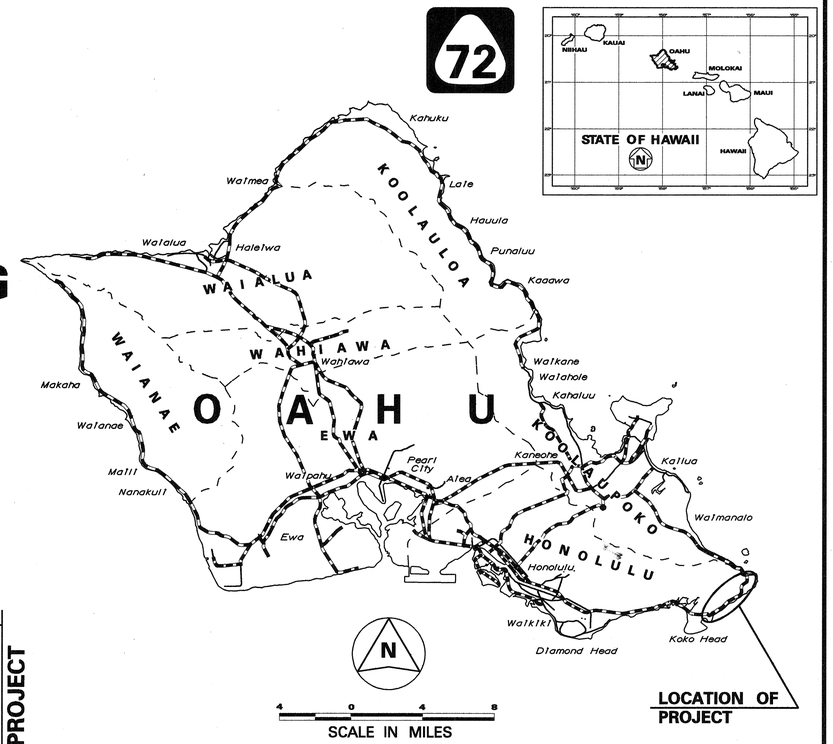

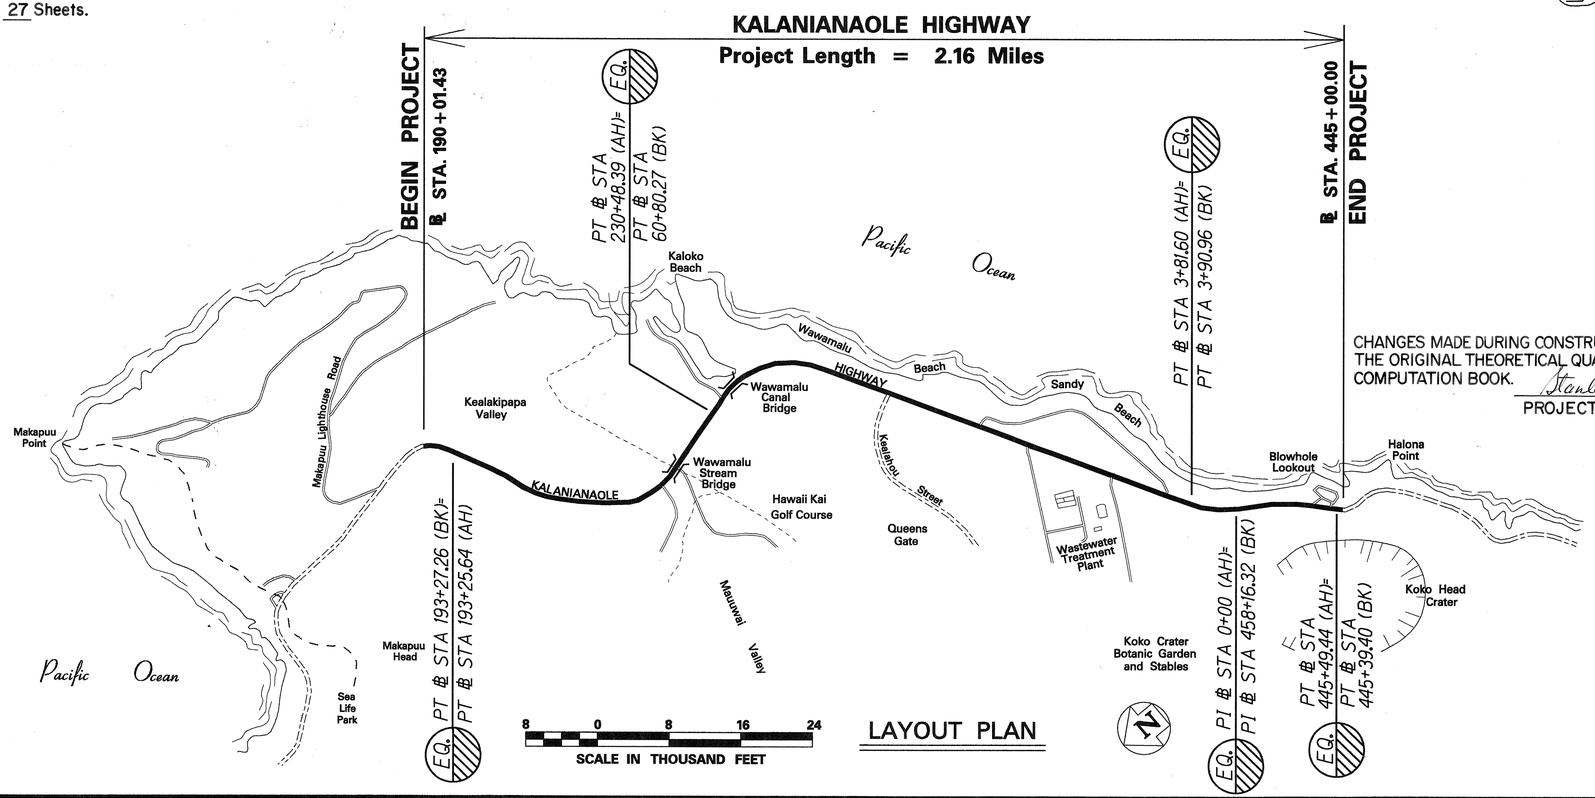

LAYOUT PLAN

FEDERAL AID PROJECTS PREVIOUSLY CONSTRUCTED OR UNDER CONSTRUCTION

MILE POST 8.92 TO MILE POST 11.07

CHANGES MADE DURING CONSTRUCTION HAVE BEEN INCORPORATED ON THESE PLANS EXCEPT CHANGES IN THE ORIGINAL THEORETICAL QUANTITIES. FOR ACTUAL QUANTITIES, REFER TO PROJECT LEDGER AND/OR COMPUTATION BOOK.

Stanley Arakaki 10/6/98

PROJECT ENGINEER DATE

DESIGN DESIGNATION

ADT (1992) 12,000
ADT (2002) 17,100
DHV 1,550
D 55/45
T ..... 4.5 %
V ..... 50 M.P.H.

DEPARTMENT OF TRANSPORTATION
STATE OF HAWAII

APPROVED:

Kenneth H. Brown 6/1/93

DIR. OF TRANSPORTATION DATE

UNIT D — DESIGNED BY
ALLAN NISHIMURA — P. S. & E. BY
587-2244 — PHONE
April, 1993 — DATE

B-1-1