INDEX TO DRAWINGS	
SHEET NO.	DESCRIPTION
2 – 74	FEDERAL-AID PROJECT NO. NH-072-1(47)
75 – 86	BOARD OF WATER SUPPLY JOB NO. 99-33

FED. ROAD DIST. NO.	STATE	FED. AID PROJ. NO.	FISCAL YEAR	SHEET NO.	TOTAL SHEETS
HAWAII	HAW.	NH-072-1(47)	1999	1	89

STATE OF HAWAII

DEPARTMENT OF TRANSPORTATION

HIGHWAYS DIVISION

HONOLULU, HAWAII

"AS-BUILT"

PLANS FOR

KALANIANAOLE HIGHWAY RESURFACING

AINAKOA AVENUE TO WEST HIND DRIVE

FEDERAL-AID PROJECT NO. NH-072-1(47)

AND

KALANIANAOLE HIGHWAY 8-INCH WATER MAIN

AINAKOA AVENUE TO LAUKAHI STREET

BOARD OF WATER SUPPLY JOB NO. 99-33

CITY AND COUNTY OF HONOLULU

DISTRICT OF HONOLULU

ISLAND OF OAHU

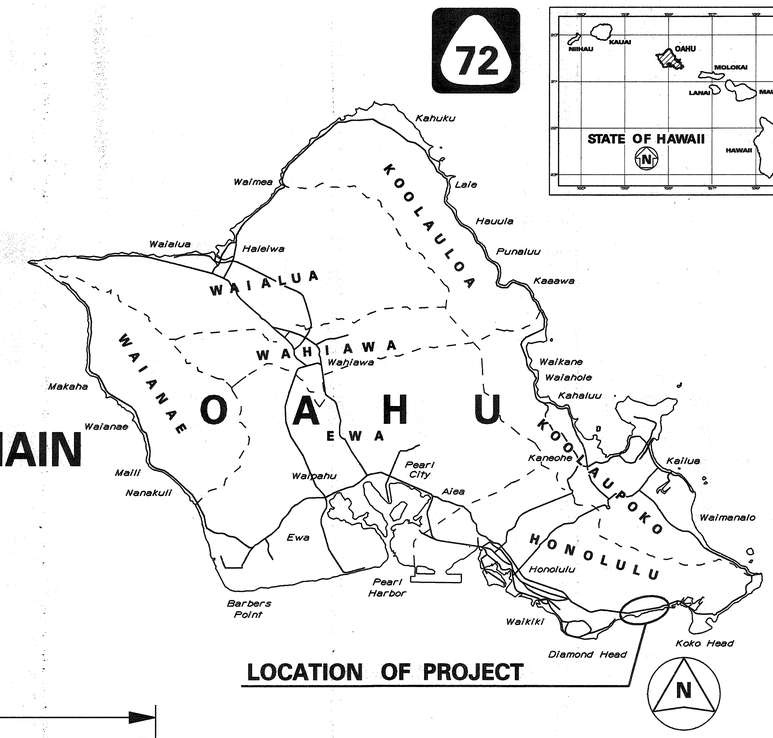

1 MILE POST 18.46 TO MILE POST 16.80

2 MILE POST 18.46 TO MILE POST 17.97

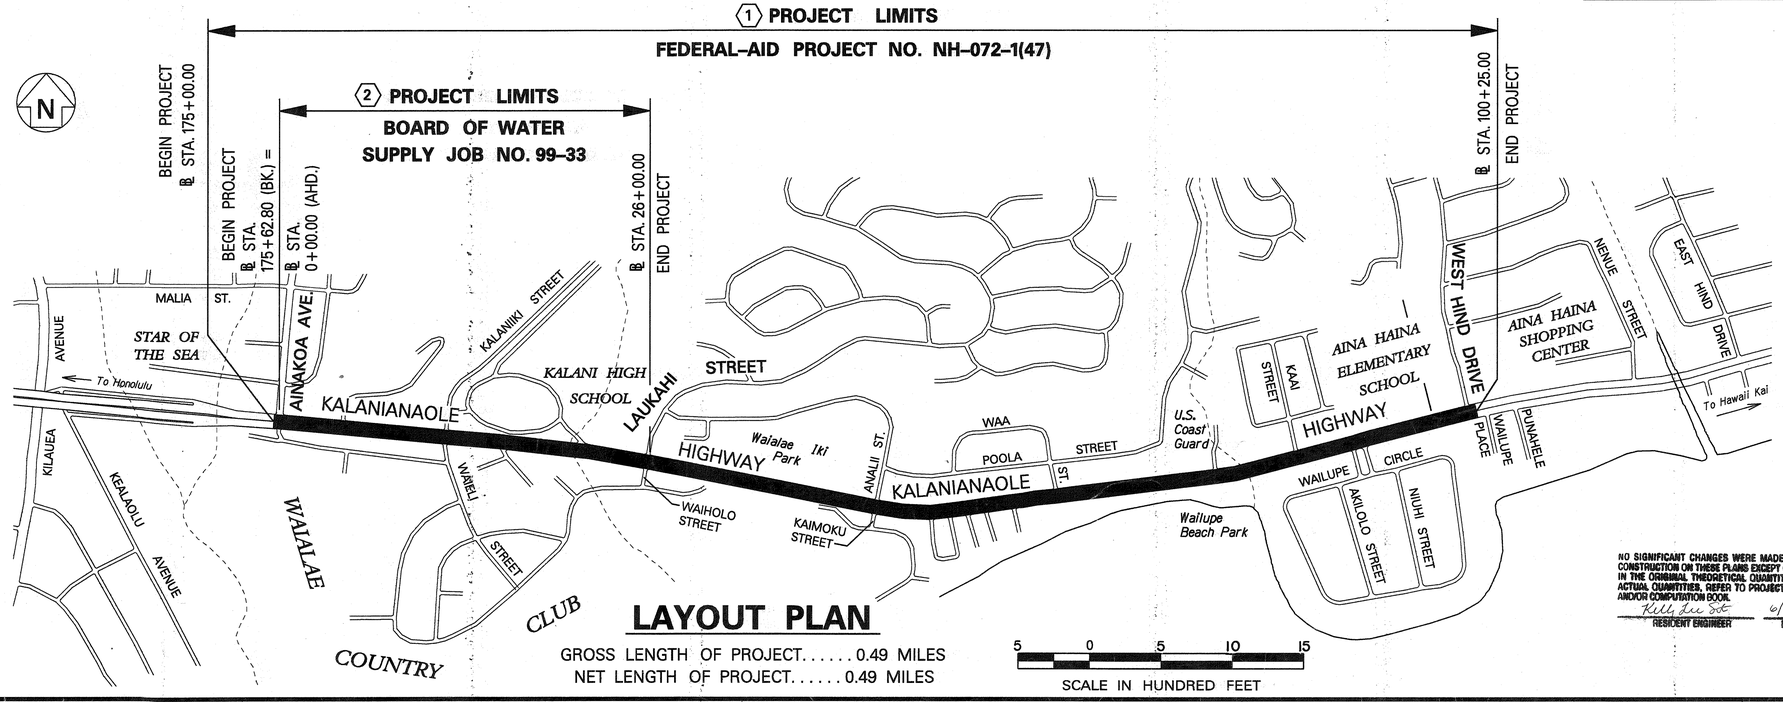

LAYOUT PLAN

GROSS LENGTH OF PROJECT..... 0.49 MILES

NET LENGTH OF PROJECT..... 0.49 MILES

NO SIGNIFICANT CHANGES WERE MADE DURING CONSTRUCTION ON THESE PLANS EXCEPT CHANGES IN THE ORIGINAL THEORETICAL QUANTITIES. FOR ACTUAL QUANTITIES, REFER TO PROJECT LEDGER AND/OR COMPUTATION BOOK.

Kelly Lee Sato 6/26/09

RESIDENT ENGINEER DATE

UNIT "E"	J. FUJIMOTO	692-7581	FEB. 1999
DESIGNED BY	P. S. & E. BY	PHONE	DATE