FED. ROAD DIST. NO.	STATE	FED. AID PROJ. NO.	FISCAL YEAR	SHEET NO.	TOTAL SHEETS
HAWAII	HAW.	NH-072-1(52)	2008	13	64

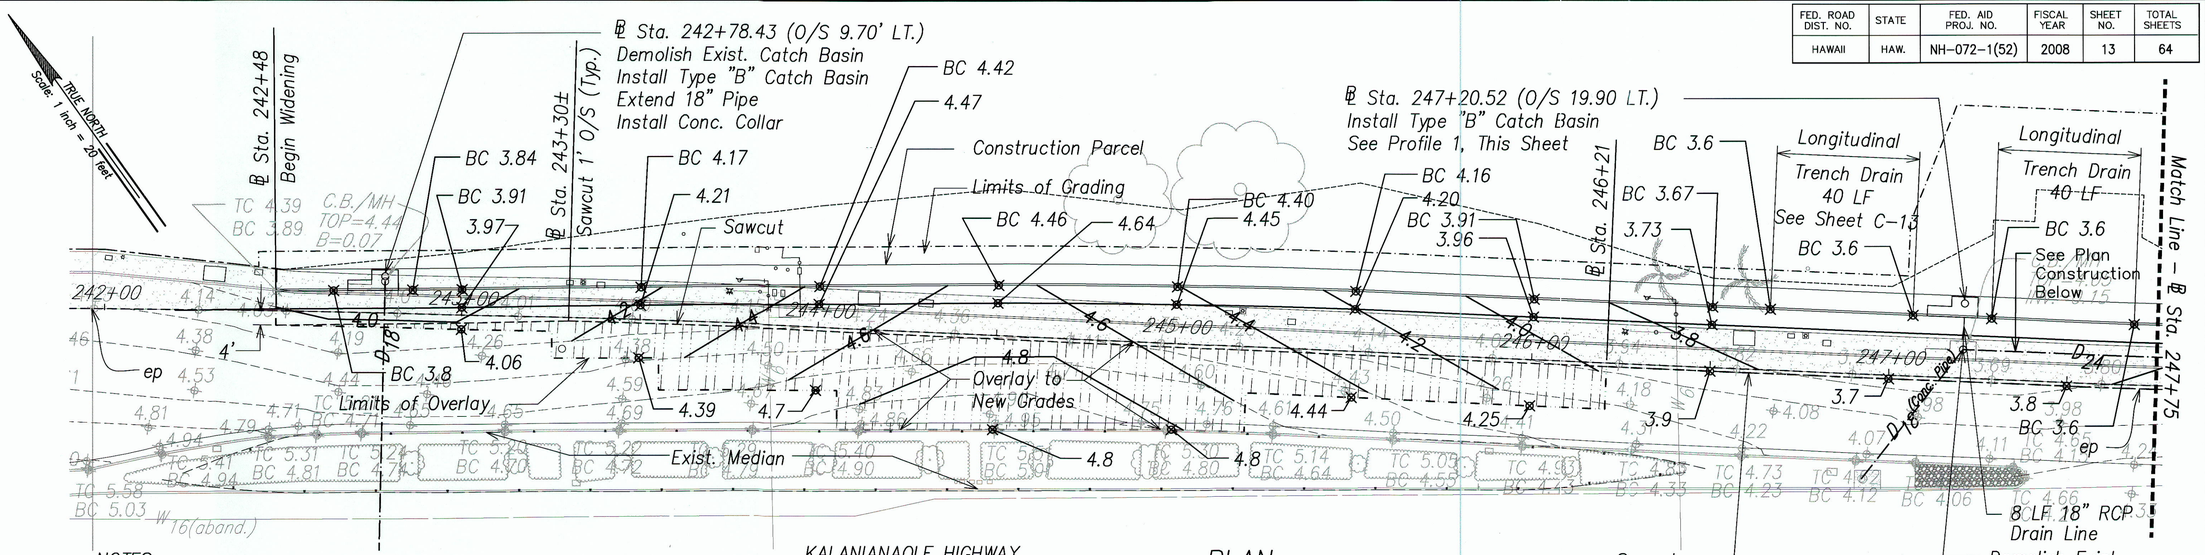

NOTES:

Prior to the start of the grading work, the Contractor shall verify the existing grades shown on the plan. Any significant deviation in grades shall be reported to the Engineer.

PLAN

Scale: 1" = 20'

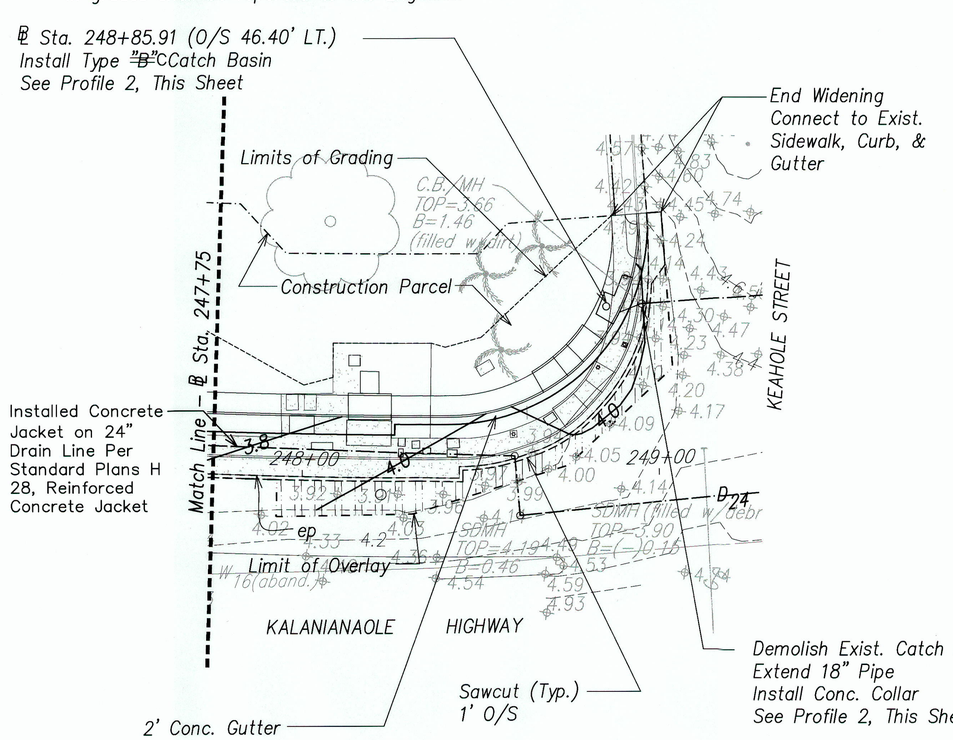

PLAN (CONTINUED)

Scale: 1" = 20'

NOTES:

See Sheet C-9 for Curb Return Grades.

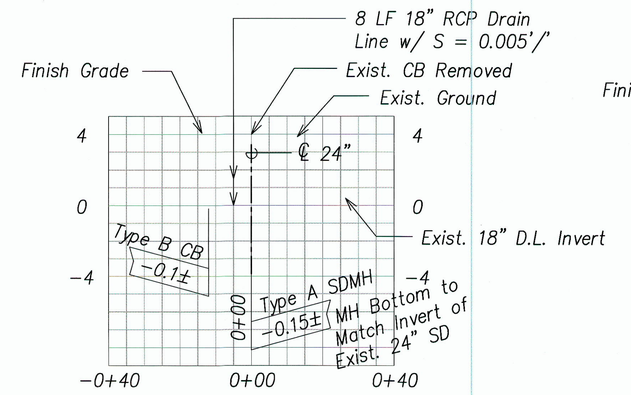

PROFILE 1

GRAPHIC SCALES IN FEET

1"=20' (H)

1"=4' (V)

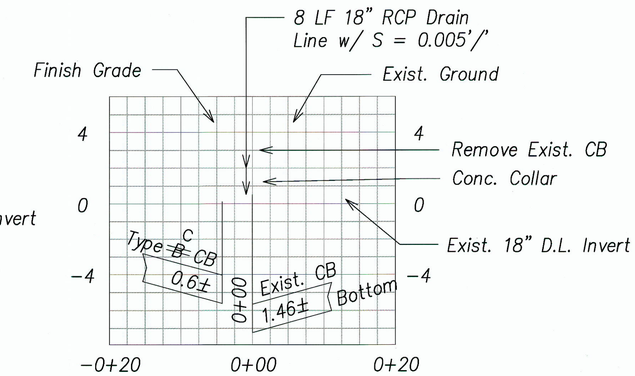

PROFILE 2

GRAPHIC SCALES IN FEET

1"=20' (H)

1"=4' (V)

LEGEND FOR AS-BUILT POSTING	
~~	Squiggly line for as-built deletion
~~100.00~~	Double line for as-built deletion
Roadway	Text for as-built posting

KENNETH O. NAGAI LICENSED PROFESSIONAL ENGINEER No. 3265-C HAWAII, U.S.A.

SIGNATURE

APRIL 30, 2010

EXPIRATION DATE OF LICENSE

THIS WORK WAS PREPARED BY ME OR UNDER MY SUPERVISION

STATE OF HAWAII
DEPARTMENT OF TRANSPORTATION
HIGHWAYS DIVISION

GRADING & DRAINAGE PLAN & PROFILES

KALANIANAOLE HIGHWAY IMPROVEMENTS
VICINITY OF HAWAII KAI DRIVE
TO KEAHOLE STREET
FEDERAL-AID PROJECT NO. NH-072-1(52)

SCALE: As Noted DATE: November 2008

SHEET No. C-8 OF 22 SHEETS

ORIGINAL PLAN	DATE
SURVEY PLOTTED BY	
SURVEY BY	
TRACED BY	
NOTE BOOK	DESIGNED BY
	QUANTITIES BY
No.	CHECKED BY

"AS-BUILT"