FED. ROAD DIST. NO.	STATE	PROJ. NO.	FISCAL YEAR	SHEET NO.	TOTAL SHEETS
HAWAII	HAW.	760B-01-71	1971	1	5

INDEX TO DRAWINGS

SHEET NO.	DESCRIPTION
1	Title Sheet
2	Plan & Details
3 - 4	Standard and Miscellaneous Details
5	Project Information Sign

STATE OF HAWAII

DEPARTMENT OF TRANSPORTATION

HIGHWAYS DIVISION

HONOLULU, HAWAII

FORT WEAVER ROAD
DEMOLISH RAILROAD OVERPASS

PROJECT Nº 760B-01-71

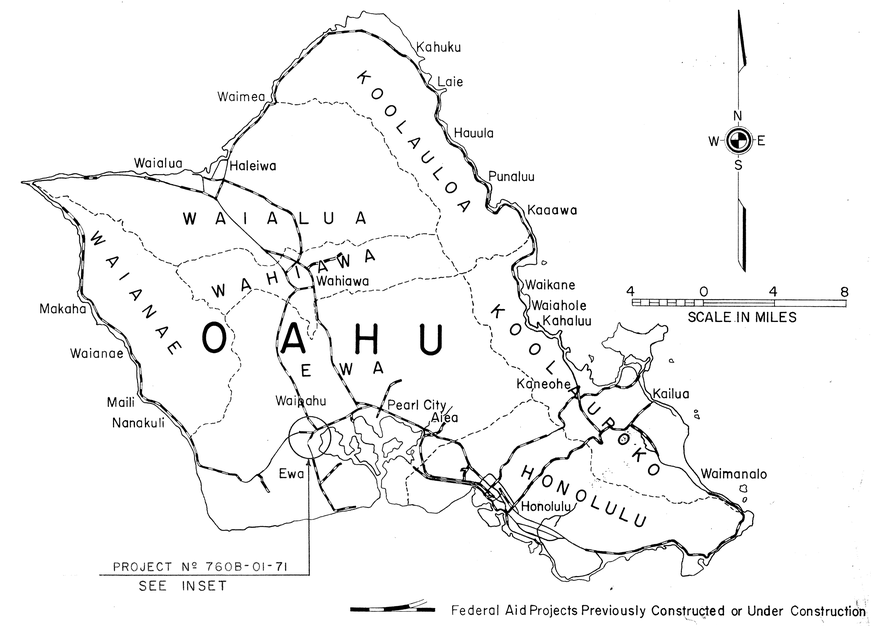

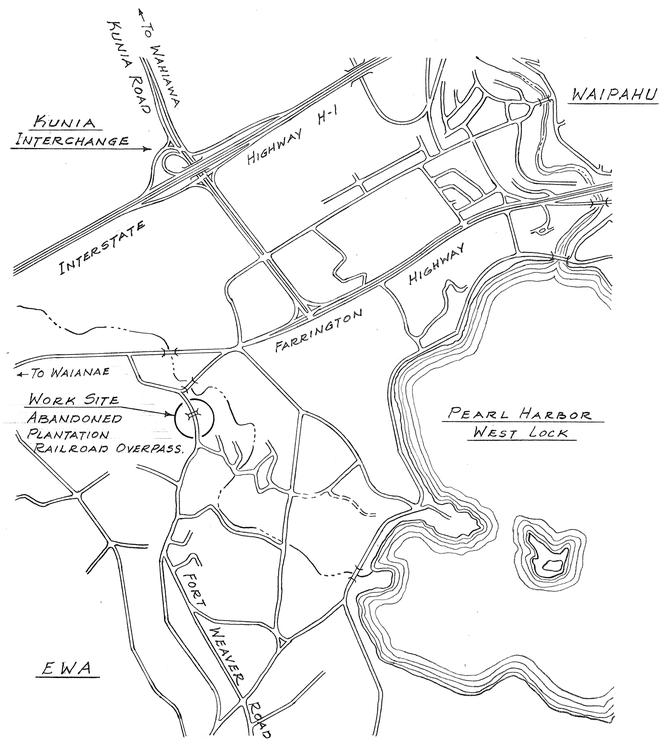

INSET

NO AS BUILT CHANGES

D. BEYER Dec. '70

DEPARTMENT OF TRANSPORTATION STATE OF HAWAII	
APPROVED:	
for E. Alvey Wright	12/31/70
DIR. OF TRANSPORTATION	DATE

C-4-4