FED. ROAD DIST. NO.	STATE	PROJ. NO.	FISCAL YEAR	SHEET NO.	TOTAL SHEETS
HAWAII	HAW.	760AB-01-72	1972	1	16

INDEX TO DRAWINGS

SHEET NO.	DESCRIPTION
1	TITLE SHEET
2	TYPICAL SECTIONS
3-5	PLANS
6-8	DITCH CROSSING DETAILS
9-11	STANDARD & MISC. DETAILS
12-16	CROSS SECTIONS

STATE OF HAWAII

DEPARTMENT OF TRANSPORTATION
HIGHWAYS DIVISION

HONOLULU, HAWAII

"AS BUILT" PLANS FOR

FORT WEAVER ROAD IMPROVEMENTS

PROJECT NO. 760AB-01-72

DISTRICT OF EWA
ISLAND OF OAHU

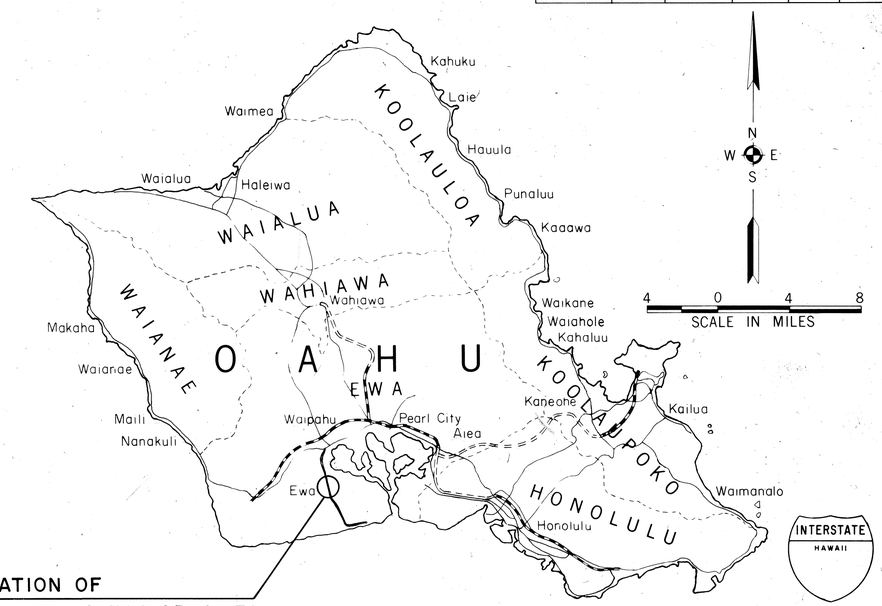

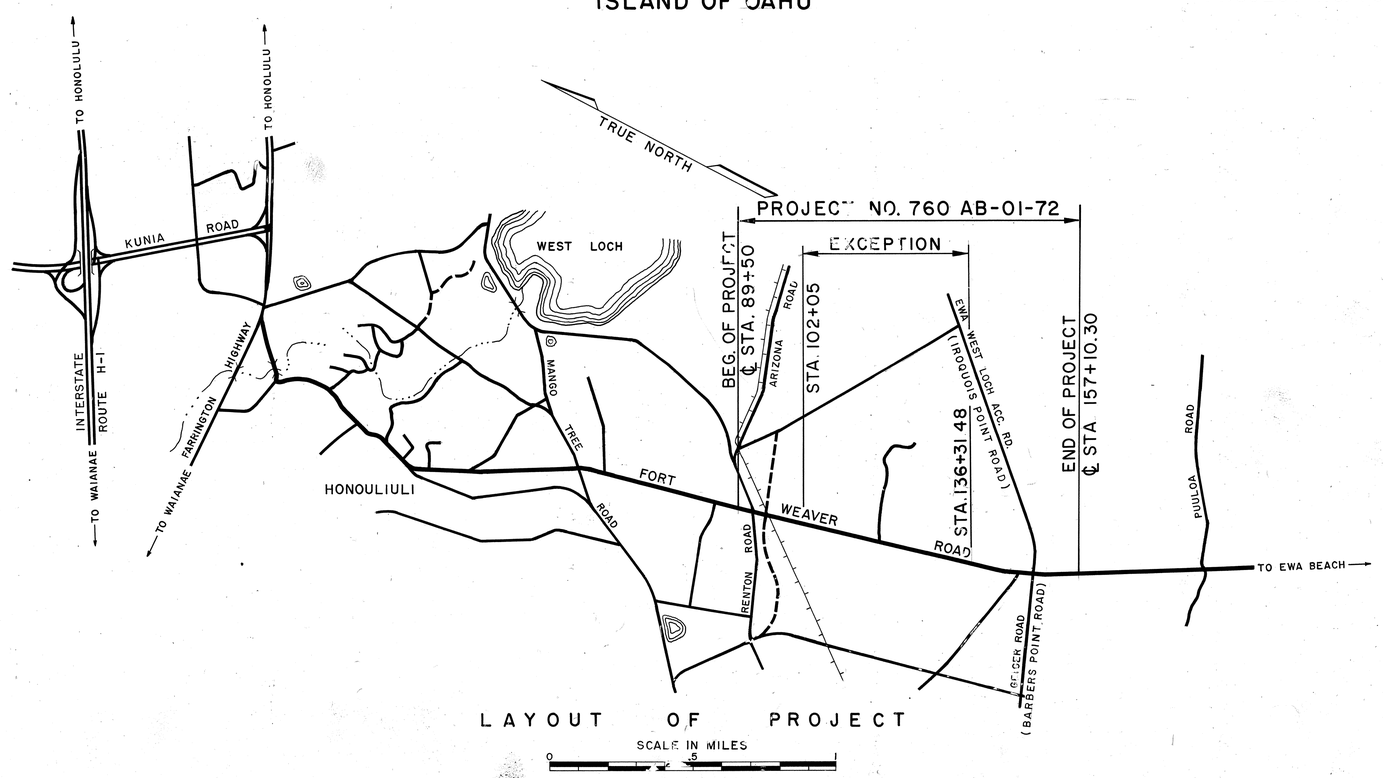

LAYOUT OF PROJECT

NOTE:
ALL CHANGES MADE DURING CONSTRUCTION HAVE BEEN NOTED IN RED ON THESE TRACINGS AND CHECKED BY:

PROJECT ENGINEER
8/3/73
DATE

DESIGNED BY	D. Bevier	PHONE	548-7537
P S & E BY	D. Bevier	DATE	February, 1972

DEPARTMENT OF TRANSPORTATION
STATE OF HAWAII

APPROVED:
DIR. OF TRANSPORTATION — DATE 1/2/72