FED. ROAD DIST. NO.	STATE	PROJ. NO.	FISCAL YEAR	SHEET NO.	TOTAL SHEETS
HAWAII	HAW.	750A-01-82M	1982	1	24

INDEX TO DRAWINGS

SHEET NO.	DESCRIPTION
1	TITLE SHEET
2-4	TYPICAL SECTIONS, GENERAL NOTES AND DETAILS
5-8	PLANS
9-11	PAVEMENT MARKING AND STRIPING PLANS
12-24	STANDARD DETAILS

STATE OF HAWAII

DEPARTMENT OF TRANSPORTATION

HIGHWAYS DIVISION

"AS-BUILT"

PLANS FOR

KUNIA ROAD RESURFACING

H-1 TOWARDS WILIKINA DRIVE

(H-1 TO VICINITY OF WAIAHOLE DITCH)

PROJECT NO. 750A-01-82M

DISTRICT OF EWA

ISLAND OF OAHU

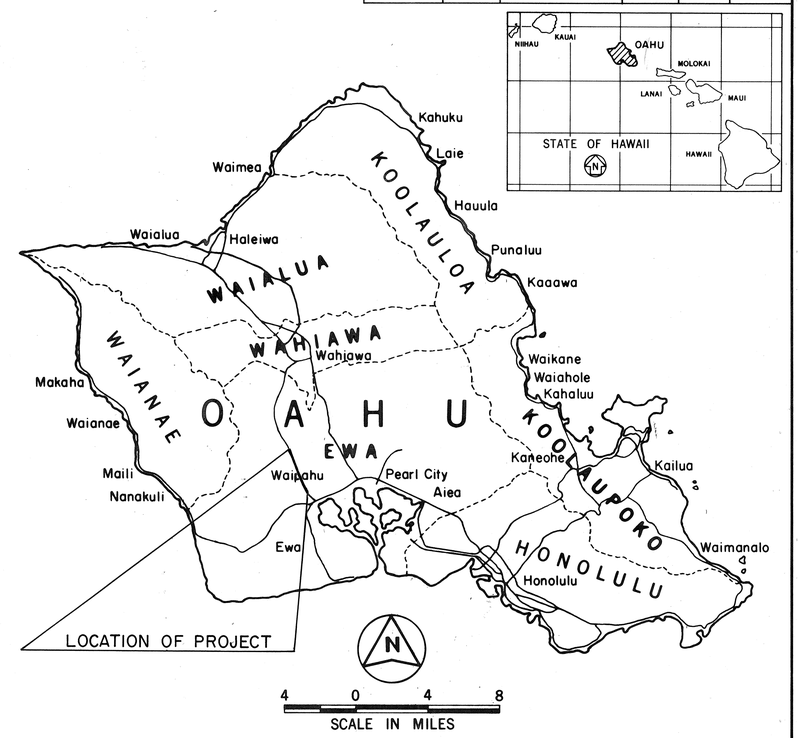

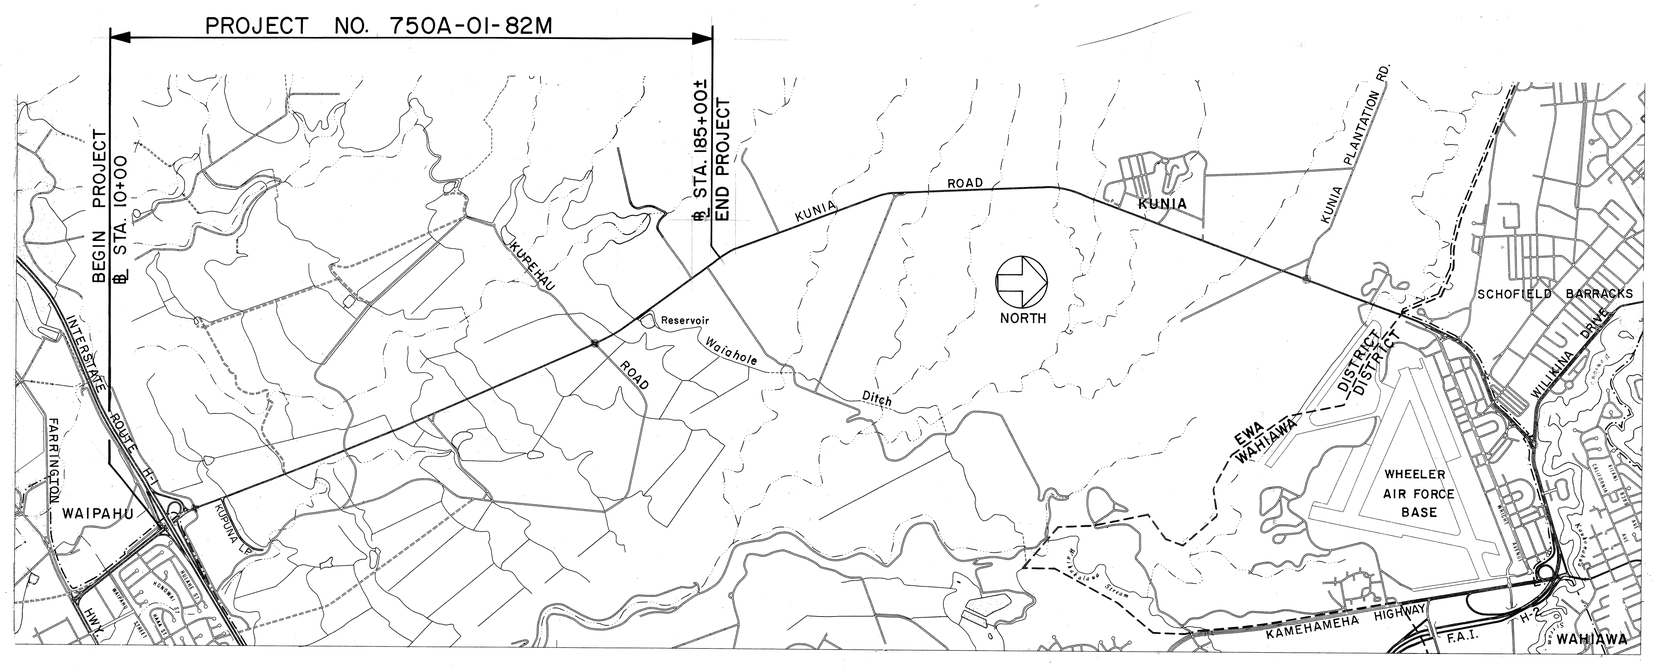

LAYOUT PLAN

GROSS LENGTH OF PROJECT . . . . 3.31 Miles

NET LENGTH OF PROJECT . . . . . 3.31 Miles

ALL CHANGES MADE DURING CONSTRUCTION HAVE BEEN INCORPORATED ON THESE PLANS IN RED EXCEPT CHANGES IN THE ORIGINAL THEORETICAL QUANTITIES. FOR ACTUAL QUANTITIES, REFER TO PROJECT LEDGER AND/OR COMPUTATION BOOK.

Ronald Kan — RESIDENT ENGINEER — 2/8/83 DATE

R. TSUZUKI DESIGNED BY	R. TSUZUKI P. S. & E. BY	548-2456 PHONE	Feb., 1982 DATE

DEPARTMENT OF TRANSPORTATION
STATE OF HAWAII

APPROVED:

James R. Carros — DIR. OF TRANSPORTATION — 2/22/82 DATE

WASH OFF FILM

DD-19-1-5