FED. ROAD DIST. NO.	STATE	PROJ. NO.	FISCAL YEAR	SHEET NO.	TOTAL SHEETS
HAWAII	HAW.	7600A-01-83M	1983	IR	23

INDEX TO DRAWINGS

SHEET NO.	DESCRIPTION
IR	TITLE SHEET
2	NOTES AND LEGEND
3	TYPICAL SECTIONS AND MISCELLANEOUS DETAILS
4	BUS PULLOUT DETAILS AND MISCELLANEOUS DETAILS
5-9S-2	ROADWAY PLANS
10-21	PAVEMENT MARKING PLANS AND DETAILS

STATE OF HAWAII

DEPARTMENT OF TRANSPORTATION

HIGHWAYS DIVISION

HONOLULU, HAWAII

"AS BUILT"
PLANS FOR

FORT WEAVER ROAD RESURFACING

VICINITY OF RENTON ROAD TOWARD MILITARY GATE

PROJECT NO. 7600A-01-83M

DISTRICT OF EWA
ISLAND OF OAHU

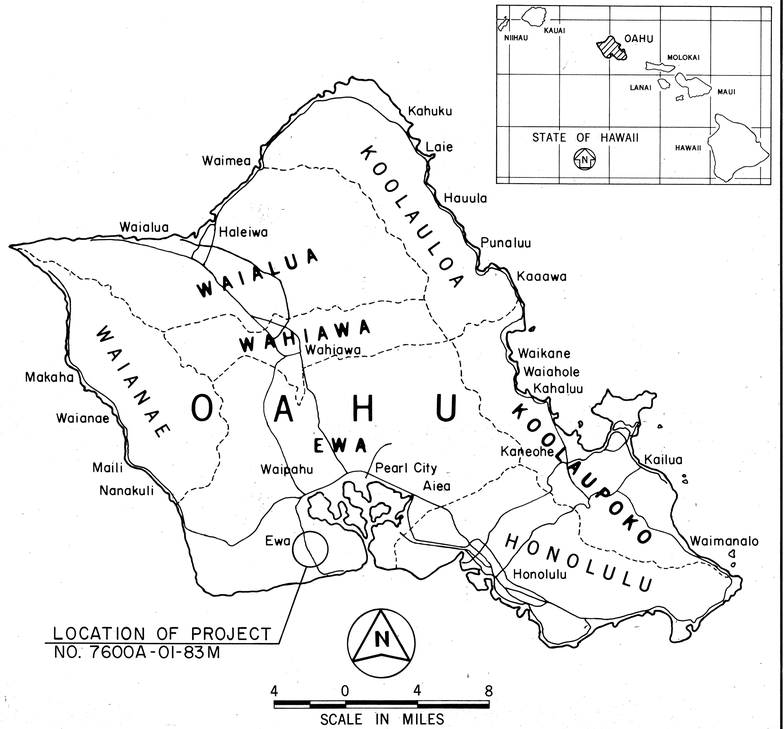

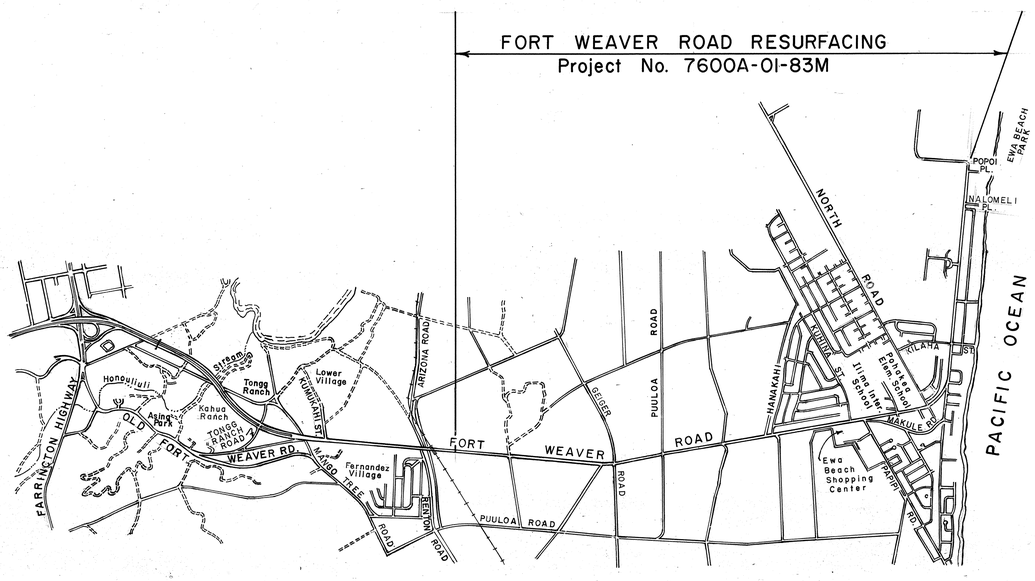

LAYOUT PLAN

0 2000 4000 6000
GRAPHIC SCALE IN FEET

LENGTH OF PROJECT . . . . . 2.557 Miles

CHANGES MADE DURING CONSTRUCTION HAVE BEEN INCORPORATED ON THESE PLANS EXCEPT CHANGES IN THE ORIGINAL THEORETICAL QUANTITIES. FOR ACTUAL QUANTITIES REFER TO PROJECT LEDGER AND/OR COMPUTATION BOOK.

Robert Omai — 10/21/83
ROBERT OMAI — DATE
RESIDENT ENGINEER

DEPARTMENT OF TRANSPORTATION
STATE OF HAWAII
APPROVED:
DIR. OF TRANSPORTATION — 1/26/89 DATE

Unit "C" — DESIGNED BY
R. Siarot — P. S. & E. BY
548-7537 — PHONE
July, 1982 — DATE

IR