INDEX TO DRAWINGS	
SHEET NO.	DESCRIPTION
1	TITLE SHEET
2	STANDARD PLANS SUMMARY
3	GENERAL NOTES AND LEGEND
① 4 – 8	DRAINAGE PLANS AND DETAILS
9	UTILITY PLAN
10	WATERLINE ADJUSTMENT DETAILS

Sheet No. ① C.O.7S-1 is a supplementary sheet to this project. Total sheet count after "AS-BUILT" posting 11 sheets.

FED. ROAD DIST. NO.	STATE	PROJ. NO.	FISCAL YEAR	SHEET NO.	TOTAL SHEETS
HAWAII	HAW.	76A-01-98	2000	1	10

STATE OF HAWAII

DEPARTMENT OF TRANSPORTATION

HIGHWAYS DIVISION

HONOLULU, HAWAII

"AS-BUILT"

PLANS FOR

FORT WEAVER ROAD

DRAINAGE IMPROVEMENTS AT RENTON ROAD AND VICINITY OF KAHUA RANCH NURSERY

PROJECT NO. 76A-01-98

DISTRICT OF EWA

ISLAND OF OAHU

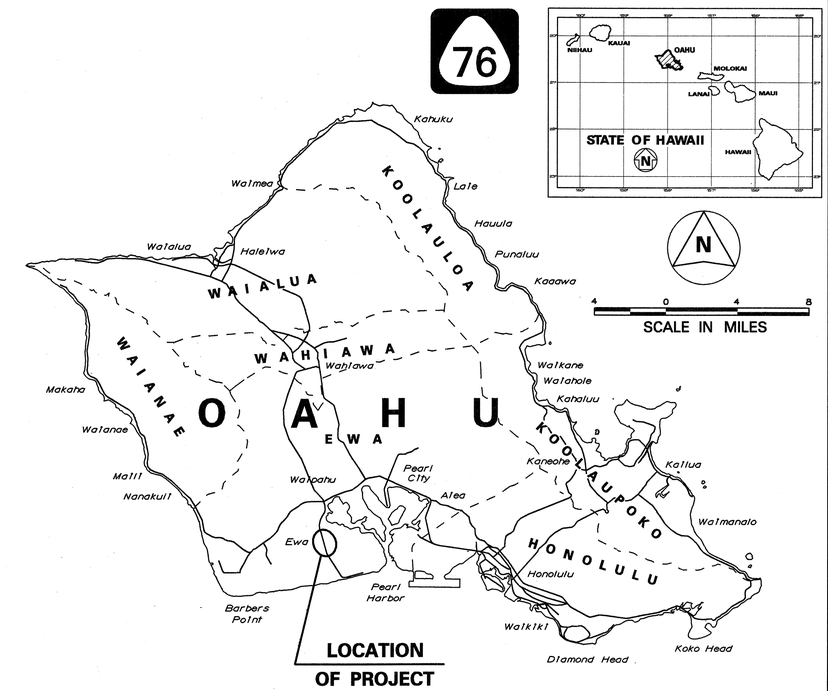

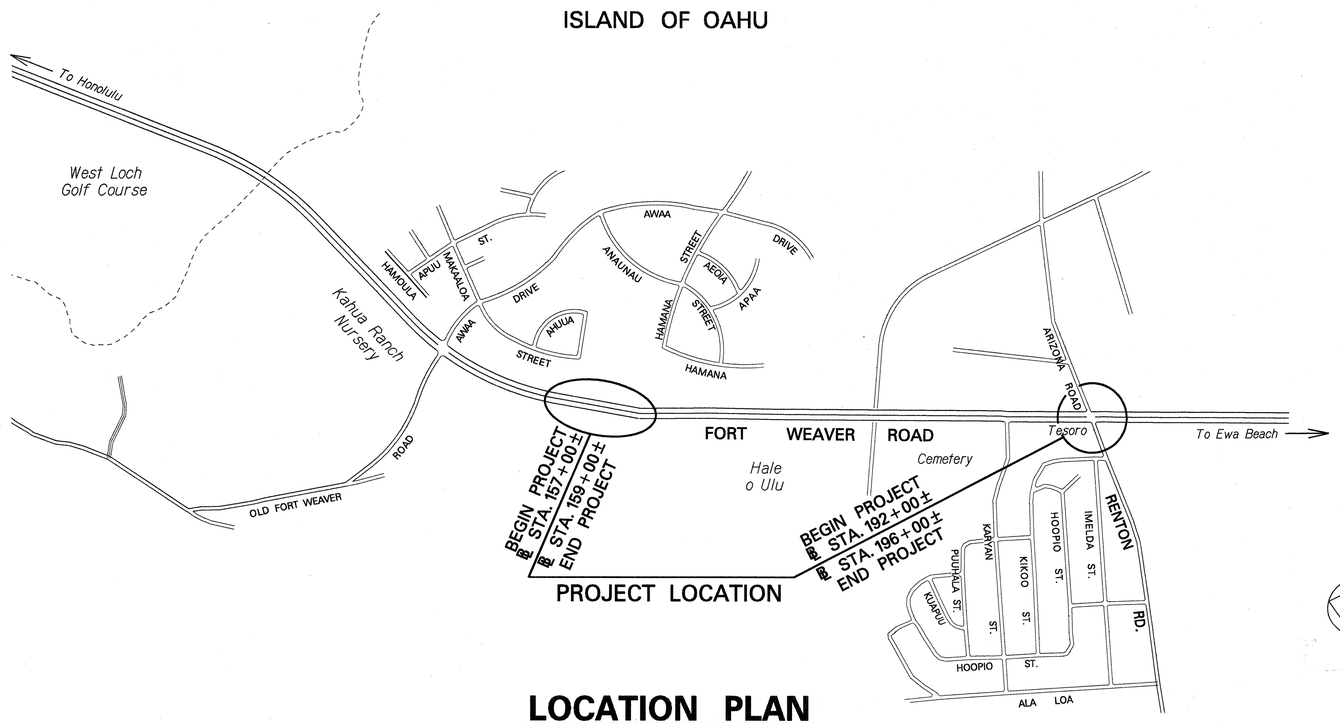

MILE POST 4.054 TO MILE POST 3.978

MILE POST 4.717 TO MILE POST 4.679

LOCATION PLAN

GROSS LENGTH OF PROJECT..... 0.114 MILES

NET LENGTH OF PROJECT..... 0.114 MILES

5 0 5 10 15

SCALE IN HUNDRED FEET

CHANGES MADE DURING CONSTRUCTION HAVE BEEN INCORPORATED ON THESE PLANS EXCEPT CHANGES IN THE ORIGINAL THEORETICAL QUANTITIES. FOR ACTUAL QUANTITIES, REFER TO PROJECT LEDGER AND/OR COMPUTATION BOOK.

RESIDENT ENGINEER — DATE 7/23/01

DEPARTMENT OF TRANSPORTATION STATE OF HAWAII	
APPROVED:	
DIR. OF TRANSPORTATION	DATE 11/2/99

HWY-DH DESIGNED BY — R. HIRONAKA P. S. & E. BY — 692-7575 PHONE — OCT. 1999 DATE

4fwrdfsht.dgn login: george r10:25:99