FED. ROAD DIST. NO.	STATE	PROJ. NO.	FISCAL YEAR	SHEET NO.	TOTAL SHEETS
HAWAII	HAW.	HWY-0-01-04	2004	1	61

STATE OF HAWAII

DEPARTMENT OF TRANSPORTATION

HIGHWAYS DIVISION

HONOLULU, HAWAII

"AS-BUILT"

PLANS FOR

KUNIA ROAD IMPROVEMENTS

VICINITY OF SOUTH KUPUNA LOOP TO VICINITY OF HONOWAI STREET

PROJECT NO. HWY-0-01-04

DISTRICT OF EWA

ISLAND OF OAHU

INDEX TO DRAWINGS

SHEET NO.	DESCRIPTION
1	TITLE SHEET
2	STANDARD PLANS SUMMARY
3 – 6	GENERAL NOTES & LEGEND
7 – 8	WATER POLLUTION & EROSION CONTROL NOTES
9	TYPICAL SECTIONS
• 10 – 14	DETAILS
15 – 20	CURB RAMP & SIDEWALK NOTES & DETAILS
21 – 25	ROADWAY PLANS
26 – 29	PAVEMENT GRADE PLANS
30 – 32	INTERSECTION GRADING PLANS
33 – 36	STRUCTURAL PLANS & NOTES
37 – 42	DRAINAGE PLANS, NOTES & DETAILS
43 – 45	CONSTRUCTION PHASING PLANS
46 – 53	PAVEMENT MARKING, SIGNING & STRIPING PLANS
• 54 – 61	TRAFFIC SIGNAL PLANS & NOTES

Sheet Nos. ADD.14 S-1 & ADD.54 S-1 & 42S-1 are supplementary sheets to this project.

Total sheet count after "AS-Built" postings is ~~63~~ 64 sheets.

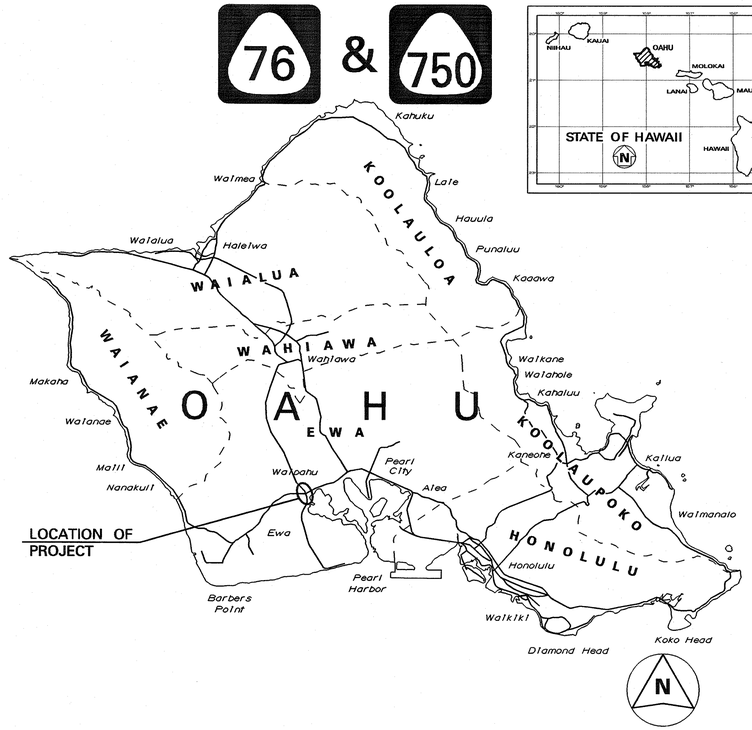

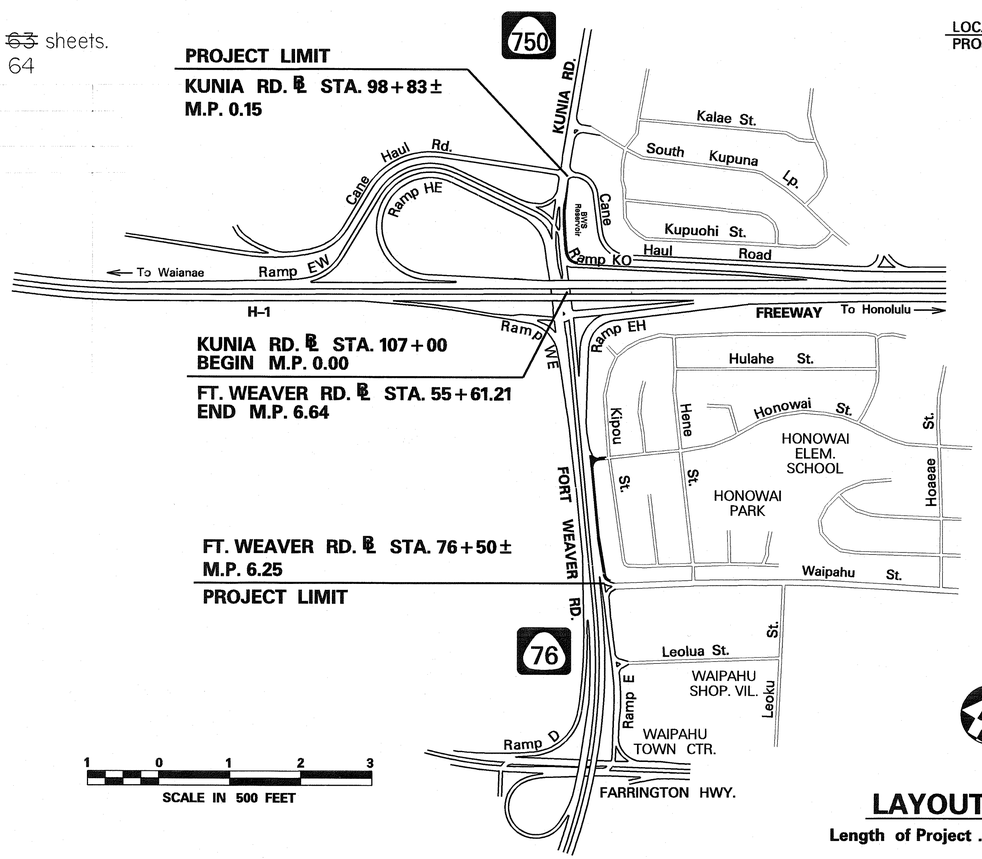

LAYOUT PLAN

Length of Project ..... 0.54 MI.

4 0 4 8

SCALE IN MILES

FORT WEAVER ROAD M.P. 6.25 TO M.P. 6.64

KUNIA ROAD M.P. 0.00 TO M.P. 0.15

CHANGES MADE DURING CONSTRUCTION HAVE BEEN INCORPORATED ON THESE PLANS EXCEPT CHANGES IN THE ORIGINAL THEORETICAL QUANTITIES. FOR ACTUAL QUANTITIES, REFER TO PROJECT LEDGER AND/OR CONSTRUCTION BOOK.

RESIDENT ENGINEER — DATE 7/23/09

DEPARTMENT OF TRANSPORTATION
STATE OF HAWAII

APPROVED:

12-16-03

DIR. OF TRANSPORTATION — DATE

HWY-D DESIGNED BY	HWY-DD MANAGED BY
692-7570 PHONE	DEC 2003 DATE