FED. ROAD DIST. NO.	STATE	FEDERAL AID PROJ. NO.	FISCAL YEAR	SHEET NO.	TOTAL SHEETS
HAWAII	HAW.	CMAQ-076-1(9)	2006	56	58

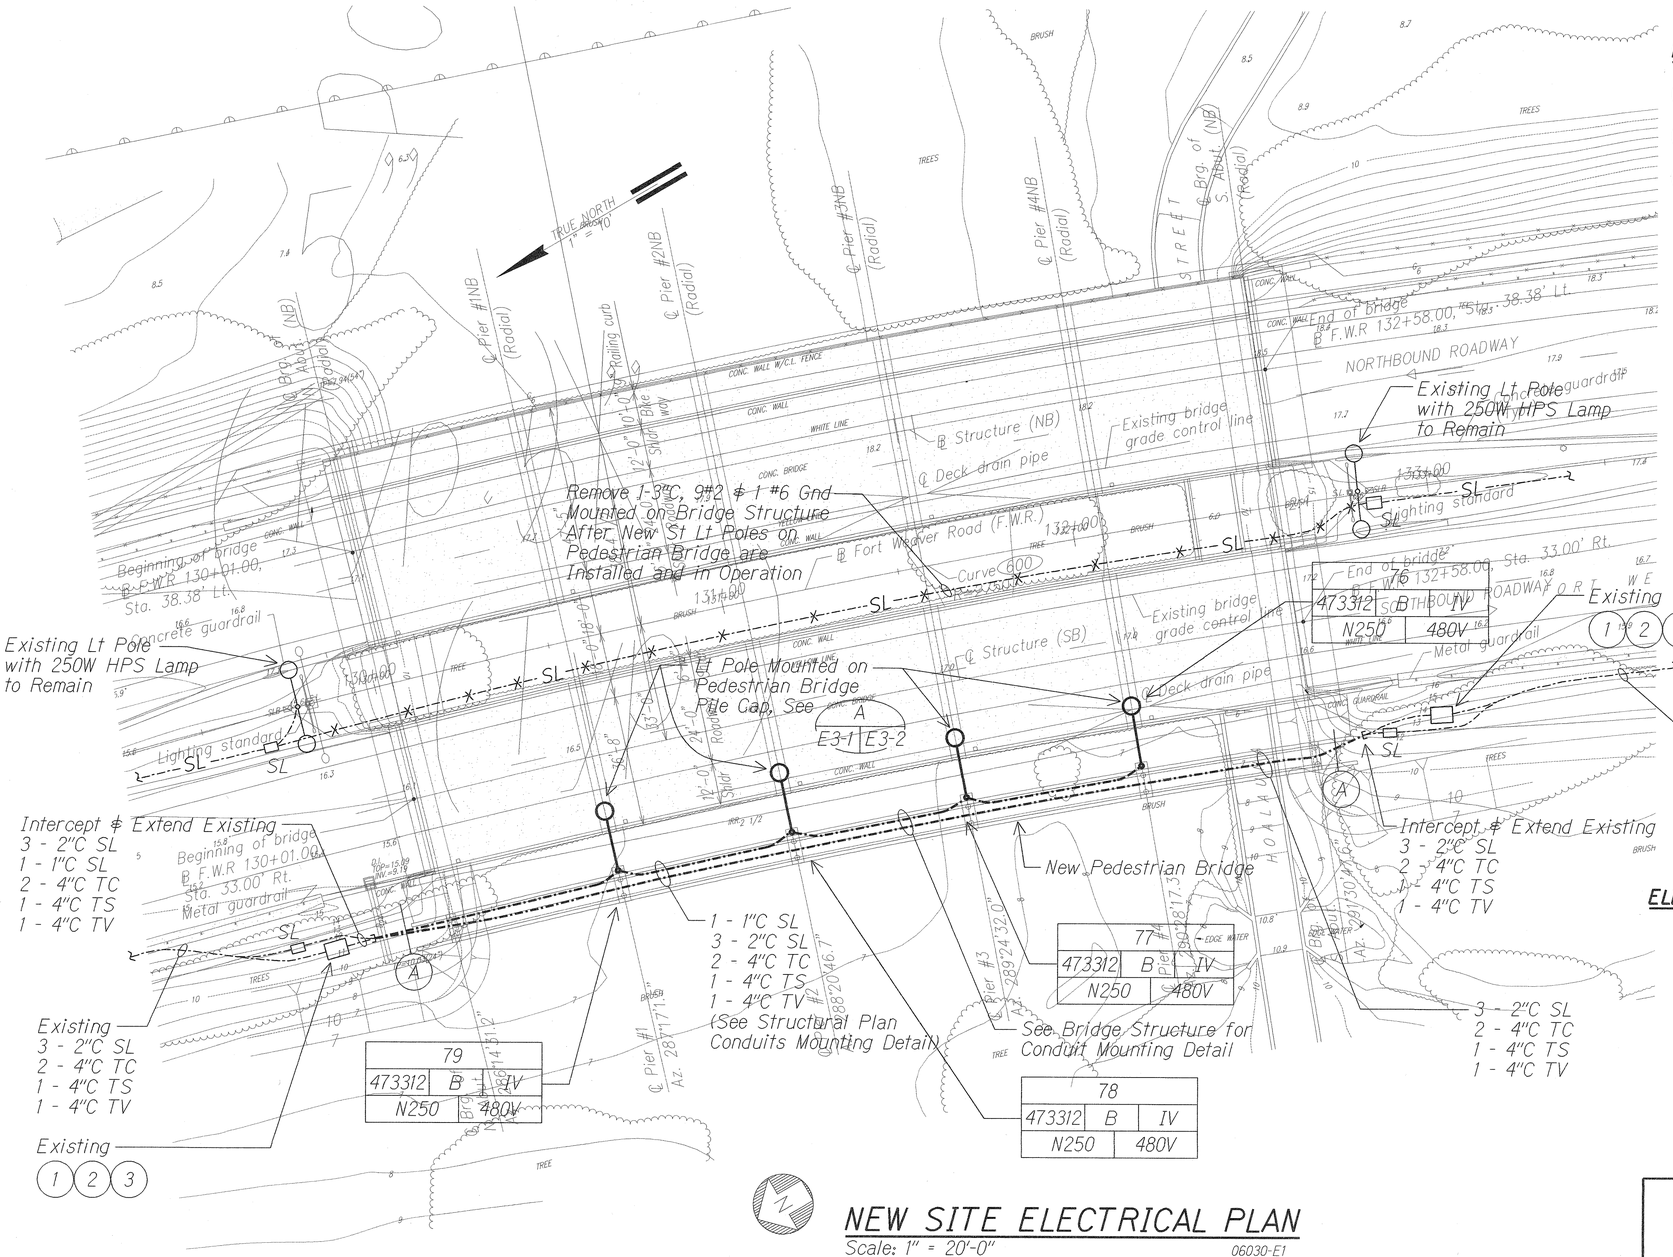

NOTES:

1. Traffic Signal Pullbox - 2'x4' Pb (Type C)
2. State Telcom - 2'x4' Pb (Type C)
3. CCTV - 2'x4' Pb (Type C)

TS - Traffic Signal System

TC - State Telecommunication System

TV - City Traffic Camera System (Provide 3 ea 1-1/4" Inner Ducts In New 4" TV Conduit - Use 1 Innerduct For New FO Cable)

□ - Ltg Pb - Type B (28"x39")
SL

ELECTRICAL SYMBOLS

- Roadway Light Aluminum Pole, Single Luminaire, 250W HPS, +33' Mtg Ht. See Detail on Sht E3-2
- **SL** Street Light Conduit
- Conduits Mounted on Bridge Structure

NEW SITE ELECTRICAL PLAN

Scale: 1" = 20'-0" 06030-E1

Light lines denote existing condition.
Bold lines denote new work.

ORIGINAL PLAN	SURVEY PLOTTED BY	DATE
	DRAWN BY	
	TRACED BY	
NOTE BOOK	DESIGNED BY	
	QUANTITIES BY	
No.	CHECKED BY	

R.C. KATAHARA LICENSED PROFESSIONAL ENGINEER No. 3181-E HAWAII, U.S.A.
4/3/08

MK ENGINEERS, LTD.
LICENSE EXPIRATION DATES 4/30/08
THIS WORK WAS PREPARED BY ME OR UNDER MY SUPERVISION.

STATE OF HAWAII
DEPARTMENT OF TRANSPORTATION
HIGHWAYS DIVISION

SITE ELECTRICAL PLAN

FORT WEAVER ROAD WIDENING
VICINITY OF AAWA DRIVE TO GEIGER ROAD

Scale: 1"=20'-0" Date: May 2006

SHEET No. E3-1 OF 3 SHEETS

...\Phase3\06030-E3-1.dgn 4/2/2008 2:46:45 PM