FED. ROAD DIST. NO.	STATE	FED. AID PROJ. NO.	FISCAL YEAR	SHEET NO.	TOTAL SHEETS
HBNBII	HBW.	DANR(20)	1944	1	12

INDEX TO DRAWING

SHEET NO.	DESCRIPTIONS
1	Title Sheet
2	Typical Sections
3-10	Plan and Profile
11-12	Standard Details

TERRITORY OF HAWAII
TERRITORIAL HIGHWAY DEPARTMENT
HONOLULU, T.H.

PLANS OF
KIMOPELEKANE ROAD
HAWAII PROJECT NO. DA-NR 12 (1)

EWA DISTRICT
ISLAND OF OAHU

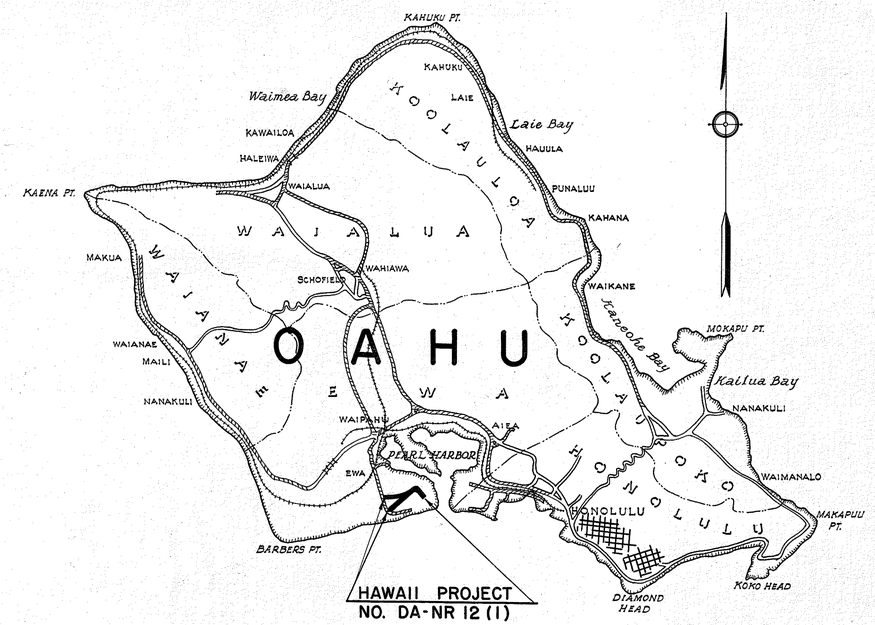

Federal Aid Projects previously constructed or under construction.

CONVENTIONAL SIGNS

Present Road
Existing Fence
Boundary Line
Center Line

SCALES

PLAN ..... 1 INCH = 100 FEET
PROFILE ..... HORIZ. 1 INCH = 100 FEET / VERT. 1 INCH = 10 FEET
CROSS SECTIONS .....

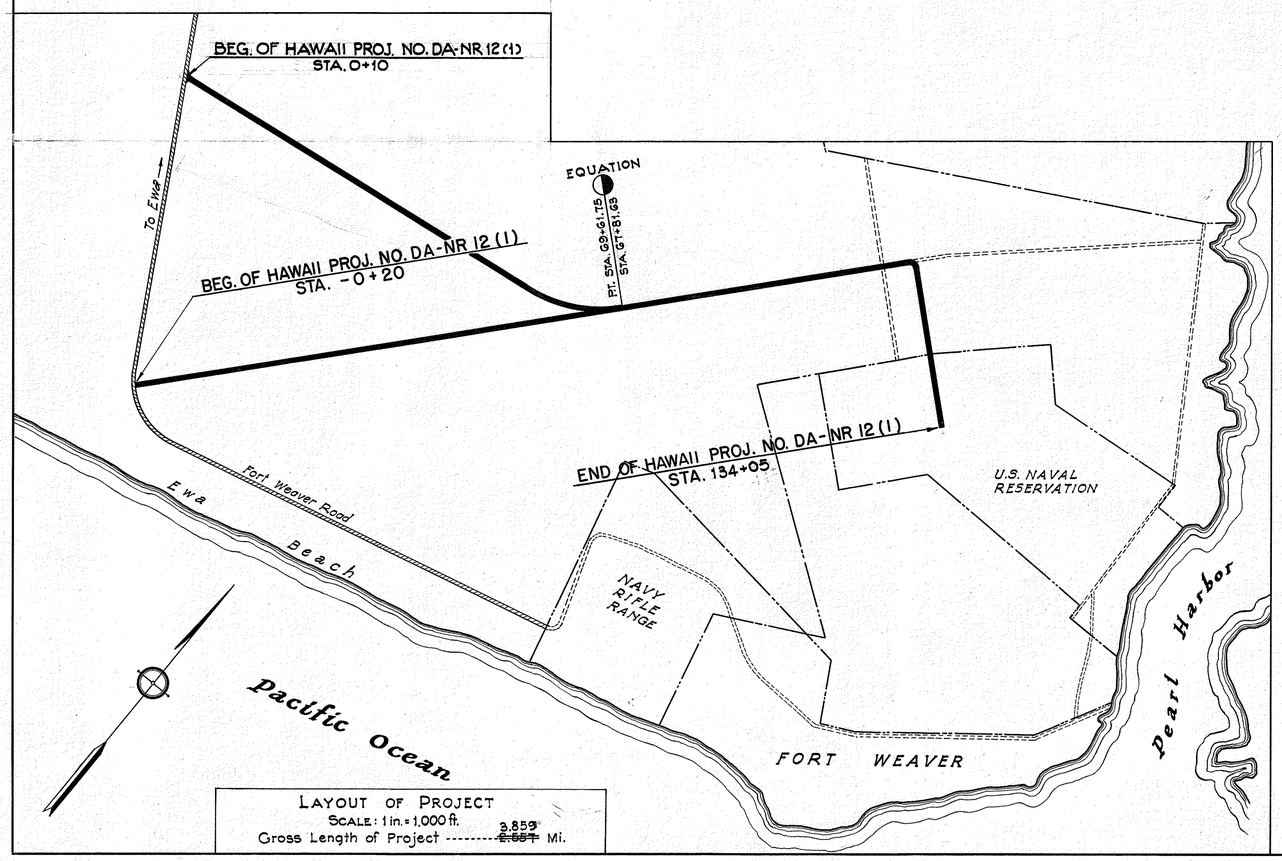

LAYOUT OF PROJECT
SCALE: 1 in. = 1,000 ft.
Gross Length of Project ..... ~~2.557~~ 3.859 Mi.

ORIGINAL PLAN		DATE
	SURVEY PLOTTED BY	
	DESIGNED BY	" "
	DRAWN BY	" "
	TRACED BY	" "
NOTE BOOK	QUANTITIES BY	" "
	QUANTITIES CHECKED BY	" "
No.	CHECKED BY	" "

RECOMMENDED FOR APPROVAL
DISTRICT ENGINEER
PUBLIC ROADS ADMINISTRATION
FEDERAL WORKS AGENCY

RECOMMENDED FOR APPROVAL
CHIEF WESTERN REGION
PUBLIC ROADS ADMINISTRATION
FEDERAL WORKS AGENCY

APPROVED

APPROVED
TERRITORIAL HIGHWAY ENGINEER
DATE:

APPROVED
COMMISSIONER
PUBLIC ROADS ADMINISTRATION
FEDERAL WORKS AGENCY

SHEET NO. OF SHEETS

5133.1

K & E CO., N.Y.
"IMPERIAL" TRACING CLOTH
PRINTED ON