FED. ROAD DIST. NO.	STATE	FED. AID PROJ. NO.	FISCAL YEAR	SHEET NO.	TOTAL SHEETS
HAWAII	HAW.	S 19(2)	1948	1	19

TERRITORY OF HAWAII

TERRITORIAL HIGHWAY DEPARTMENT

HONOLULU - T. H.

PLANS OF

MOANALUA ROAD

FEDERAL AID SECONDARY PROJECT NO. S 19(2)

HONOLULU DISTRICT, ISLAND OF OAHU

INDEX TO DRAWINGS

SHEET NO.	DESCRIPTION
1	Title Sheet
2	Typical Sections
3-5	Plan & Profile
6-7	Intersection Details
8-10	Standard Details
11-19	Cross Sections

SCALES

PLAN		1 INCH = 50 FEET
PROFILE	HOR.	1 INCH = 50 FEET
	VER.	1 INCH = 5 FEET
CROSS SECTIONS	HOR.	1 INCH = 10 FEET
	VER.	1 INCH = 10 FEET

CONVENTIONAL SIGNS

- Centerline
- Boundary Lines, or
- Fences (Noted), or
- Existing Roadway
- Circular Conc. Culvert
- Railroad
- Telephone Pole — T.P.
- Electric Power Line Pole — E.P.
- Sewer Manhole — S.M.H.
- Telephone Manhole — T.M.H.
- Fire Hydrant — F.H.
- Water Valve — W.V.
- Water Manhole — W.M.H.
- St'd Conc. Roll Curb
- Water Main — W
- Gasoline Pipe Line — G
- Communication Cable
- Warning & Regulatory Signs — (Type)
- Centerline Monument

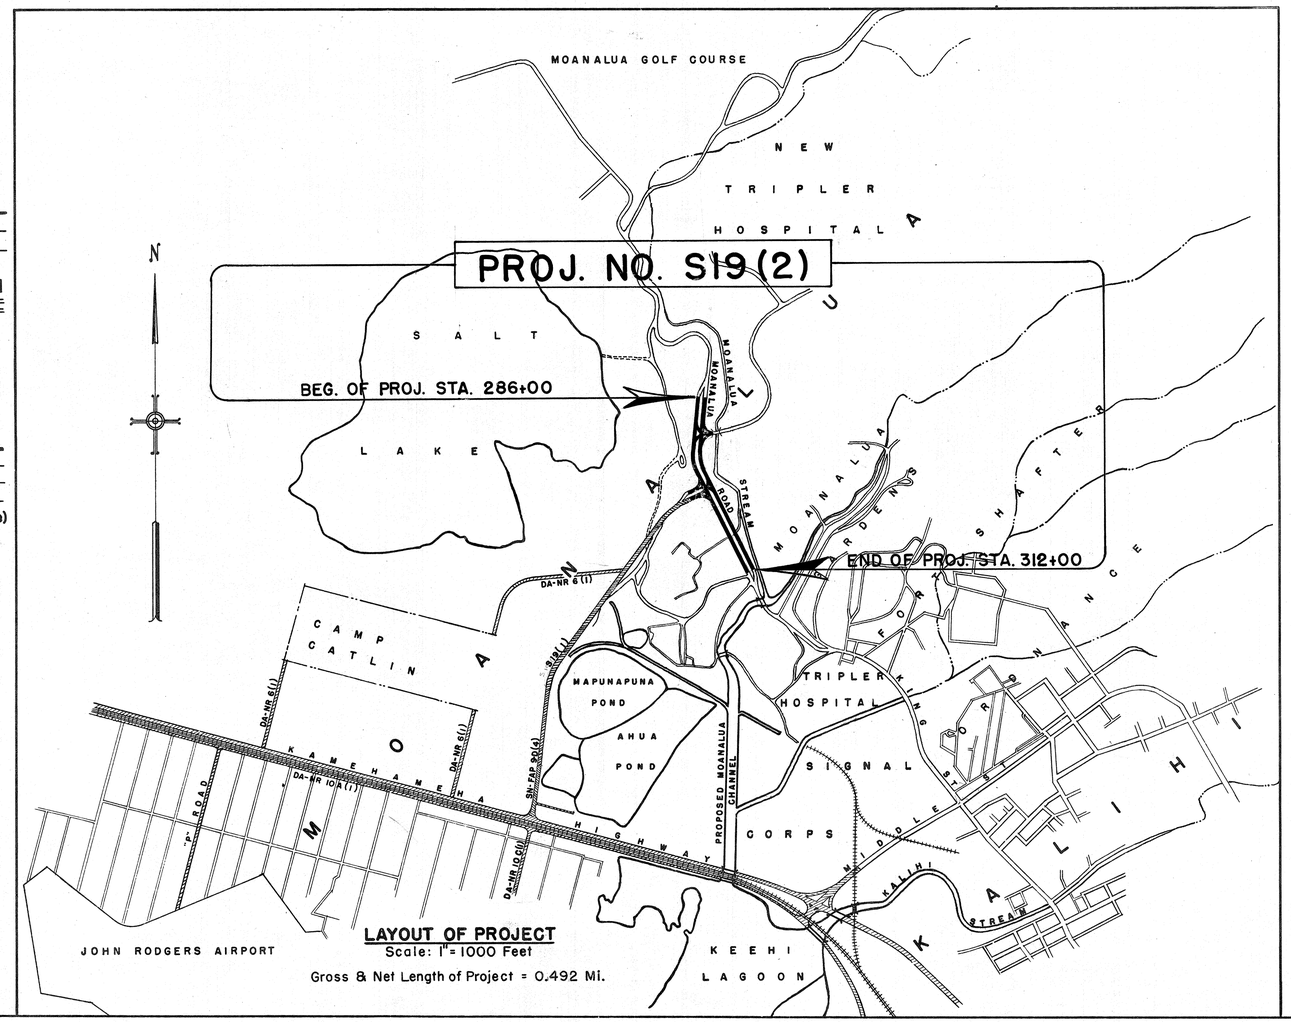

LAYOUT OF PROJECT
Scale: 1" = 1000 Feet

Gross & Net Length of Project = 0.492 Mi.

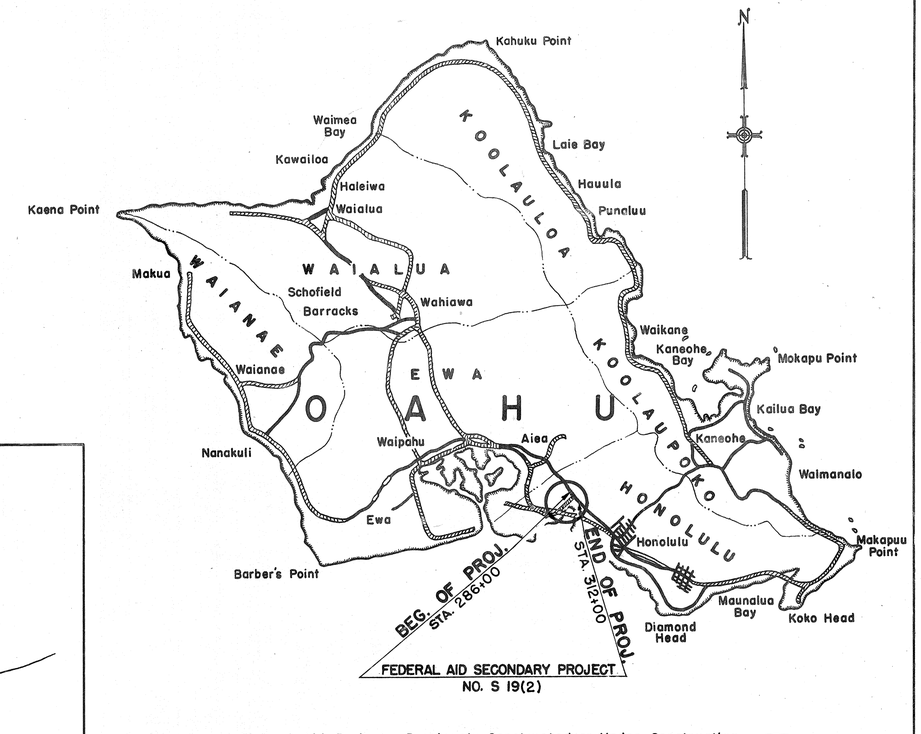

Federal Aid Projects Previously Constructed or Under Construction

SHEETS 5329.19A TO 5329.19G INCLUSIVE ARE CROSS-SECTIONS TAKEN AFTER THIS PROJECT WAS CLEARED AND GRUBBED AND SHOWS "AS-BUILT" SECTIONS.

ALL CHANGES MADE DURING CONSTRUCTION HAVE BEEN NOTED ON THESE TRACINGS AND CHECKED BY:

K. Y. Chang
Project Engineer
March 21, 1949

APPROVED: DATE May 26, 1948

TERRITORIAL HIGHWAY ENGINEER

RECOMMENDED FOR APPROVAL: DATE

DISTRICT ENGINEER
PUBLIC ROADS ADMINISTRATION
FEDERAL WORKS AGENCY

APPROVED: DATE

DIVISION ENG'NEER
PUBLIC ROADS ADMINISTRATION
FEDERAL WORKS AGENCY

ORIGINAL PLAN	SURVEY PLOTTED BY	DATE
	DESIGNED BY	
	DRAWN BY	
	TRACED BY	
NOTE BOOK	QUANTITIES BY	
No.	QUANTITIES CHECKED BY	
	CHECKED BY	

5329.1