FED. ROAD DIST. NO.	STATE	PROJ. NO.	FISCAL YEAR	SHEET NO.	TOTAL SHEETS
HAWAII	HAW.	78A-01-02M	2002	13R	92

PAVEMENT MARKING SUMMARY

DESCRIPTION	QUANTITY
PAVEMENT MARKERS	
TYPE A	120 EA.
TYPE C	48 EA.
TYPE D	5 EA.
TYPE H	26 EA.
TAPE - TYPE I OR THERMOPLASTIC EXTRUSION	
8-INCH PAVEMENT STRIPE (WHITE)	250 L.F.
4-INCH PAVEMENT STRIPE (WHITE)	140 L.F.
DOUBLE 4-INCH PAVEMENT STRIPE (YELLOW)	180 L.F.
TAPE - TYPE II OR THERMOPLASTIC EXTRUSION	
4-INCH PAVEMENT STRIPE (WHITE)	178 L.F.
4-INCH PAVEMENT STRIPE (YELLOW)	1030 L.F.
8-INCH PAVEMENT STRIPE (WHITE)	210 L.F.
TAPE - TYPE III OR THERMOPLASTIC EXTRUSION	
4-INCH PAVEMENT STRIPE (WHITE)	167 L.F.
12-INCH PAVEMENT STRIPE (WHITE)	344 L.F.
PAVEMENT ARROW	16 EA.
PAVEMENT WORD	2 EA.

REFLECTOR MARKER SUMMARY

TYPE	QUANTITY			
	W/FLEXIBLE POST	W/STEEL POST	W/BRACKET MOUNTED ON CONC. BARRIER	MTD. ON NEW UTILITY POLE
RM-2 (WHITE)				
RM-2 (YELLOW)				
RM-3 (YELLOW)				
RM-4				
RM-9				
TYPE II OBJECT MARKER				46
TOTAL				46

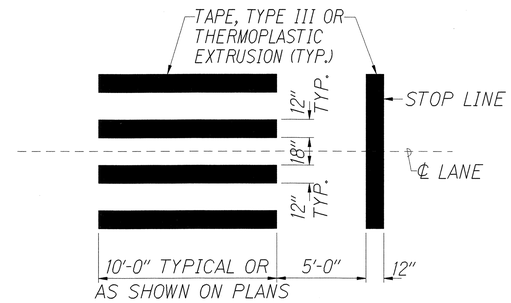

CROSSWALK STRIPING DETAIL
SCALE: 1/4" = 1'-0"

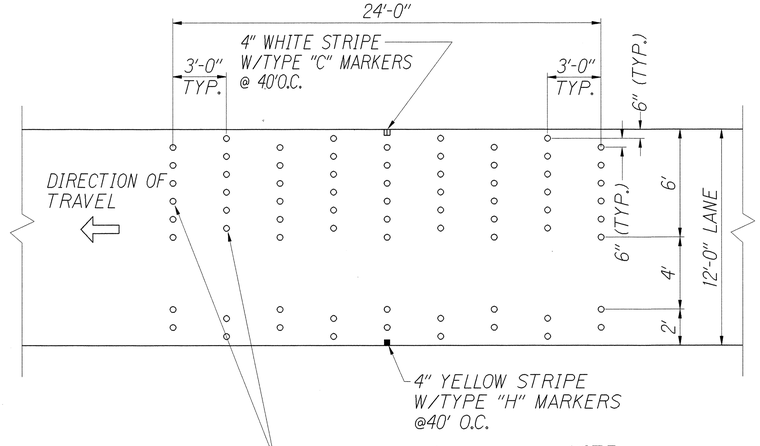

NOTE:
RUMBLE STRIP WILL BE PAID UNDER ITEM NO. 629.2010-TYPE A PAVEMENT MARKERS

RUMBLE STRIP DETAIL
SCALE: 1/4" = 1'-0"

DATE	REVISION
6-5-02	Revise quantities per Addendum No. 1 as follows: 1. Pavement Marker Type C from "53 EA" to "48 EA". 2. Tape - Type I or Thermoplastic Extrusion 8-inch pavement stripe (white) from "525 LF to "250 LF". 3. Tape - Type III or Thermoplastic Extrusion pavement word from "23 EA" to "2 EA". Add Item: Tape - Type I or Thermoplastic Extrusion 4-inch Pavement stripe (white) 140 LF.

JON K. NISHIMURA
LICENSED PROFESSIONAL ENGINEER
No. 4920-C
HAWAII, USA

THIS WORK WAS PREPARED BY ME OR UNDER MY SUPERVISION.

FUKUNAGA & ASSOCIATES, INC.

STATE OF HAWAII
DEPARTMENT OF TRANSPORTATION
HIGHWAYS DIVISION

TRAFFIC SUMMARIES AND DETAILS

MOANALUA FREEWAY LIGHTING IMPROVEMENTS
KAMEHAMEHA HIGHWAY TO HI HALAWA INTERCHANGE
PROJ. NO. 78A-01-02M
Oahu, Hawaii

Scale: As Noted Date: March 2002

SHEET No. C-8 OF 23 SHEETS

ORIGINAL PLAN | SURVEY PLOTTED BY | DRAWN BY | TRACED BY | DESIGNED BY | QUANTITIES BY | CHECKED BY | DATE
NOTE BOOK No. C-5007.001