INDEX TO DRAWINGS	
SHEET NO.	DESCRIPTION
1	TITLE SHEET
2	STANDARD PLANS SUMMARY
3 – 4	GENERAL NOTES AND LEGEND
5 – 6	WATER POLLUTION & EROSION CONTROL NOTES
7 – 8	TYPICAL SECTIONS
9 – 11	ROADWAY PLANS
12	BRIDGE JOINT REPAIR DETAILS
13	PAVEMENT MARKING LEGEND, DETAILS & NOTES
14	LOW SPEED DIVIDED HIGHWAY WORKZONE SIGNING PLAN, NOTES & DETAILS
15 – 17	PAVEMENT MARKING & STRIPING PLAN
18	LANDSCAPE NOTES & DETAILS

STATE OF HAWAII

DEPARTMENT OF TRANSPORTATION

HIGHWAYS DIVISION

HONOLULU, HAWAII

"AS-BUILT"

PLANS FOR

MOANALUA FREEWAY RESURFACING

MILE POST 0.00 to MILE POST 0.74

PROJECT NO. HWY-O-05-05M

DISTRICT OF EWA

ISLAND OF OAHU

FED. ROAD DIST. NO.	STATE	PROJ. NO	FISCAL YEAR	SHEET NO.	TOTAL SHEETS
HAWAII	HAW.	HWY-O-05-05M	2010	1	18

78

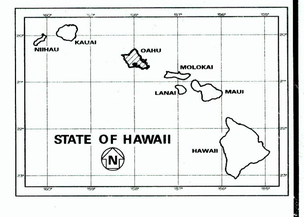

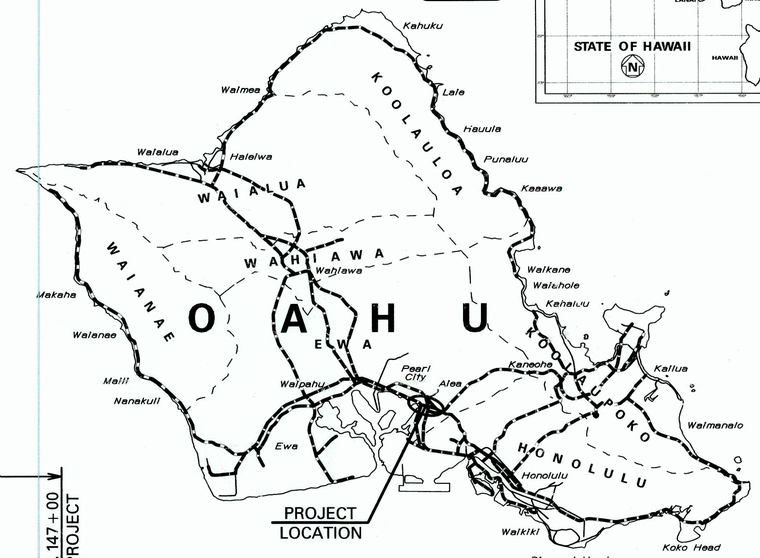

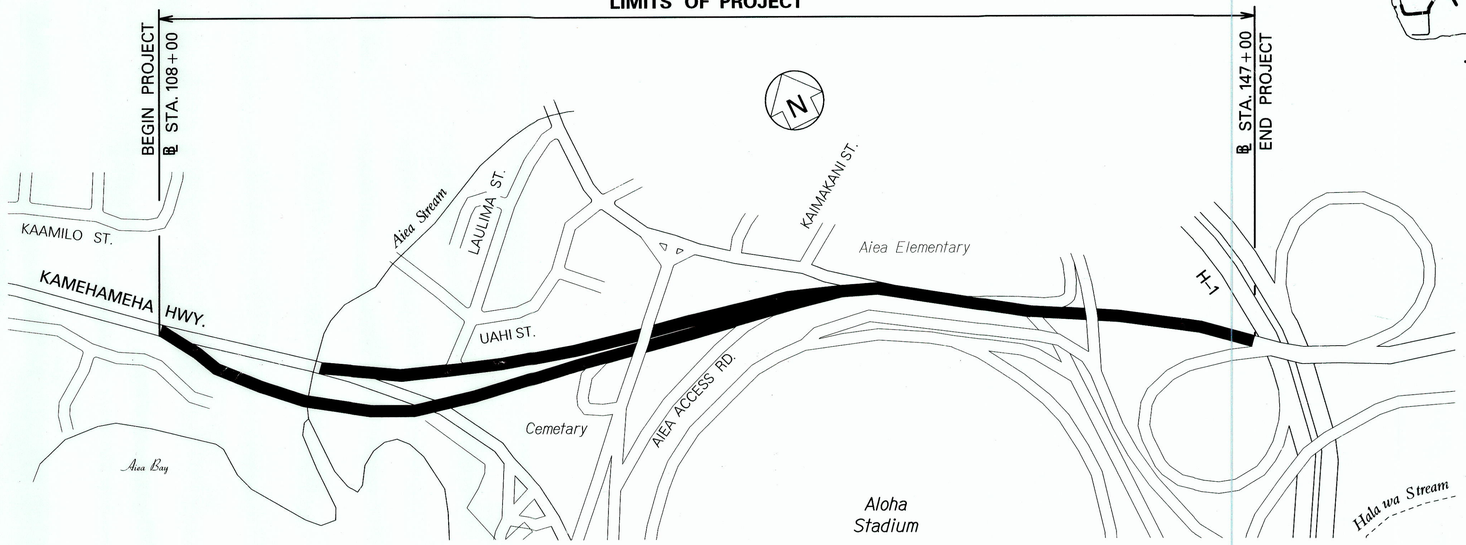

LAYOUT PLAN

GROSS LENGTH OF PROJECT..... 0.74 MILES

NET LENGTH OF PROJECT..... 0.74 MILES

250 0 250 500 1000

SCALE IN HUNDRED FEET

4 0 4 8

SCALE IN MILES

MILE POST 0.00 TO MILE POST 0.74

CHANGES MADE DURING CONSTRUCTION HAVE BEEN INCORPORATED ON THESE PLANS EXCEPT CHANGES IN THE ORIGINAL THEORETICAL QUANTITIES. FOR ACTUAL QUANTITIES, REFER TO PROJECT LEDGER AND/OR COMPUTATION BOOK.

RESIDENT ENGINEER — DATE 04/16/2014

DEPARTMENT OF TRANSPORTATION
STATE OF HAWAII

APPROVED:

DIR. OF TRANSPORTATION — DATE 5/11/10

HWY-DD DESIGNED BY

HWY-DD MANAGED BY

692-7570 PHONE

APRIL 2010 DATE