| FED. ROAD DIST. NO. | STATE | PROJ. NO. | FISCAL YEAR | SHEET NO. | TOTAL SHEETS |
|---|---|---|---|---|---|
| HAWAII | HAW. | B-80-01-65 | 1966 | 1 | 6 |

| INDEX TO DRAWINGS | |
|---|---|
| SHEET NO. | DESCRIPTION |
| 1 | TITLE SHEET |
| 2 | TYPICAL SECTION AND DETAIL PLAN OF ROADWAY |
| 3 - 5 | DRAINAGE DETAILS |
| 6 | CROSS SECTIONS |

STATE OF HAWAII
DEPARTMENT OF TRANSPORTATION
HIGHWAYS DIVISION
HONOLULU, HAWAII

"AS BUILT" PLANS OF

# WIDENING OF A PORTION OF KAMEHAMEHA HIGHWAY

(CALIFORNIA AVENUE TOWARD KARSTEN THOT BRIDGE)

PROJECT NO. B-80-01-65

**DISTRICT OF WAHIAWA**
**ISLAND OF OAHU**

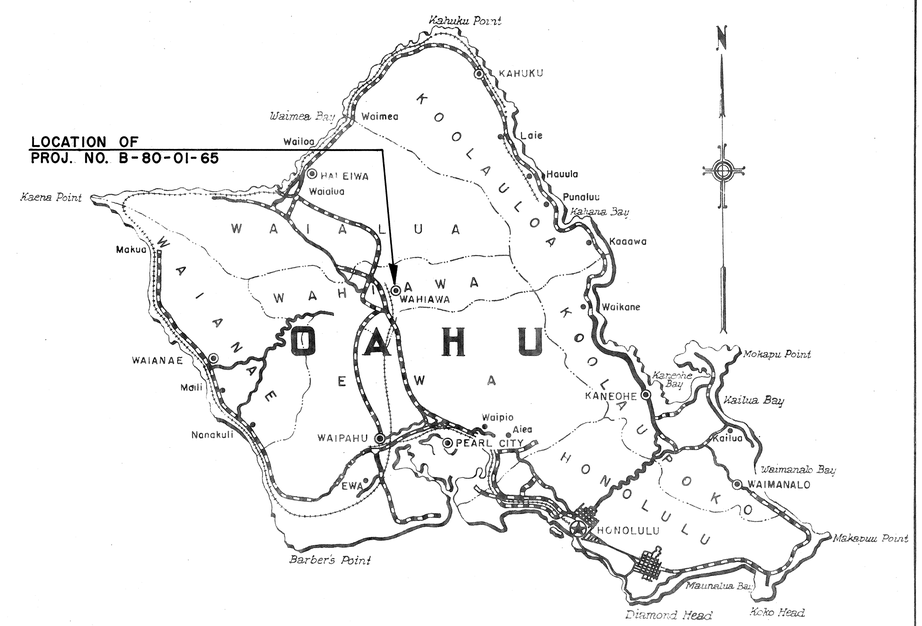


Federal Aid Projects Previously Constructed Or Under Construction

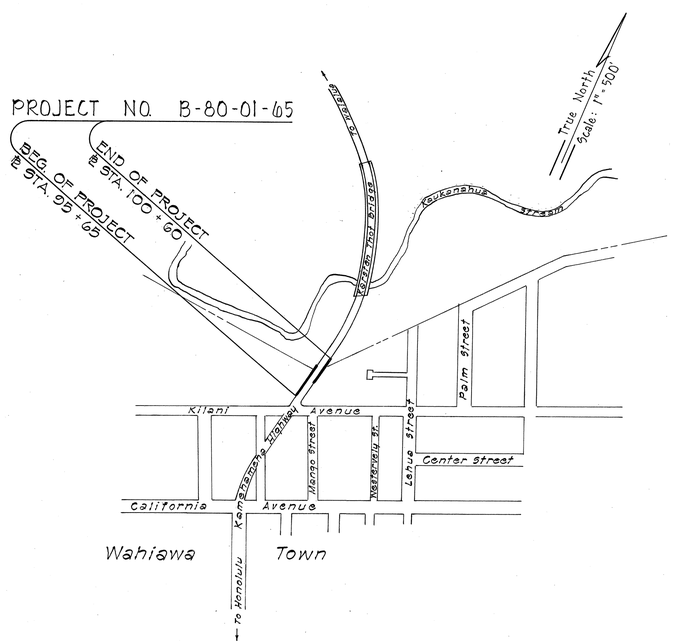


**LOCATION PLAN**

## NOTE:

ALL CHANGES MADE DURING CONSTRUCTION HAVE BEEN NOTED IN RED ON THESE TRACINGS AND CHECKED BY:

Sally E Nishiki
PROJECT ENGINEER

6/1/67
DATE

APPROVED DATE 2-16-66

for John Mel Lee
DIRECTOR OF TRANSPORTATION

| | | | |
|---|---|---|---|
| ORIGINAL PLAN | SURVEY PLOTTED BY | R. Terada | DATE June '66 |
| | DESIGNED BY | | |
| | DRAWN BY | | |
| NOTE BOOK | TRACED BY | | |
| | CALCULATIONS BY | | |
| No. | QUANTITIES CHECKED BY | | |
| | CHECKED BY | | |