FED. ROAD DIST. NO.	STATE	PROJ. NO.	FISCAL YEAR	SHEET NO.	TOTAL SHEETS
HAWAII	HAW.	B80-01-65	1966	2	6

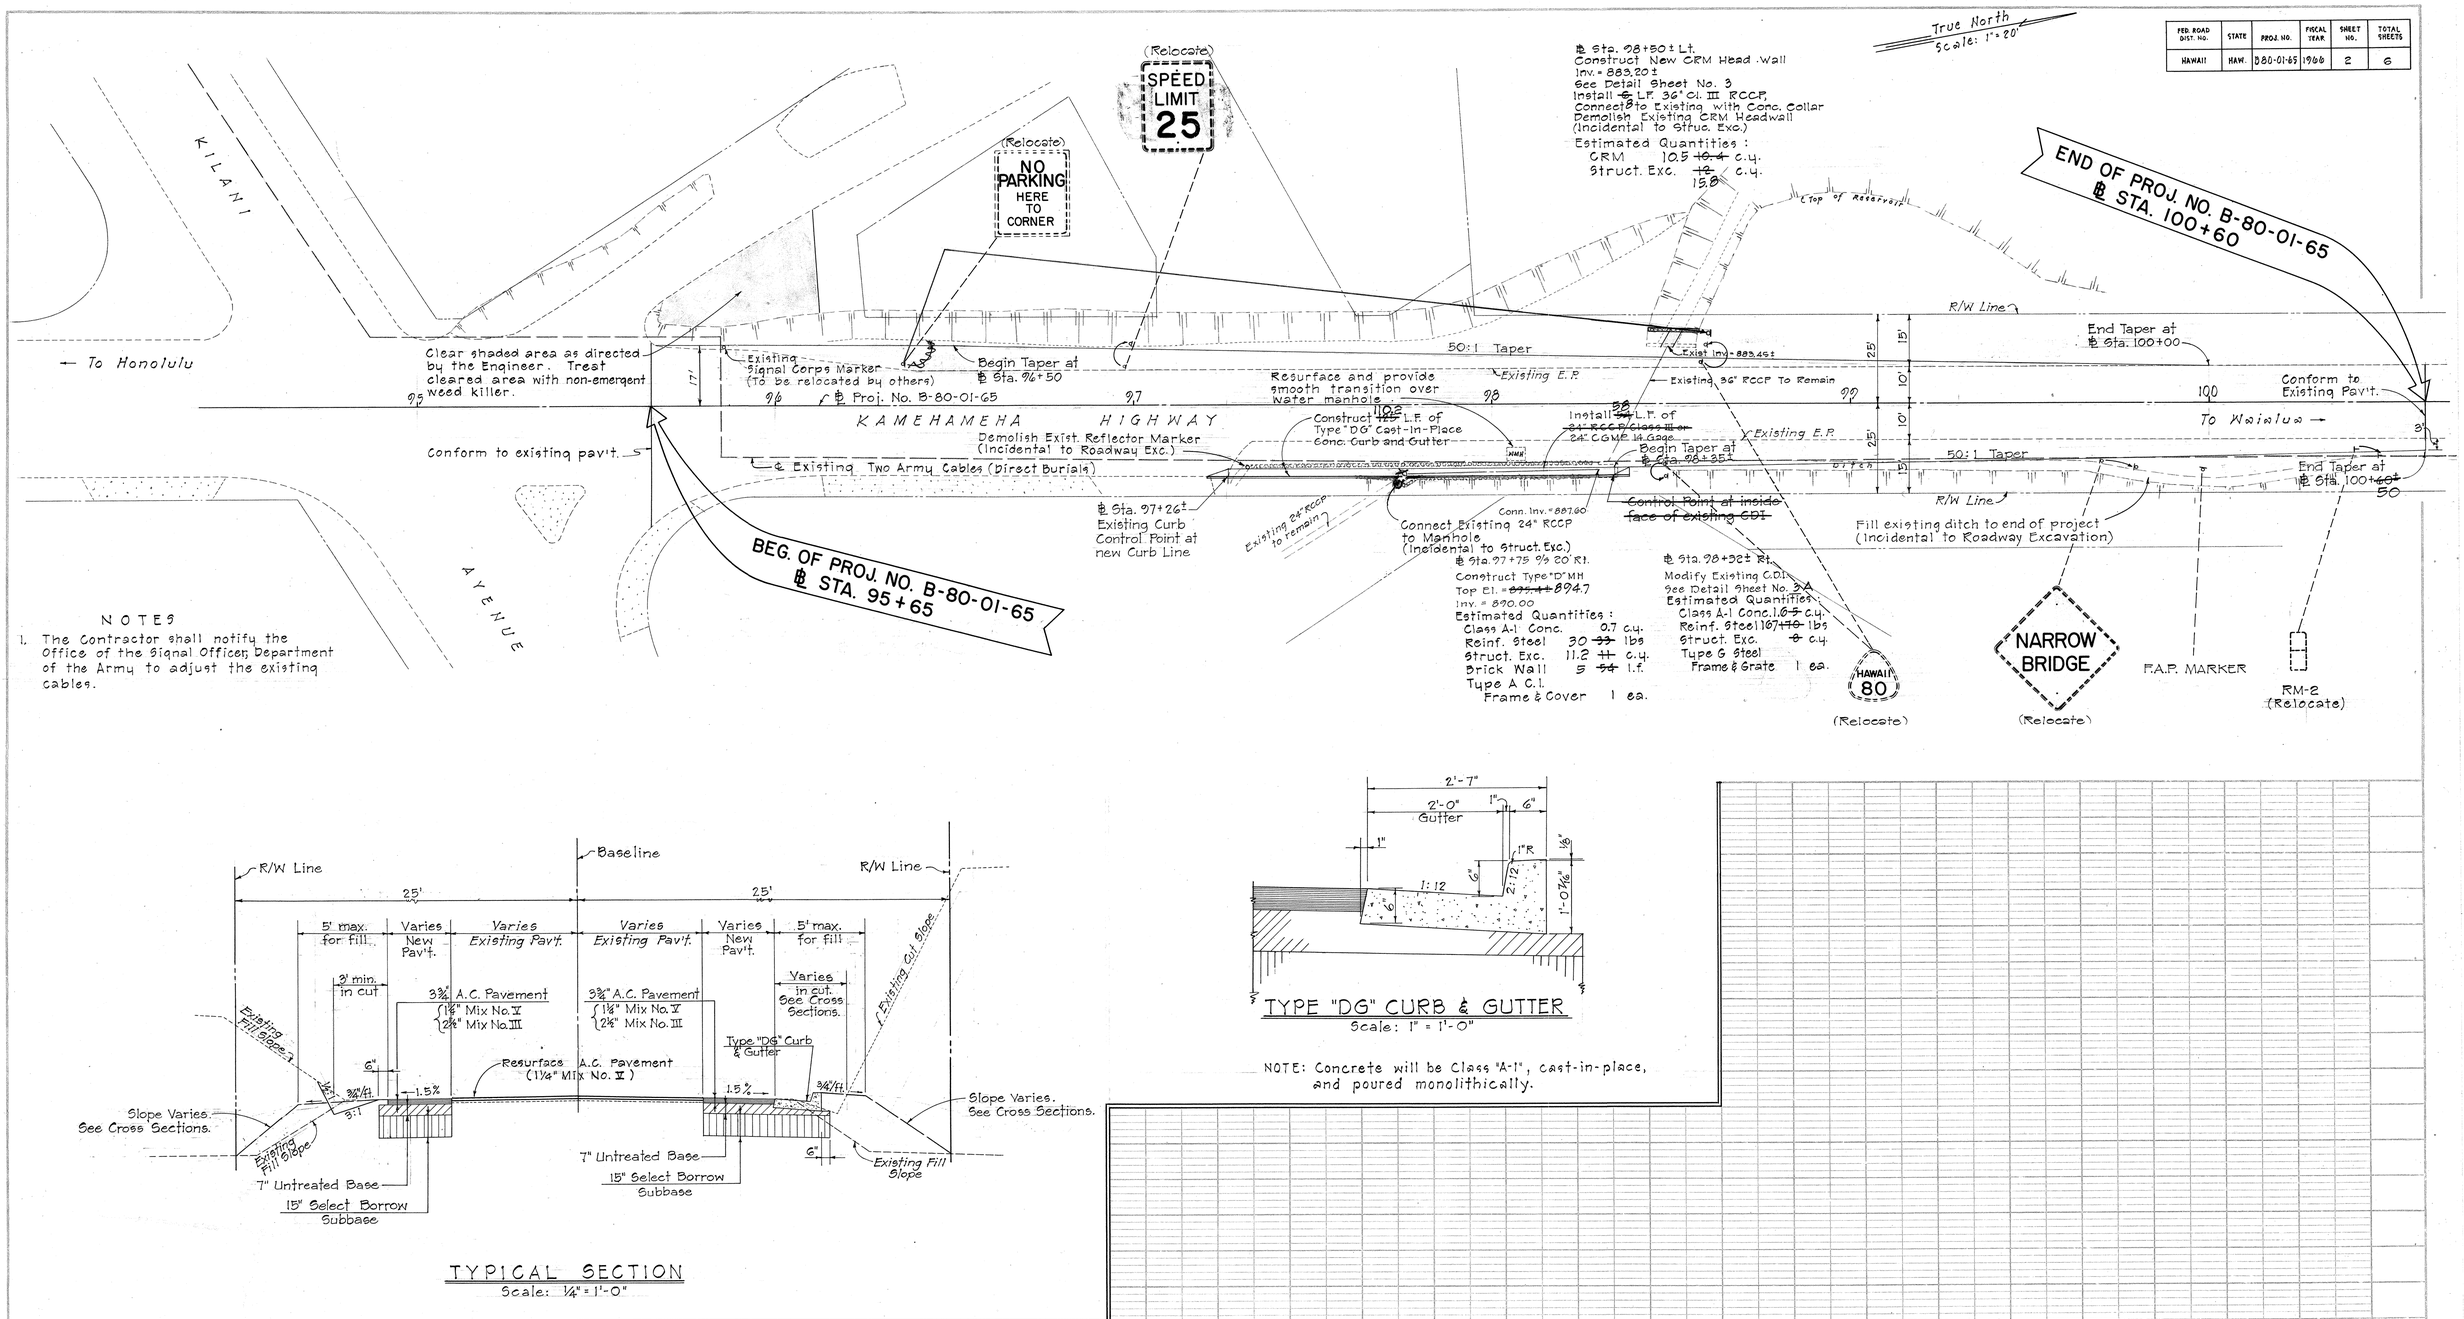

NOTES

1. The Contractor shall notify the Office of the Signal Officer, Department of the Army to adjust the existing cables.

TYPICAL SECTION

Scale: ¼" = 1'-0"

TYPE "DG" CURB & GUTTER

Scale: 1" = 1'-0"

NOTE: Concrete will be Class "A-1", cast-in-place, and poured monolithically.

PLAN: SURVEYED, PLOTTED, ALIGNMENT CHECKED, RT. OF WAY CHECKED, NOTE BOOK NO.

PROFILE: SURVEYED, PLOTTED, GRADES CHECKED, B.M. NOTED, STRUCTURE NOTATIONS CHKD., NOTE BOOK NO.

DATE | BY