FED. ROAD DIST. NO.	STATE	PROJ. NO.	FISCAL YEAR	SHEET NO.	TOTAL SHEETS
HAWAII	HAW.	B-80-01-65 UNIT 2R	1967	1	3

INDEX TO DRAWINGS

SHEET NO.	DESCRIPTION
1	TITLE SHEET
2	LAYOUT & DETAILS - CALIFORNIA AVE. TO KARSTEN THOT BRIDGE
3	LAYOUT & DETAILS KARSTEN THOT BRIDGE

STATE OF HAWAII
DEPARTMENT OF TRANSPORTATION
HIGHWAYS DIVISION
HONOLULU, HAWAII
DISTRICT OF WAHIAWA
ISLAND OF OAHU

PLANS FOR INSTALLATION OF HIGHWAY LIGHTS ON KAMEHAMEHA HIGHWAY (CALIFORNIA AVENUE TO KARSTEN THOT BRIDGE)

PROJECT NO. B-80-01-65 Unit 2R

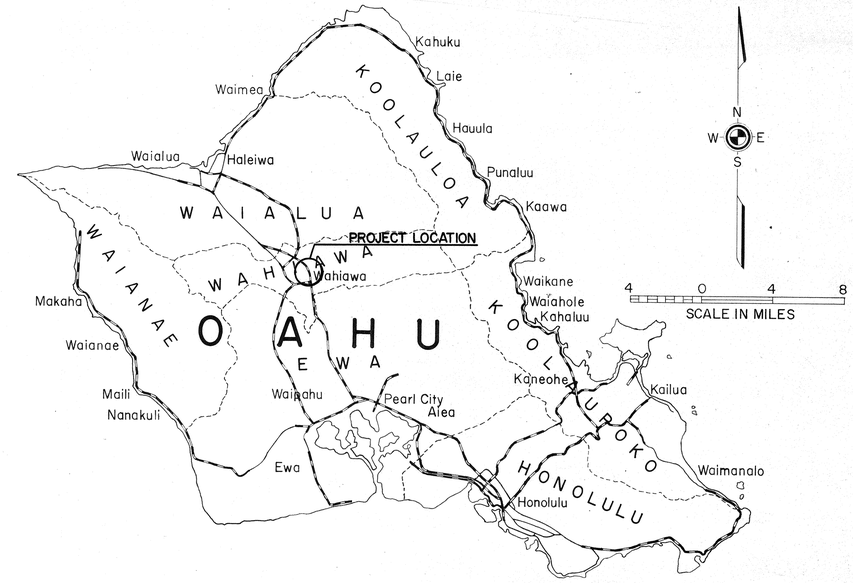

Federal Aid Projects Previously Constructed or Under Construction

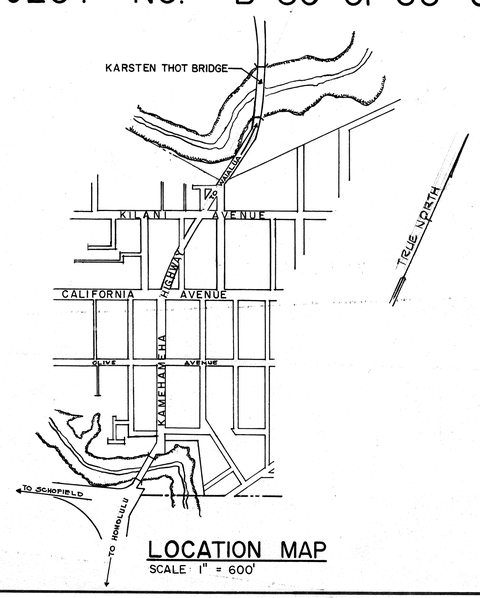

LOCATION MAP
SCALE 1" = 600'

DEPARTMENT OF TRANSPORTATION
STATE OF HAWAII
APPROVED:
for DIR. OF TRANSPORTATION — 3-10-67 DATE

SHEET No. 1 OF 3 SHEETS

Roy Tofada Mar. '67

D-4-6