FED. ROAD DIST. NO.	STATE	FED. AID PROJ. NO.	FISCAL YEAR	SHEET NO.	TOTAL SHEETS
HAWAII	HAW.	BR-F-080-1(7)	1977	158	165

60 50 40 30 20 10 ℄ 10 20 30 40

EXC = 305
EMB = 14

870
865
860

867.05

870
865
860

EXC = 141
EMB = 8

80+00

Forward C = 184
F = 4
Backward C = 74
F = 4

870
865
860

867.34

870
865
860

EXC = 67
EMB = 2

79+50

C = 78
F = 5

870
865
860

79+25

C = 67
F = 0

60 50 40 30 20 10 ℄ 10 20 30 40 50 60

Hor. & Ver. Scale: 1"=5'

PLATE 3 CROSS SECTION
CLEARPRINT PAPER CO., S.F. CAL. NO. 1602N-3

158

ORIGINAL SURVEY
NOTE BOOK
NO.
SURVEYED
PLOTTED
REVISED
AREAS
AREAS CHECKED
BY
DATE

FINAL SURVEY
NOTE BOOK
NO.
SURVEYED
PLOTTED
REVISED
AREAS
AREAS CHECKED
BY
DATE

1150-1122

FED. ROAD DIST. NO.	STATE	FED. AID PROJ. NO.	FISCAL YEAR	SHEET NO.	TOTAL SHEETS
HAWAII	HAW.	BR-F-080-1(7)	1977	159	165

60 50 40 30 20 10 ℄ 10 20 30 40

870 865 860

EXC = 25
EMB = 55

868.14 868.14

END BRIDGE
84+87.24

C = 41
F = 195

867.06 867.06

EXC = 92
EMB = 5

BEGIN BRIDGE
81+12.24

866.99 866.99

EXC = 286
EMB = 23

C = 164
F = 14

81+00

866.98 866.99

C = 145
F = 11

80+50

Hor. & Ver. Scale: 1" = 5'

PLATE 3 CROSS SECTION
CLEARPRINT PAPER CO., S.F. CAL. NO. 1000H-3

159

159

FINAL SURVEY — NOTE BOOK — NO. — SURVEYED — PLOTTED — TEMPLATE — AREAS — CROSS CHECKED — BY — DATE

ORIGINAL SURVEY — NOTE BOOK — NO. — SURVEYED — PLOTTED — TEMPLATE — AREAS — CROSS CHECKED — BY — DATE

FED. ROAD DIST. NO.	STATE	FED. AID PROJ. NO.	FISCAL YEAR	SHEET NO.	TOTAL SHEETS
HAWAII	HAW.	BR-F-080-1(7)	1977	160	165

FINAL SURVEY — NOTE BOOK — NO. — BY — DATE
SURVEYED
PLOTTED
TEMPLATE
AREAS
CROSS CHECKED

ORIGINAL SURVEY — NOTE BOOK — NO. — BY — DATE
SURVEYED
PLOTTED
TEMPLATE
AREAS
CROSS CHECKED

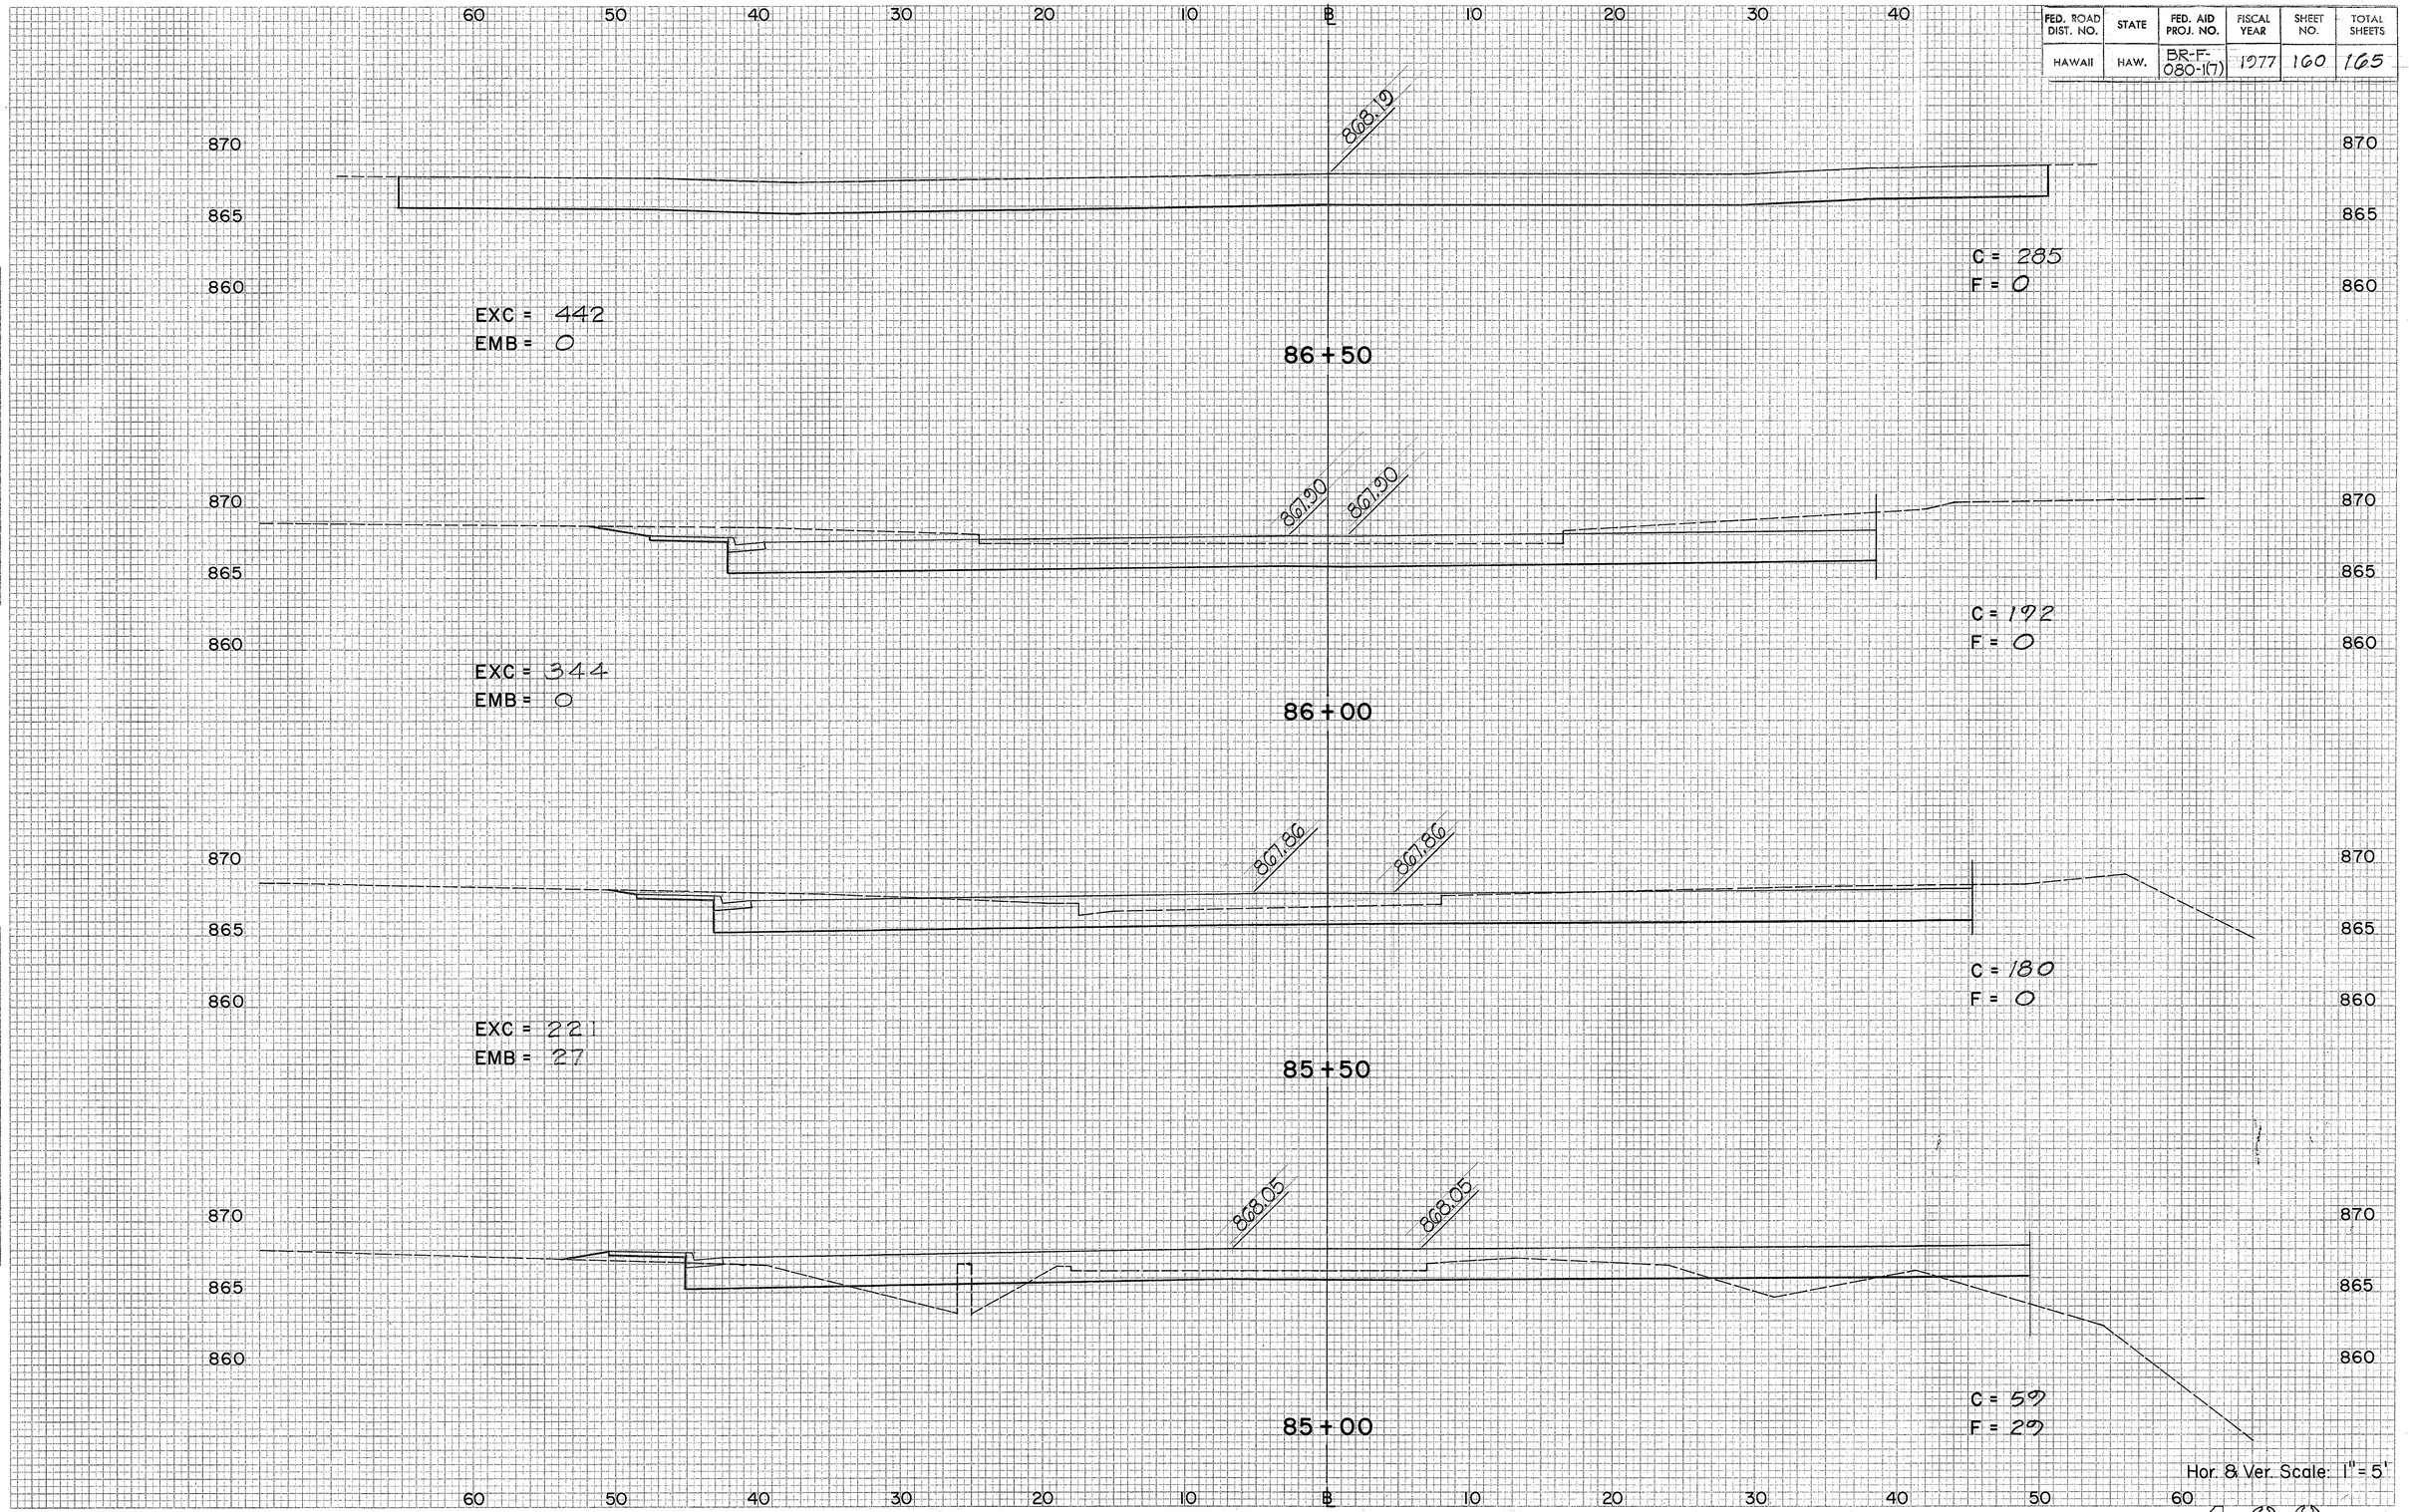

PLATE 3 CROSS SECTION
CLEARPRINT PAPER CO., S.F. CAL. NO. 1000H-3

160

160