FED. ROAD DIST. NO.	STATE	FED. AID PROJ. NO.	FISCAL YEAR	SHEET NO.	TOTAL SHEETS
HAWAII	HAW.	BR-F-080-1(7)	1977	2	165

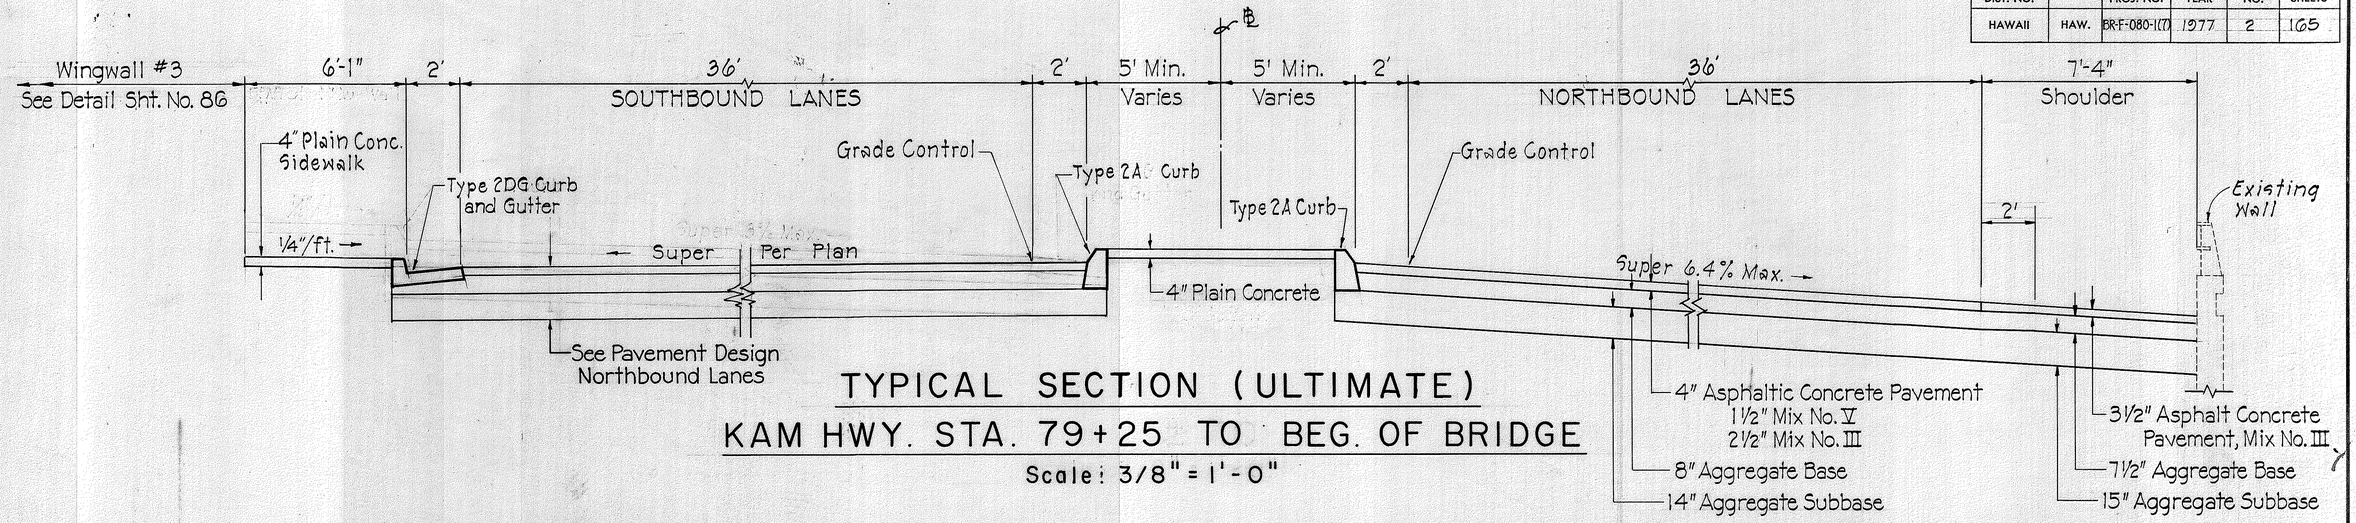

TYPICAL SECTION (ULTIMATE)

KAM HWY. STA. 79+25 TO BEG. OF BRIDGE

Scale: 3/8" = 1'-0"

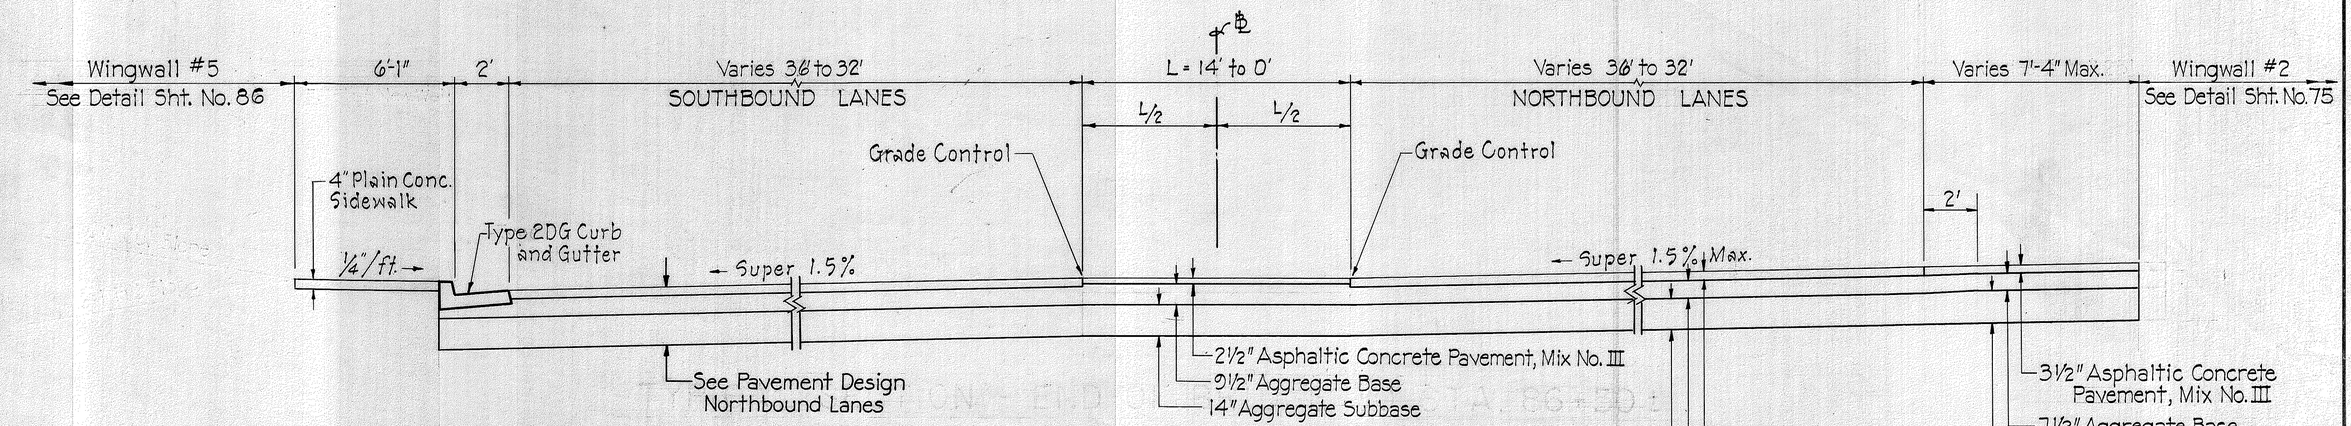

TYPICAL SECTION - END OF BRIDGE TO STA. 86+50

Scale: 3/8" = 1'-0"

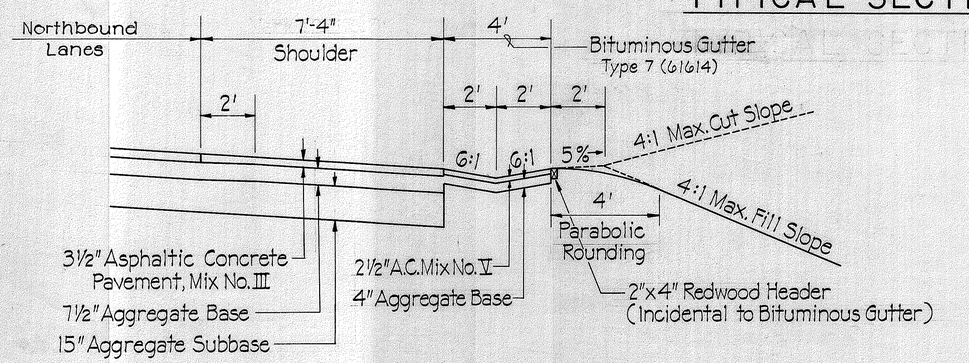

PARTIAL SECTION - STA. 80+40 TO STA. 81+12.74 RT.

Scale: 3/8" = 1'-0"

ORIGINAL PLAN	SURVEY PLOTTED BY	DATE
	DRAWN BY	
	TRACED BY	
	NOTE BOOK	DESIGNED BY
	No.	QUANTITIES BY
		CHECKED BY

STATE OF HAWAII
DEPARTMENT OF TRANSPORTATION
HIGHWAYS DIVISION

TYPICAL SECTIONS

WILSON BRIDGE & APPROACHES

PROJ. NO. BR-F-080-1(7)

Scale: As noted

SHEET No. 1 OF 1 SHEETS

K&E IMPERIAL LA 3207

2