FED. ROAD DIST. NO.	STATE	FED. AID PROJ. NO.	FISCAL YEAR	SHEET NO.	TOTAL SHEETS
HAWAII	HAW.	F-F-080-1(5)	1980	1	123

INDEX TO DRAWINGS	
SHEET NO.	DESCRIPTION
1	TITLE SHEET
2-3	TYPICAL SECTIONS
4-5	PLAN AND PROFILE
6	SUPERELEVATION
7-14	CONSTRUCTION DETOUR
	PHASING
15-18	DETAIL PLANS
19-24	STANDARD DETAILS
25-30	STRUCTURES
31-39	HWY. LIGHTING - TRAFFIC
	SIGNALS
40-56	DRAINAGE
57-74	SIGNING - PAVEMENT
	MARKINGS
①75-115	UTILITIES
(75-108)	(ELECTRIC-TELEPHONE-CATV)
(109-115)	(GAS-WATER-SEWER)
116-123	CROSS SECTIONS

① C.O. 88S-1 SUPPLEMENT SHEET TO THE CONTRACT PLANS.

NEW TOTAL 124 SHEETS

STATE OF HAWAII

DEPARTMENT OF TRANSPORTATION
HIGHWAYS DIVISION

HONOLULU, HAWAII

"AS-BUILT"

PLANS FOR

KAMEHAMEHA HIGHWAY, WAHIAWA
AVOCADO STREET TO KILANI AVENUE
FEDERAL AID PROJECT NO. F-F-080-1(5)

DISTRICT OF WAHIAWA
ISLAND OF OAHU

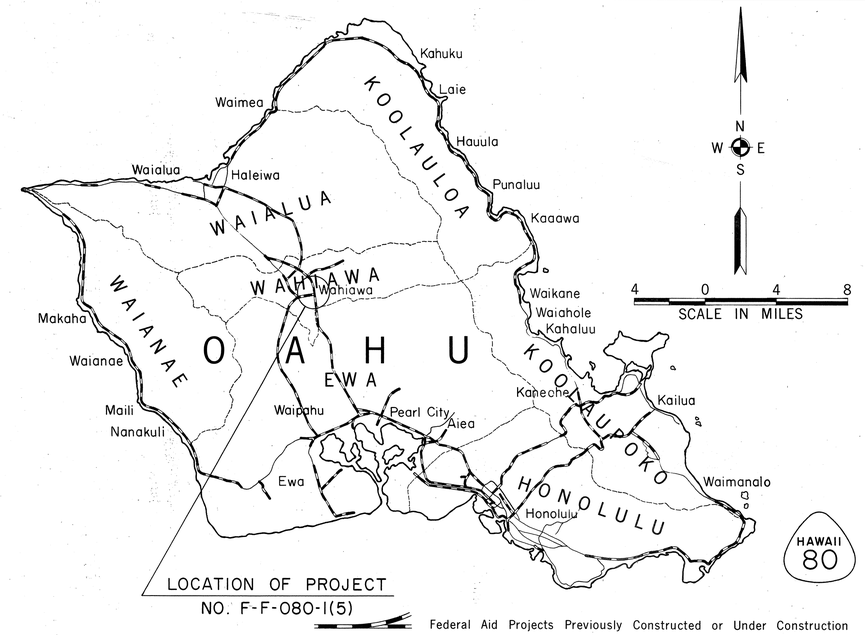

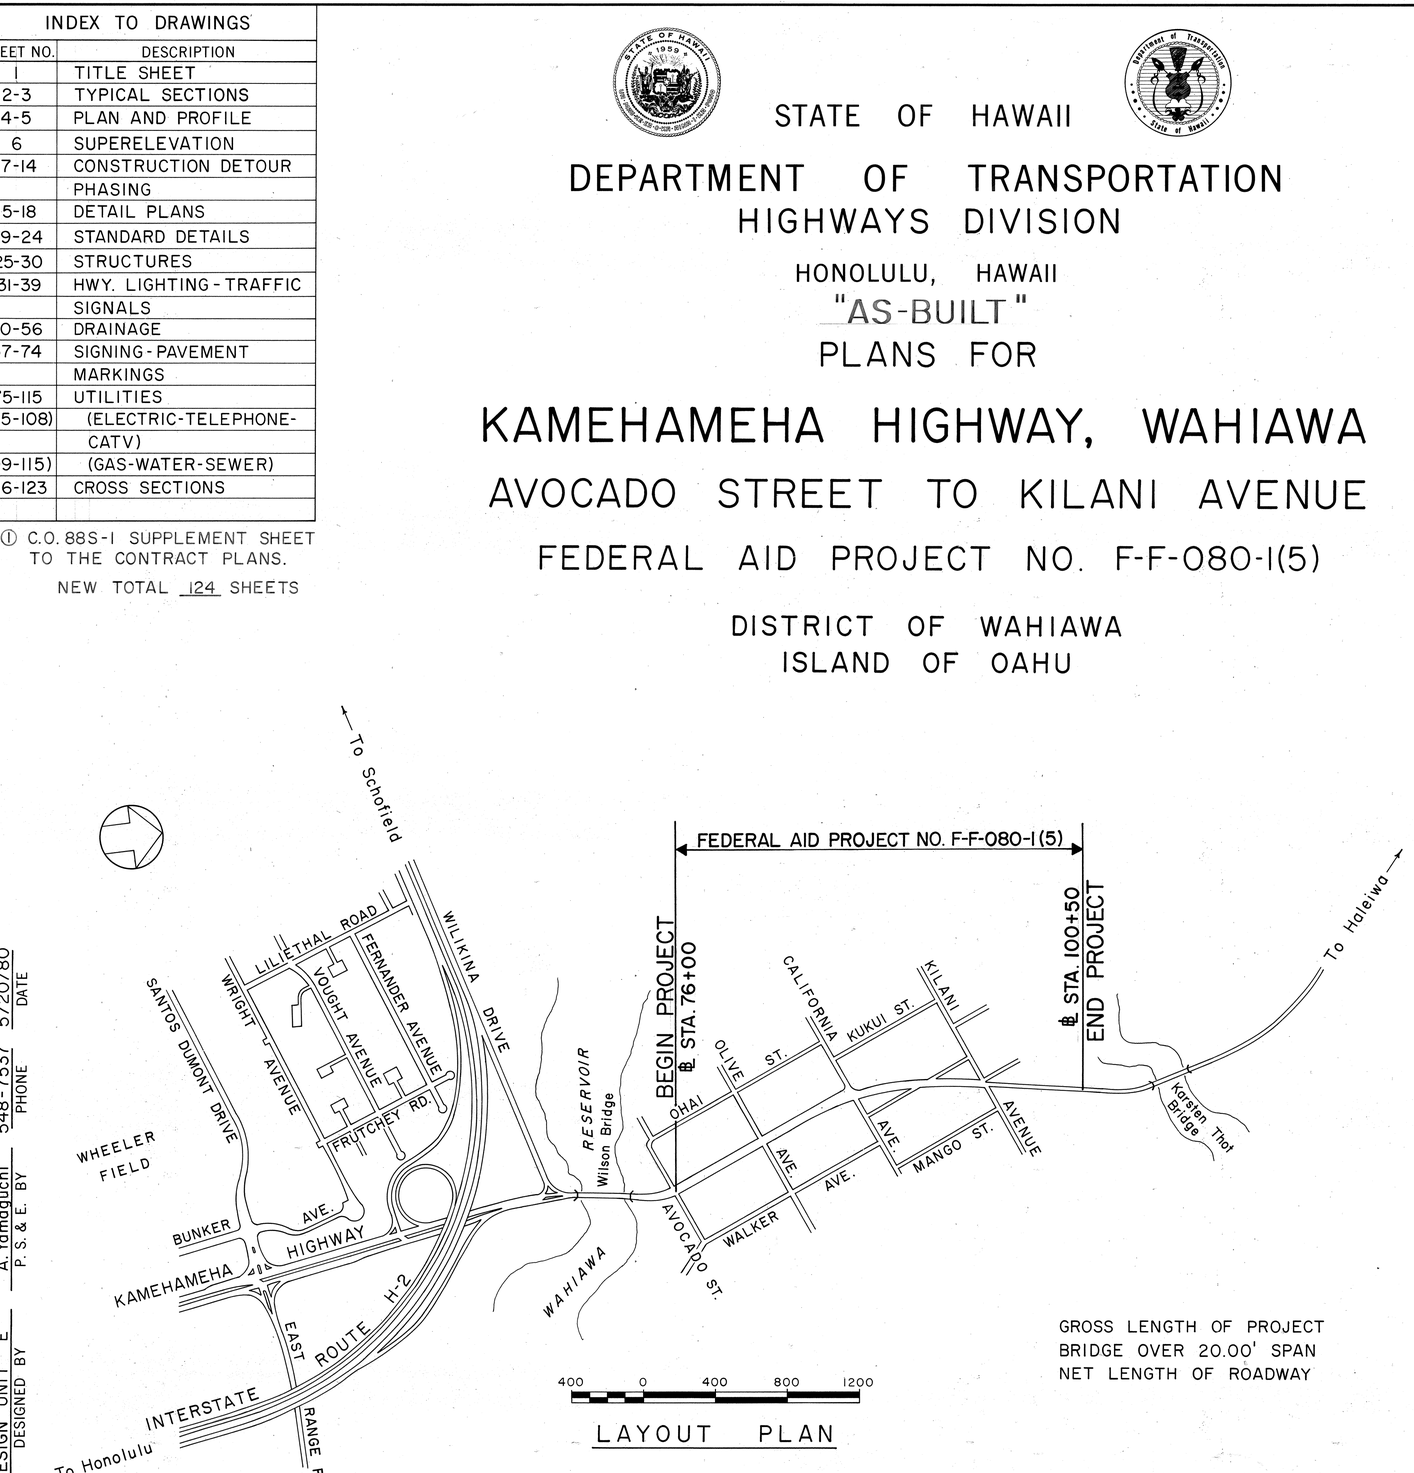

LAYOUT PLAN

DESIGN UNIT "E" — DESIGNED BY
A. Yamaguchi — P. S. & E. BY
548-7537 — PHONE
5/20/80 — DATE

DESIGN CLASSIFICATION

ADT (1980)	28,100
DESIGN ADT (2000)	36,500
DHV	2,920
D	60/40
T	2.0%
T_{24}	3.0%
K	8.0%

CHANGES MADE DURING CONSTRUCTION HAVE BEEN INCORPORATED ON THESE PLANS EXCEPT CHANGES IN THE ORIGINAL THEORETICAL QUANTITIES. FOR ACTUAL QUANTITIES, REFER TO PROJECT LEDGER AND/OR COMPUTATION BOOK.

Ronald N. Kan — RESIDENT ENGINEER — 1-23-84 DATE

GROSS LENGTH OF PROJECT	0.464 MI.
BRIDGE OVER 20.00' SPAN	0.000 MI.
NET LENGTH OF ROADWAY	0.464 MI.

DEPARTMENT OF TRANSPORTATION
FEDERAL HIGHWAY ADMINISTRATION
APPROVED:
DIVISION ADMINISTRATOR — 5.28.80 DATE

DEPARTMENT OF TRANSPORTATION
STATE OF HAWAII
APPROVED:
James R. Carras — DIR. OF TRANSPORTATION — 5/20/80 DATE

D-5-2

D-5-2