FED. ROAD DIST. NO.	STATE	PROJ. NO.	FISCAL YEAR	SHEET NO.	TOTAL SHEETS
HAWAII	HAW.	HWY-0-01-82M	1982	1	15

INDEX TO DRAWINGS

SHEET NO.	DESCRIPTION
1	TITLE SHEET
2	TYPICAL SECTION
3	MISCELLANEOUS DETAILS
4-7	PLANS
8-12	PAVEMENT MARKING PLANS
13-15	STANDARD DETAILS

STATE OF HAWAII

DEPARTMENT OF TRANSPORTATION

HIGHWAYS DIVISION

HONOLULU, HAWAII

"AS BUILT"

PLANS OF

KAMEHAMEHA HIGHWAY RESURFACING

HELEMANO TO KARSTEN THOT BRIDGE

AND

KAMANANUI ROAD RESURFACING

PROJECT NO. HWY-0-01-82M

DISTRICTS OF WAHIAWA & WAIALUA

ISLAND OF OAHU

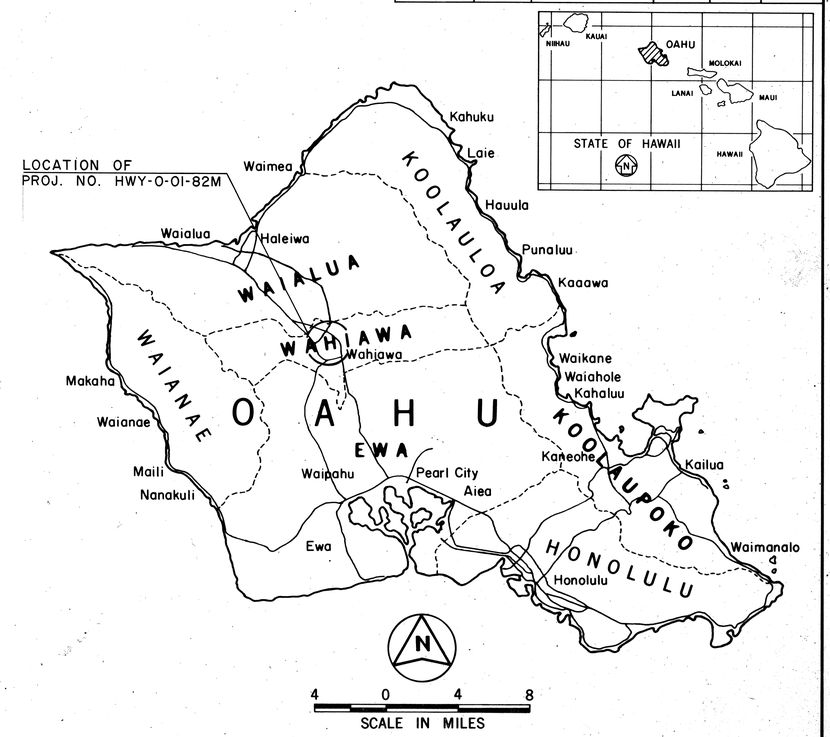

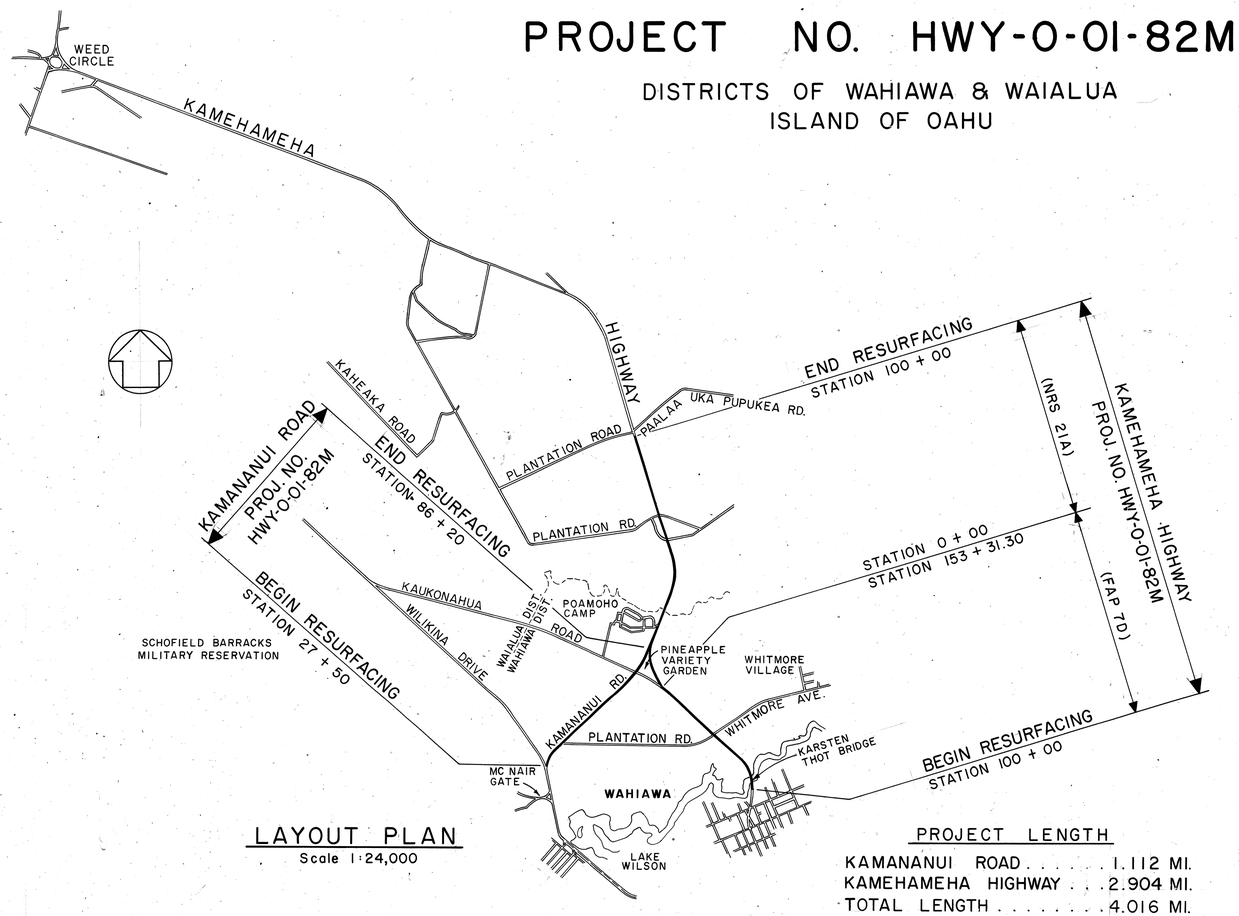

LAYOUT PLAN

Scale 1:24,000

PROJECT LENGTH

KAMANANUI ROAD . . . . . 1.112 MI.
KAMEHAMEHA HIGHWAY . . . 2.904 MI.
TOTAL LENGTH . . . . . 4.016 MI.

NO CHANGES WERE MADE DURING CONSTRUCTION ON THESE PLANS EXCEPT CHANGES IN THE ORIGINAL THEORETICAL QUANTITIES. FOR ACTUAL QUANTITIES, REFER TO PROJECT LEDGER AND/OR COMPUTATION BOOK.

Ronald Kan — RESIDENT ENGINEER — 2/4/83 DATE

DEPARTMENT OF TRANSPORTATION
STATE OF HAWAII

APPROVED:

James R. Carras — DIR. OF TRANSPORTATION — 2/9/82 DATE

Unit "A"	R. Mikami	548-7534	DATE
DESIGNED BY	P. S. & E. BY	PHONE	

10-8-7

62182-2/22