FED. ROAD DIST. NO.	STATE	PROJ. NO.	FISCAL YEAR	SHEET NO.	TOTAL SHEETS
HAWAII	HAW.	HWY-0-01-89M	1989	1	23

INDEX TO DRAWINGS

SHEET NO.	DESCRIPTION
1	TITLE SHEET
2	STANDARD PLANS SUMMARY
3	GENERAL NOTES
4 & 5	TYPICAL SECTIONS
6 - 12	PLANS
13	PAVEMENT MARKING LEGEND, DETAILS & NOTES
14 - 20	SIGNING & PAVEMENT MARKING PLAN
21 & 22	MISCELLANEOUS SUMMARIES
23	PARKING RESTRICTION SIGNS

STATE OF HAWAII

DEPARTMENT OF TRANSPORTATION

HIGHWAYS DIVISION

HONOLULU, HAWAII

"AS-BUILT"

PLANS FOR

KAMEHAMEHA HIGHWAY RESURFACING

WAIKALANI DRIVE TO KARSTEN THOT BRIDGE

PROJECT NO. HWY-0-01-89M

DISTRICT OF WAHIAWA

ISLAND OF OAHU

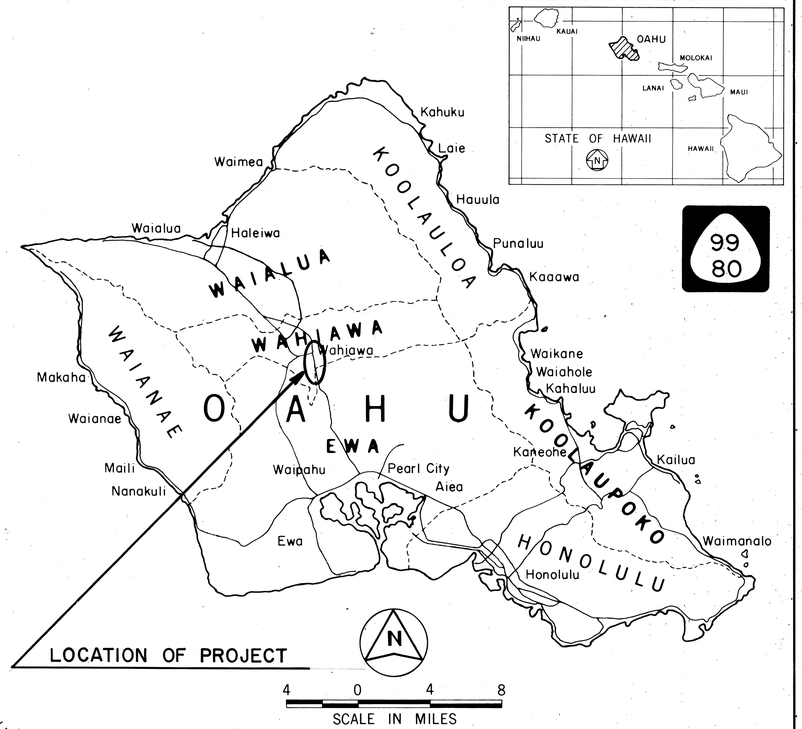

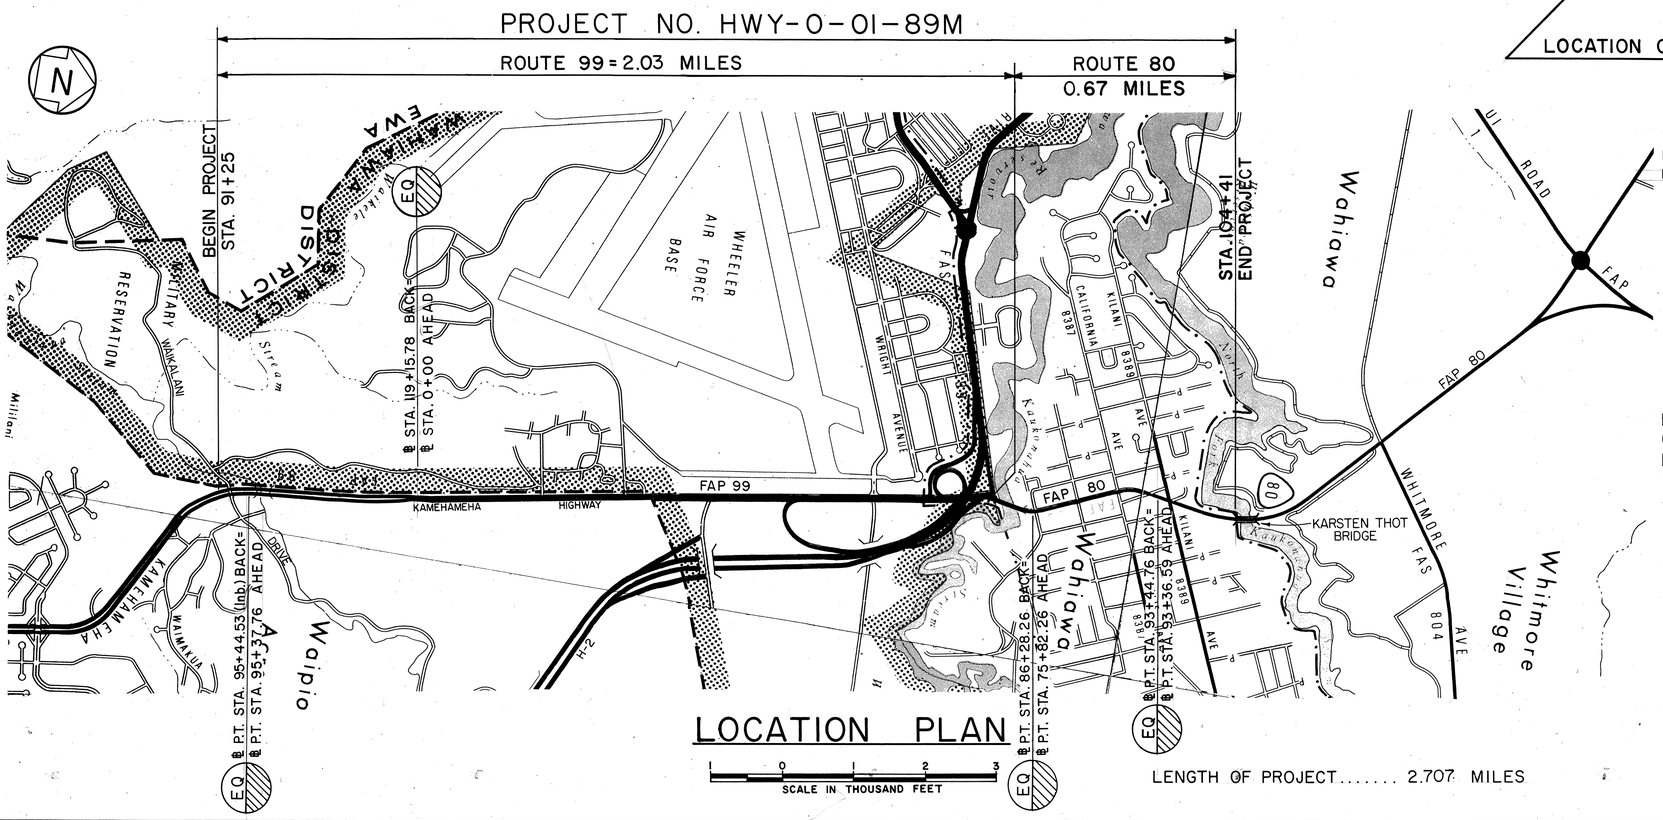

LOCATION PLAN

LENGTH OF PROJECT..... 2.707 MILES

FAP 80	MILE POST	-0.02	TO MILE POST 0.65
FAP 99	MILE POST	9.71	TO MILE POST 11.74

NO SIGNIFICANT CHANGES WERE MADE DURING CONSTRUCTION ON THESE PLANS EXCEPT CHANGES IN THE ORIGINAL THEORETICAL QUANTITIES. FOR ACTUAL QUANTITIES, REFER TO PROJECT LEDGER AND/OR COMPUTATION BOOK.

For RESIDENT ENGINEER — DATE 8/29/91

DEPARTMENT OF TRANSPORTATION
STATE OF HAWAII

APPROVED:

DIR. OF TRANSPORTATION — DATE 5/2/89

DESIGN UNIT "E" — A. YAMAGUCHI — 548-7534 — SEPT. 1988

DESIGNED BY — P. S. & E. BY — PHONE — DATE