FED. ROAD DIST. NO.	STATE	FED. AID PROJ. NO.	FISCAL YEAR	SHEET NO.	TOTAL SHEETS
HAWAII	HAW.	STP-080-1(10)	1994	1	17

INDEX TO DRAWINGS

SHEET NO.	DESCRIPTION
1	TITLE SHEET
2	STANDARD PLANS SUMMARY
3	TRAFFIC LEGEND, DETAILS & NOTES
4–6	PAVEMENT MARKING & SIGNING PLANS
7	TRAFFIC SIGNAL LEGEND, DETAILS & NOTES
8–10	TRAFFIC SIGNAL PLANS
11	SIGN DETAILS
12	SWING SIGN BRACKET DETAIL
13	CITY & COUNTY OF HONOLULU STREET NAME SIGN DETAIL
14–15	WHEELCHAIR RAMP DETAILS
16	LOOP DETECTOR DETAILS
17	TRAFFIC SUMMARIES

STATE OF HAWAII

DEPARTMENT OF TRANSPORTATION

HIGHWAYS DIVISION

HONOLULU, HAWAII

PLANS FOR

KAMEHAMEHA HIGHWAY IMPROVEMENTS

WILSON BRIDGE TO KILANI AVENUE

FEDERAL AID PROJECT NO. STP-080-1(10)

DISTRICT OF WAHIAWA

ISLAND OF OAHU

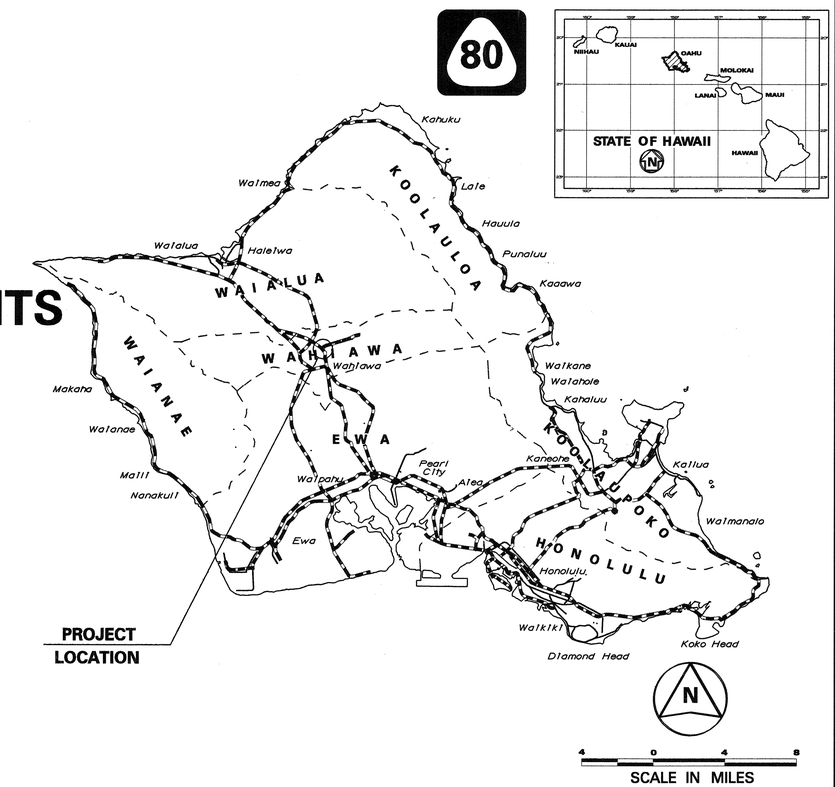

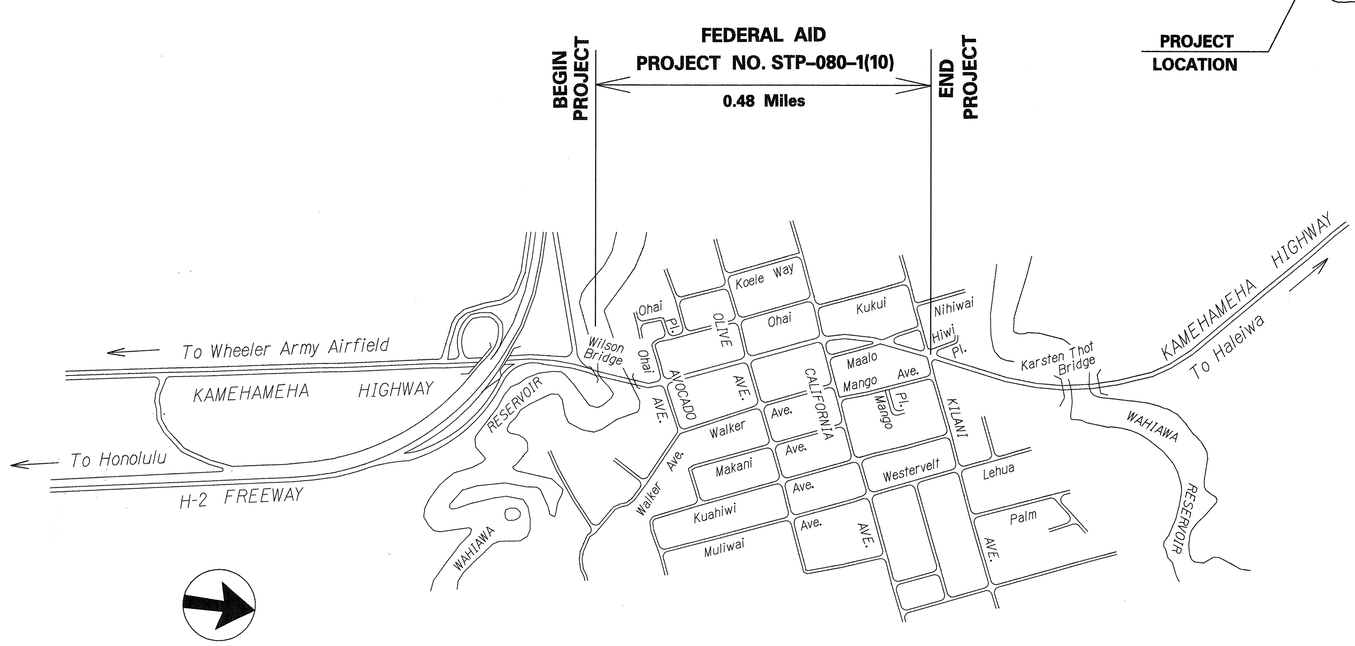

FEDERAL AID PROJECTS PREVIOUSLY CONSTRUCTED OR UNDER CONSTRUCTION

MILE POST 0.00 TO MILE POST 0.48

DESIGN DESIGNATION

ADT(1992)	31,890
ADT(2012)	50,913
DHV	3,450
D	55/45
T	4.5%
T_{24}	3.5%
V	35 mph

LAYOUT PLAN

5 0 5 10 15

SCALE IN HUNDRED FEET

DEPARTMENT OF TRANSPORTATION
STATE OF HAWAII

APPROVED:

T. Hirano 3/1/94

FOR DIR. OF TRANSPORTATION DATE

HWY-TD DESIGNED BY | BRIAN CHING P. S. & E. BY | 587-2173 PHONE | Nov., 1993 DATE