Sheet No	INDEX TO DRAWINGS
1	Title Sheet.
2	Standard Cross-Sections - Roadway.
3	Plans & Profiles.
4-6	Bridge Details.
7	Cross-Sections.

TERRITORY OF HAWAII
TERRITORIAL HIGHWAY DEPARTMENT
HONOLULU. T.H.

PLANS OF
WAIALUA TWIN BRIDGES
FEDERAL AID PROJECT NO 7A
WAIALUA DISTRICT
OAHU T.H.

IN ACCORDANCE WITH ITEM 21 ACT 271, S.L. HAW. 1927.

FED. ROAD DIST. NO.	STATE	FED. AID PROJ. NO.	FISCAL YEAR	SHEET NO.	TOTAL SHEETS
	HAWAII	HAW 7-A	1928	1	6

SCALES.

PLAN		1 INCH = 40 FEET
PROFILE	HOR.	1 INCH = 40 FEET
	VER.	1 INCH = 4 FEET
CROSS-SECTION		1 INCH = 5 FEET

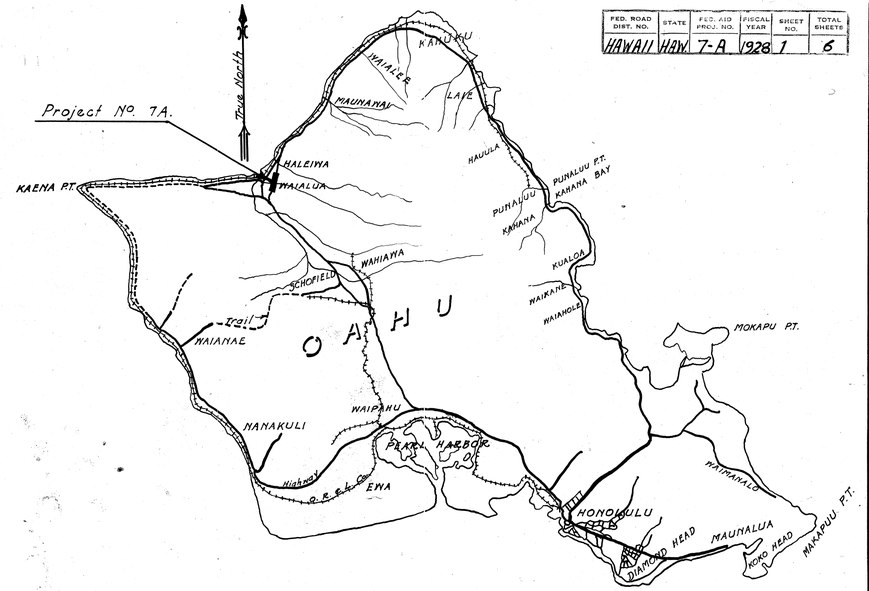

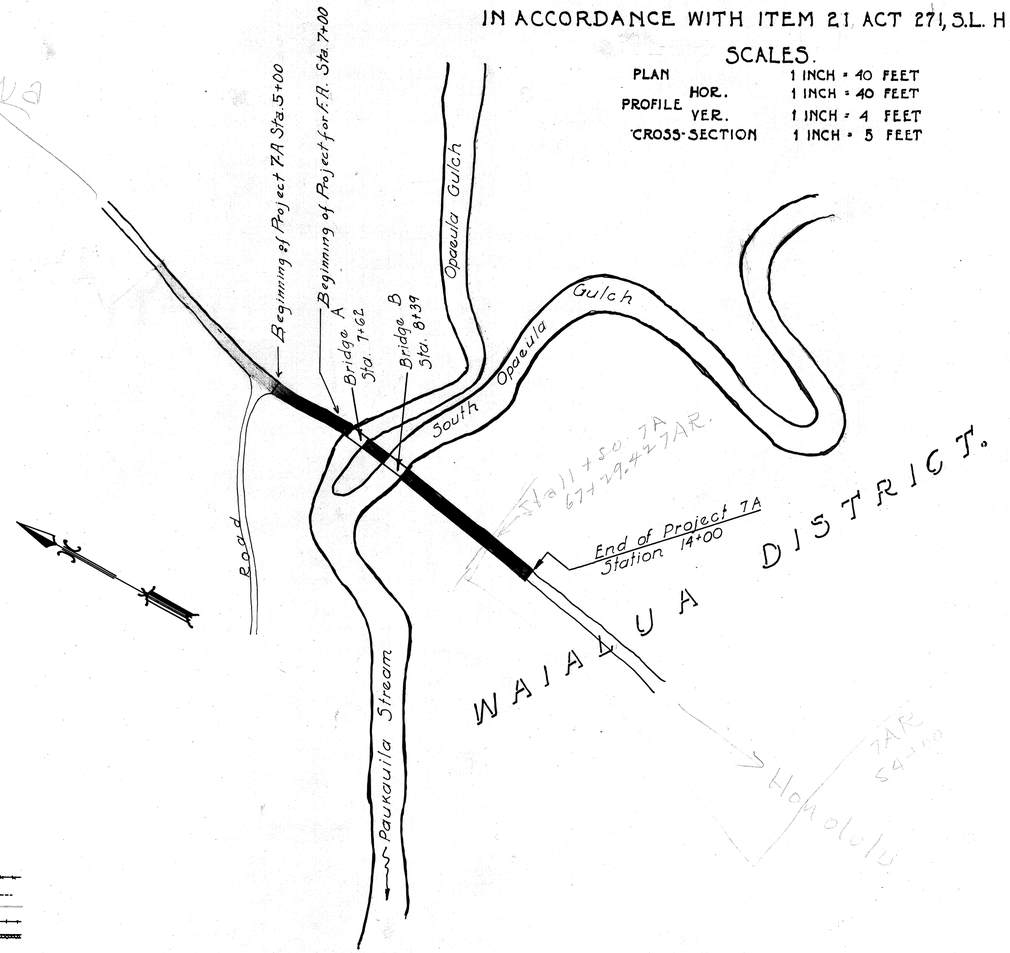

CONVENTIONAL SIGNS

FENCE LINE
EDGE OF EXISTING ROADWAY
RIGHT OF WAY LINE
RAILROAD
RETAINING WALLS

LAYOUT OF PROJECT

Scale 1 in. = 200 feet

GROSS LENGTH	0.133	MILE
EXCEPTIONS	0.000	"
NET LENGTH	0.133	"

4029.1

APPROVED
Ryan H. Bigelow
1-23-28
TERRITORIAL HIGHWAY ENGINEER.

RECOMMENDED FOR APPROVAL
SENIOR HIGHWAY ENGINEER Bureau of Public Roads.

RECOMMENDED FOR APPROVAL
CHIEF ENGINEER Bureau of Public Roads.

APPROVED
DIRECTOR Bureau of Public Roads.

6 12 2