| FED. ROAD DIST. NO. | STATE | FISCAL YEAR | PROJECT NO. | SHEET NO. | TOTAL SHEETS |
|---|---|---|---|---|---|
| HAWAII | HAW. | 1-D | 1932 | 1 | 57 |

| INDEX TO DRAWING | |
|---|---|
| SHEET NO. | DESCRIPTIONS |
| 1 | Title Sheet |
| 2 | Typical Road Sections |
| 3—22 | Plan and Profile of Roadway |
| 23—24 | Standard Detail Sheets |
| 25—26 | Culvert Details |
| 27—36 | Bridge Details |
| 37—57 | Cross Sections |

TERRITORY OF HAWAII
TERRITORIAL HIGHWAY DEPARTMENT
HONOLULU T.H.

# PLANS OF
# KAMEHAMEHA HIGHWAY
## FEDERAL AID PROJECT NO. 1 D
## HAUULA TO KAHUKU

DISTRICT OF KOOLAULOA
OAHU

### SCALE

| | | |
|---|---|---|
| PLAN | | 1 INCH = 50 FEET |
| PROFILE | HOR. | 1 INCH = 50 FEET |
| | VER. | 1 INCH = 5 FEET |
| CROSS SECTION | | 1 INCH = 5 FEET |

### CONVENTIONAL SIGNS

Edge of existing Road
Existing Fence
Boundary Line (not fenced)
Existing Stone Wall
Railroad
Center Line
Large Tree
Cement Rubble Masonry Retaining Walls
Bridge




Note For Bureau of Public Roads

Group "A" is to be constructed with $880,000 Fund.
Group "B" is to be constructed with Terr. Fund and Federal Aid.
All bridges are to be built with Terr. Fund and Federal Aid.

NOTE - Revised 6/30/33 to change division line between group "A" & "B" from Sta 1429+00 to Sta 1455+50

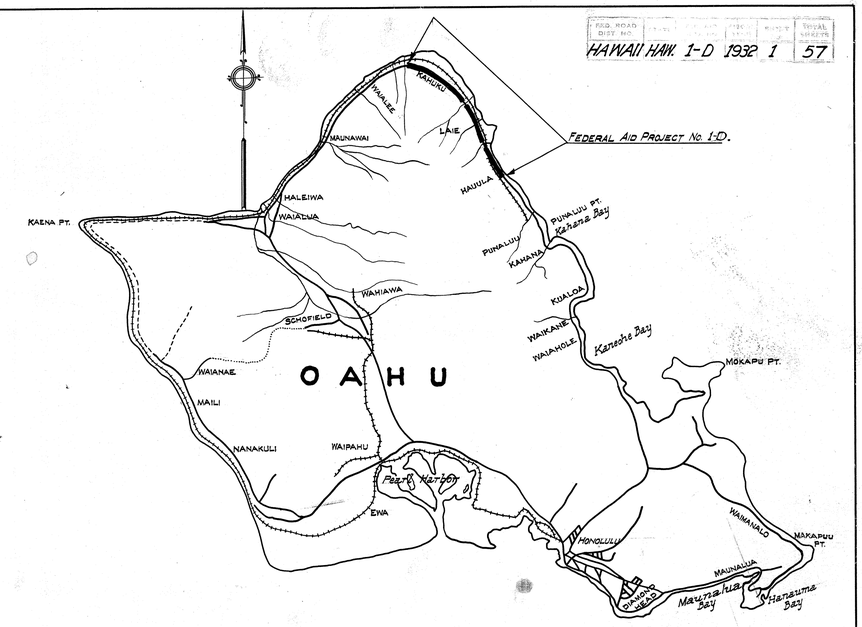


LAYOUT OF PROJECT
SCALE 1/20,000

Note + Elevations are based on U.S.G.S. Datum.

### TABLE OF LENGTHS IN MILES

| GROSS LENGTH | ENTIRE PROJ | GROUP "A" | GROUP "B" |
|---|---|---|---|
| Gross length | 5.433 | 4.884 | 0.549 |
| Exceptions Proj. 1-C Part 1 = 0.126 Proj. 1-C Part 2 = 0.142 | 0.268 | 0.268 | 0 |
| Length of project | 5.165 | 4.616 | 0.549 |
| Bridges over 20 ft. span | 0.085 | 0.085 | 0 |
| Length of Roadway | 5.080 | 4.531 | 0.549 |

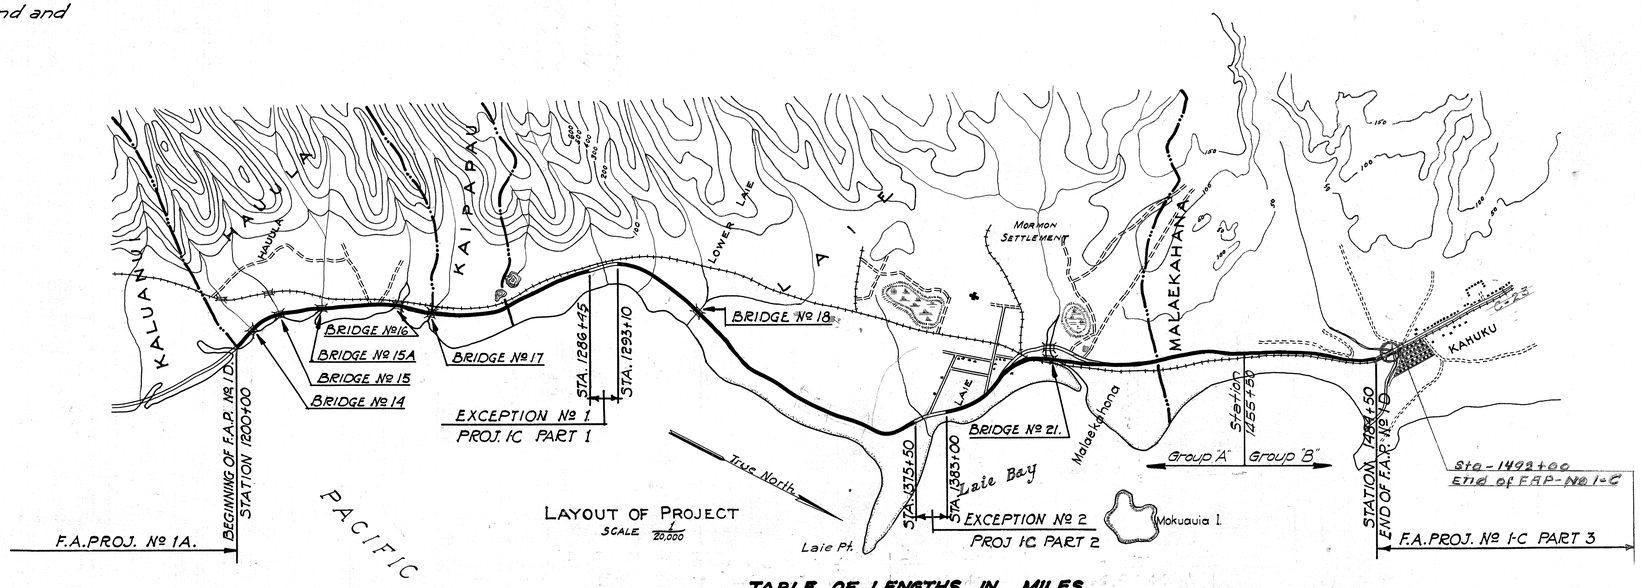APPROVED
Lyman H. Wigglesworth
April 16, 1932
TERRITORIAL HIGHWAY ENGINEER

RECOMMENDED FOR APPROVAL
S. O. Hulten 5-3 1932
PRINCIPAL HIGHWAY ENGR. Bureau of Public Roads

RECOMMENDED FOR APPROVAL
1932
CHIEF ENGR. Bureau of Public Roads

APPROVED
1932
DIRECTOR. Bureau of Public Roads

Plan File No. 6 18 1

4251.1