FED. ROAD DIST. NO.	STATE	FED. AID PROJ. NO.	FISCAL YEAR	SHEET NO.	TOTAL SHEETS
HAWAII	HAW.	F083-1(1)	1956	1	30

TERRITORY OF HAWAII
TERRITORIAL HIGHWAY DEPARTMENT
HONOLULU, OAHU, T. H.

"AS BUILT"

PLANS OF
KAMEHAMEHA HIGHWAY

FEDERAL AID PROJECT NO. F 083-1(1)

DISTRICT OF KOOLAUPOKO

ISLAND OF OAHU

INDEX TO DRAWINGS

SHEET NO.	DESCRIPTION
1	TITLE SHEET
2-3	TYPICAL SECTIONS
4-5	PLAN & PROFILE
6-7	INTERSECTION DETAILS
8	LOCATION OF BORROW PIT
9	HIGHWAY LIGHTING
10	TRAFFIC SIGNS
11-18	STANDARD DETAILS
19-21	BOX CULVERT DETAILS
22-30	CROSS SECTIONS

CONVENTIONAL SIGNS

Centerline
Boundary Lines, or
Fences (Named)
Existing Roadways
Circular Culvert
Box Culvert
Bridge
Telephone Pole — T.P.
Electric Power Pole — E.P.
Water Main — W2 (W4, 8, 12, Etc.)
Storm Drain — SD12 (SD18, 24, Etc.)
Concrete Drop Intake — C.D.I.
Standard Catch Basin — S.C.B.
Standard Manhole — M.H.S.
Sewer Manhole — S8 — S.M.H.
Telephone Manhole — T.M.H.
Fire Hydrant — F.H.
Tree (Large, named) — Mango, Coca
Railroad
Mutual Telephone Underground Cable — MTC
Water Meter — WM

SCALES

PLAN		1 IN. = 50 FT.
PROFILE	HOR.	1 IN. = 50 FT.
	VERT.	1 IN. = 10 FT.
CROSS SECTION	HOR.	1 IN. = 10 FT.
	VERT.	1 IN. = 10 FT.

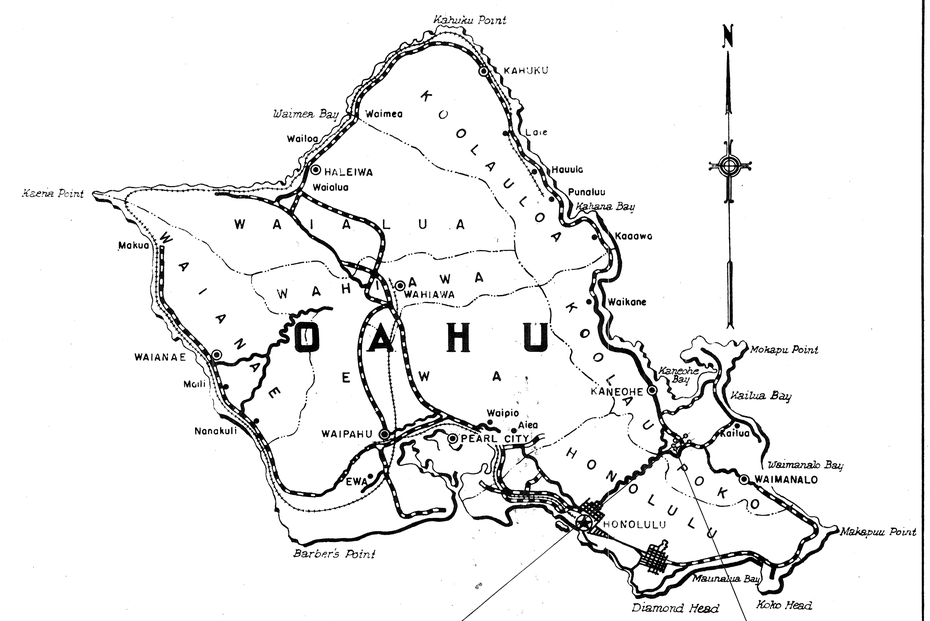

LOCATION OF PROJECT NO. F 083-1(1)

Federal Aid Projects Previously Constructed Or Under Construction

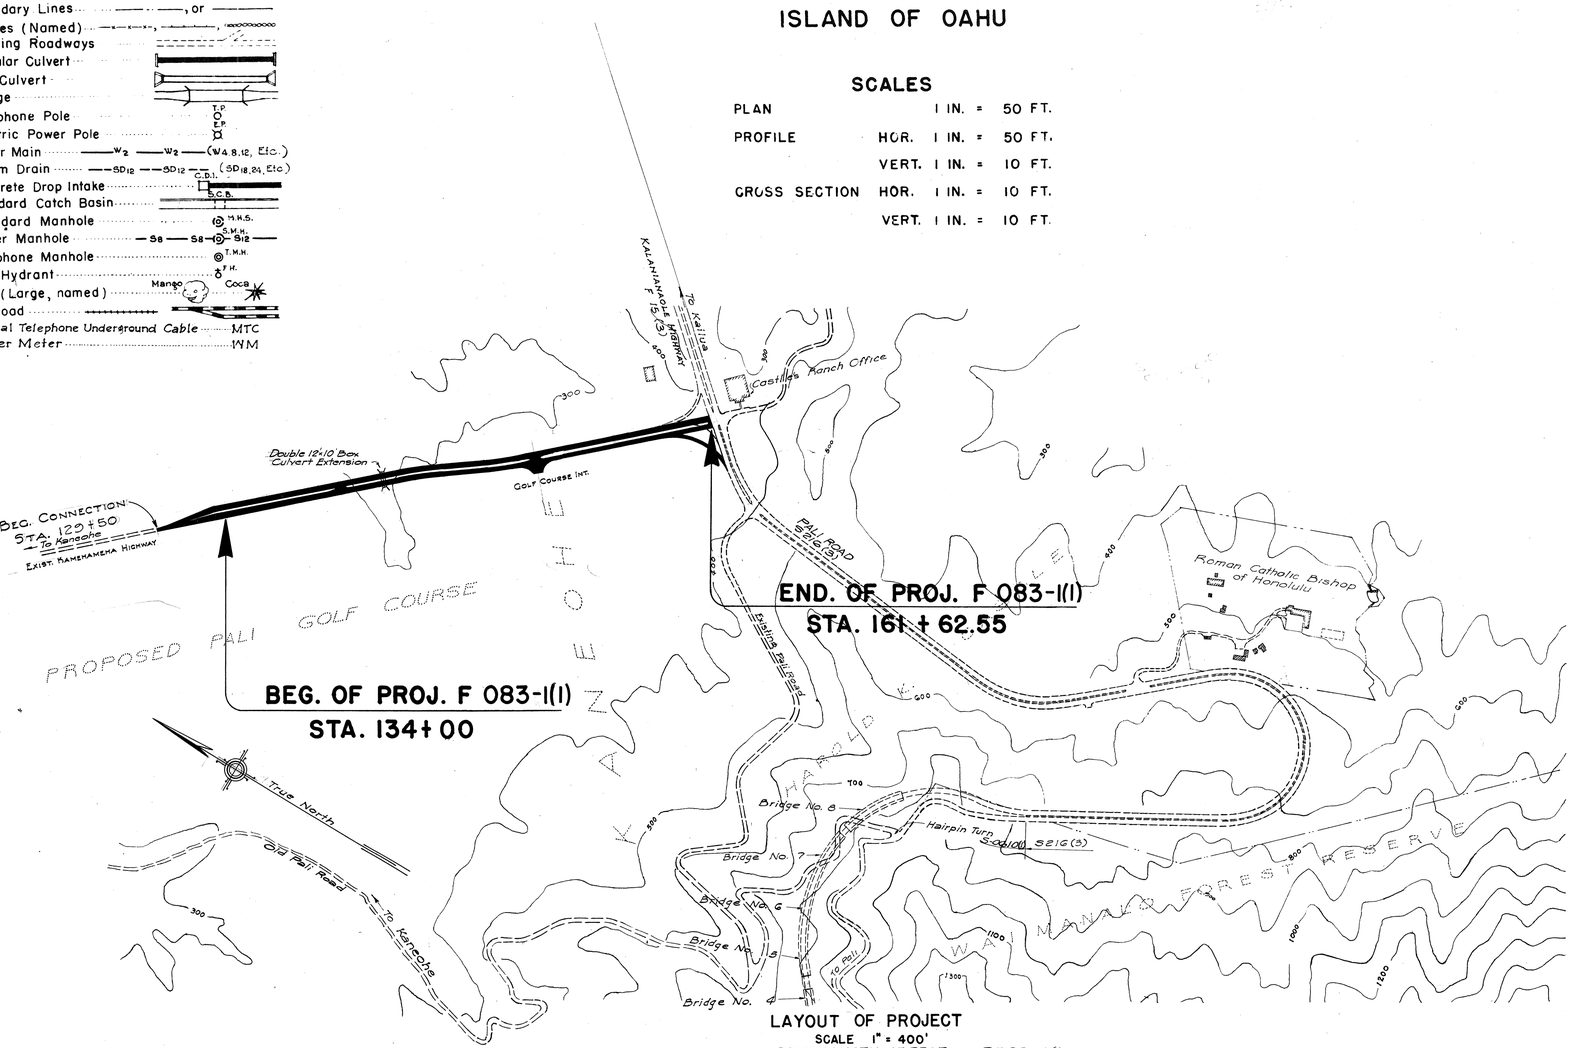

LAYOUT OF PROJECT

SCALE 1" = 400'

GROSS LENGTH OF PROJ. = 0.523 Mi.
BRIDGES OVER 20'-0" SPAN = 0.005 Mi.
NET LENGTH OF ROADWAY = 0.518 Mi.

NOTE:
ALL CHANGES MADE DURING CONSTRUCTION HAVE BEEN NOTED IN RED ON THESE TRACINGS AND CHECKED BY:

Fred R. Lopez
PROJECT ENGINEER

July 10, 1958
DATE

APPROVED ..... DATE 10/28/55

Harold W. Burtzlaff
ACT'G TERRITORIAL HIGHWAY ENGINEER

DEPARTMENT OF COMMERCE
BUREAU OF PUBLIC ROADS
APPROVED:

[redacted]
DISTRICT ENGINEER DATE

ORIGINAL PLAN		DATE
	SURVEY PLOTTED BY	
	TRACING CHECKED BY	
	DRAWN BY	
NOTE BOOK	TRACED BY	
	QUANTITIES BY	
No.	QUANTITIES CHECKED BY	
	CHECKED BY	

5644.1