FED. ROAD DIST. No.	STATE	FED. AID PROJ. No.	FISCAL YEAR	SHEET No.	TOTAL SHEETS
HAWAII	HAW.	S-0630(5)	1958	1	53

TERRITORY OF HAWAII
TERRITORIAL HIGHWAY DEPARTMENT
HONOLULU, OAHU, T.H.

"AS BUILT"
PLANS OF

LIKELIKE HIGHWAY

(GRADING AND DRAINAGE STRUCTURES)

FEDERAL AID SECONDARY PROJECT NO. S-0630 (5)

DISTRICT OF KOOLAUPOKO
ISLAND OF OAHU

INDEX TO DRAWINGS

SHEET NO.	DESCRIPTION
1	TITLE SHEET
2	TYPICAL SECTIONS
3 – 7	PLAN & PROFILE
8 – 11	INTERSECTIONS DETAILS
12	SAND DRAINS
13 – 15	SOIL PROFILE
16	SUBURBAN WATER SYSTEM DETAIL
17 – 20	STORM DRAINS
21 – 22	BRIDGE NO. 1
23 – 27	BRIDGE NO. 2
28 – 53	CROSS SECTIONS

CONVENTIONAL SIGNS

BASELINE
CENTERLINE
BOUNDARY LINE
FENCES (NAMED)
EXISTING ROADWAYS
CIRCULAR CULVERT
BOX CULVERT
TELEPHONE POLE
ELECTRIC POWER POLE
CONCRETE DROP INTAKE
STANDARD CATCH BASIN
STANDARD MANHOLE
FIRE HYDRANT
TREE (LARGE, NAMED) Manao

SCALE

PLAN		1 INCH	=	50 FEET
PROFILE	HOR.	1 INCH	=	50 FEET
	VER.	1 INCH	=	10 FEET
CROSS SECTION	HOR.	1 INCH	=	10 FEET
	VER.	1 INCH	=	10 FEET

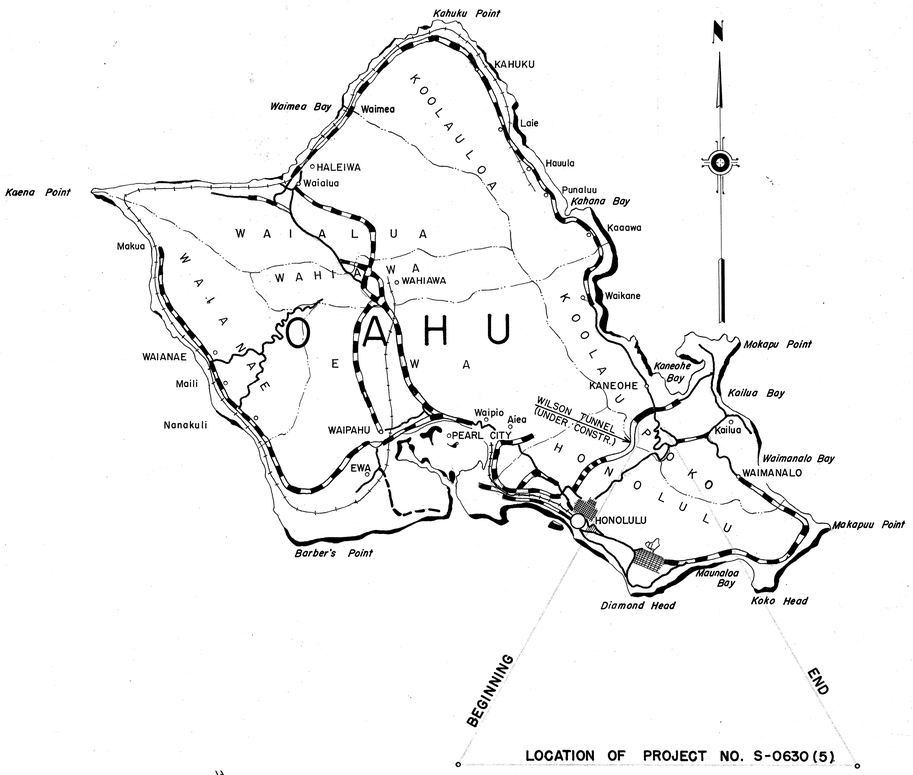

LOCATION OF PROJECT NO. S-0630 (5)

FEDERAL AID PROJECTS PREVIOUSLY CONSTRUCTED OR UNDER CONSTRUCTION

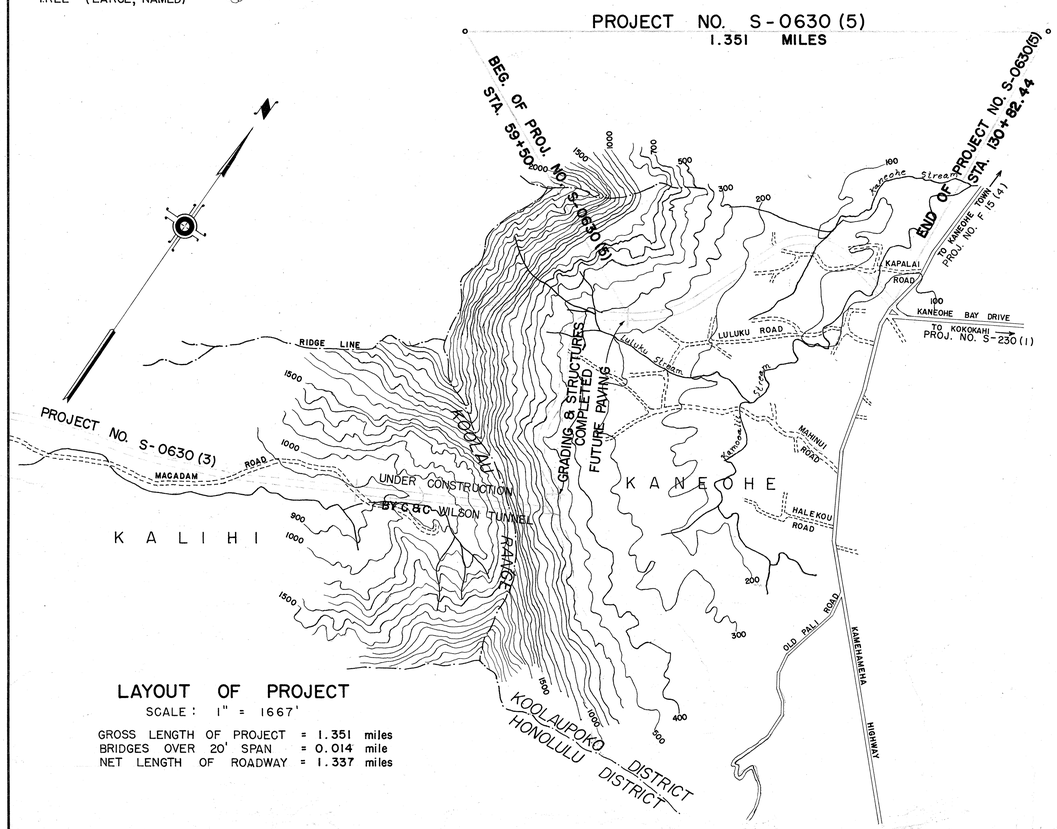

LAYOUT OF PROJECT

SCALE: 1" = 1667'

GROSS LENGTH OF PROJECT = 1.351 miles
BRIDGES OVER 20' SPAN = 0.014 mile
NET LENGTH OF ROADWAY = 1.337 miles

NOTE:
ALL CHANGES MADE DURING CONSTRUCTION HAVE BEEN NOTED IN RED ON THESE SHEETS AND CHECKED BY:

J. M. Chen
DISTRICT ENGINEER
12/14/72
DATE

APPROVED DATE 9/16/57
Wm Wachter
TERRITORIAL HIGHWAY ENGINEER

DEPARTMENT OF COMMERCE
BUREAU OF PUBLIC ROADS
APPROVED
DIVISION ENGINEER DATE

ORIGINAL PLAN	SURVEY PLOTTED BY	DATE
	DESIGNED BY	
	DRAWN BY	
	TRACED BY	
NOTE BOOK No.	QUANTITIES BY	
	QUANTITIES CHECKED BY	
	CHECKED BY	

D0-H-9

5905.1

PRINTED ON DIEPO 1000H CLEARPRINT