| FED. ROAD DIST. NO. | STATE | PROJ. NO. | FISCAL YEAR | SHEET NO. | TOTAL SHEETS |
|---|---|---|---|---|---|
| HAWAII | HAW | 83C-04-68 | 1968 | 1 | 6 |

INDEX TO DRAWINGS

| SHEET NO. | DESCRIPTION |
|---|---|
| 1 | TITLE SHEET |
| 2 | PLAN & PROFILE |
| 3 | DRAINAGE DETAILS |
| 4-6 | STANDARD DETAILS |

STATE OF HAWAII

# DEPARTMENT OF TRANSPORTATION
## HIGHWAYS DIVISION

HONOLULU, HAWAII

LOCATION OF PROJECT

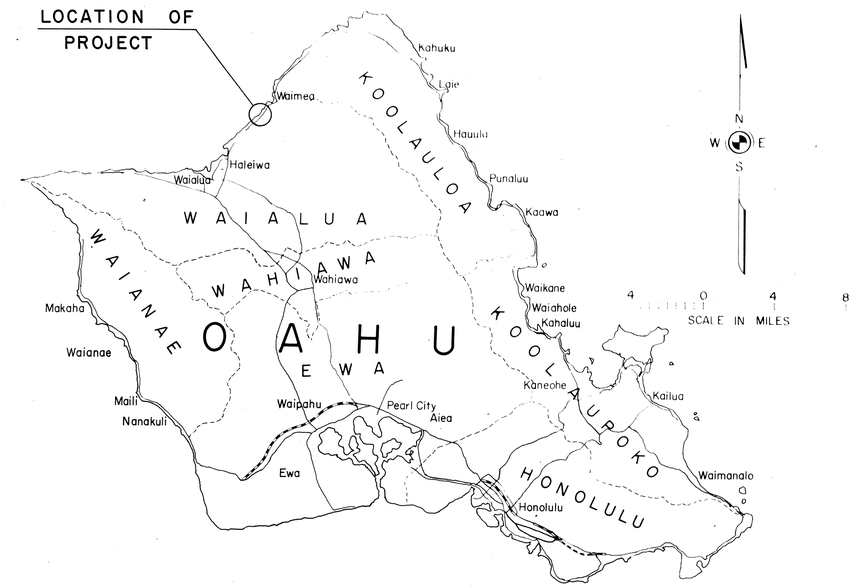


Federal Aid Interstate Projects Previously Constructed or Under Construction.

"AS BUILT"
PLANS FOR
CONSTRUCTION OF

# DRAINAGE IMPROVEMENTS
ON
# KAMEHAMEHA HIGHWAY
VICINITY OF WAIMEA BAY
PROJECT NO. 83C-04-68

DISTRICT OF WAIALUA
ISLAND OF OAHU

NOTE:
ALL CHANGES MADE DURING CONSTRUCTION HAVE BEEN NOTED IN RED ON THESE TRACINGS AND CHECKED BY:

Badua
PROJECT ENGINEER

7/26/71
DATE

DEPARTMENT OF TRANSPORTATION
STATE OF HAWAII
APPROVED:
DIR. OF TRANSPORTATION — DATE