INDEX TO DRAWINGS	
SHEET NO.	DESCRIPTION
1	PLAN & SITE PLAN
2	EXTERIOR ELEVATIONS
3	FOUNDATION & FLOOR PLANS
4	PIER DETAILS & SECTIONS
5	SECTIONS
6	DETAILS & GENERAL NOTES
7	PRESTRESSED GIRDERS
8	METAL GUARD RAIL
9	METAL GUARD RAIL
10	METAL GUARD RAIL
11	RUB RAIL
12	GUARD RAIL END ANCHORAGE

PLANS OF

PEDESTRIAN OVERPASS

PROJECT NO. GD 65-335

DISTRICT OF KOOLAUPOKO
ISLAND OF OAHU

STATE OF HAWAII

DEPARTMENT OF TRANSPORTATION

HIGHWAYS DIVISION

HONOLULU, HAWAII

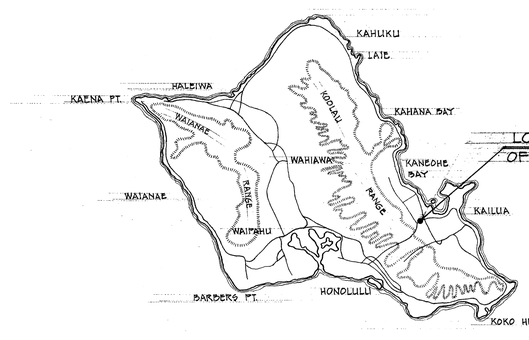

LOCATION PLAN
N.T.S.

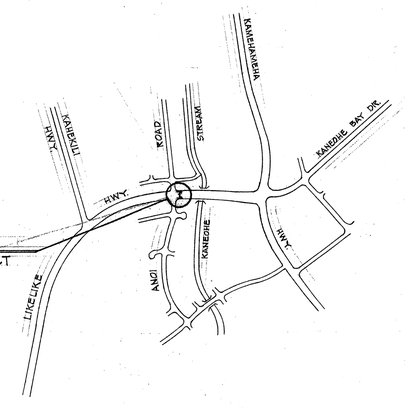

SITE PLAN
N.T.S.

SUBMITTED BY: AKIYAMA, KEKOOLANI & ASSOCIATES, AIA
HAROLD T. MIYAMOTO, PE

APPROVED BY: E. Alvey Wright 9/30/68
FOR DIRECTOR OF TRANSPORTATION DATE

NO AS BUILT CHANGES