INDEX TO DRAWINGS	
SHEET NO.	DESCRIPTION
1	TITLE SHEET
2	PROJECT INFORMATION SIGN

FED. ROAD DIST. NO.	STATE	PROJ. NO.	FISCAL YEAR	SHEET NO.	TOTAL SHEETS
HAWAII	HAW.	83H-02-71	1971	1	2

STATE OF HAWAII
DEPARTMENT OF TRANSPORTATION
HIGHWAYS DIVISION
HONOLULU, HAWAII
"AS BUILT"
PLANS FOR

KAMEHAMEHA HIGHWAY RESURFACING AND IMPROVEMENT

MAUKA LANES BETWEEN LIKELIKE AND KOOLAU VIEW DR.

PROJECT NO. 83H-02-71

DISTRICT OF KOOLAUPOKO
ISLAND OF OAHU

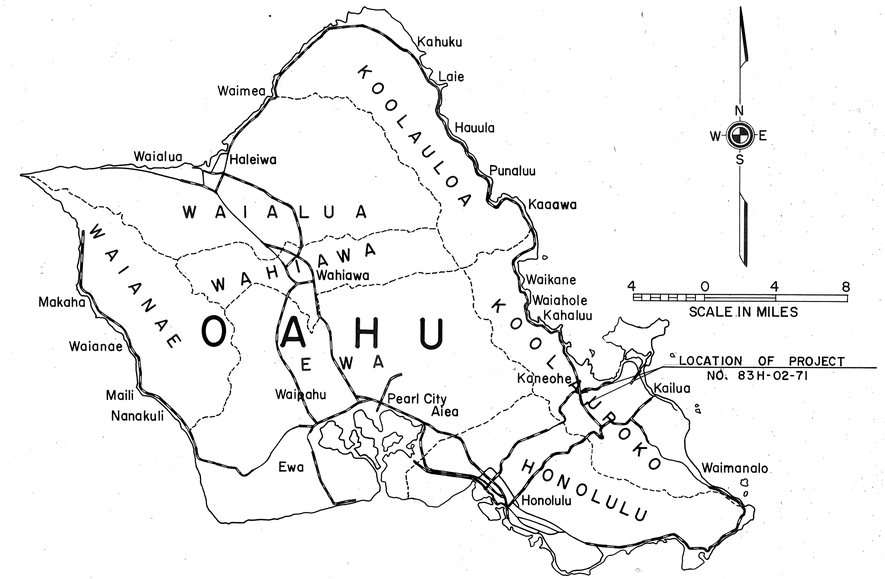

GENERAL NOTES

1. All resurfacing shall be done with Asphaltic Concrete Mix V.
2. SS-1 Emulsified Asphalt shall be used for tack coat and applied on the existing pavement that is to be resurfaced.
3. All resurfacing areas shall be broomed-off and cleaned of foreign materials.
4. Resurfacing shall cover the whole width of the existing pavement and the Engineer will designate the exact extent of coverage at driveways, median openings and intersections.
5. All connections shall conform to the existing pavement to provide a smooth riding surface.
6. All work shall be done in accordance with the Standard Specifications.
7. The Contractor shall install one Project Information Sign at the location designated by the Engineer. The Project Information Sign shall be considered incidental to the various contract items and no separate or additional payments will be made thereof.
8. All pavement striping will be done by State Forces.
9. Resurfacing Areas and thickness:
   a.) ℄ - Sta. 39+07.10 to Sta. 41+75
   2 1/2" A.C. Mix V
   b.) ℄ - Sta. 51+90 to Sta. 52+46
   1" A.C. Mix V
   c.) ℄ - Sta. 63+~~26~~ 06 to 63+70
   1" A.C. Mix V
   d.) ℄ - Sta. 66+95 to 70+~~55~~ 87
   1" A.C. Mix V
   e.) ℄ - Sta. 82+78 to 83+28
   1 1/2" A.C. Mix V
   f.) ℄ - Sta. ~~89+90~~ 88+40 to ~~94+25~~ 95+50
   1" A.C. Mix V
10. Average width of existing pavement varies from 20 feet to 24 feet.
   g.) ℄ - Sta. 79+03 to 82+78
   1" A.C. Mix V
   h.) ℄ - Sta. 83+28 to 86+78
   1" A.C. Mix V

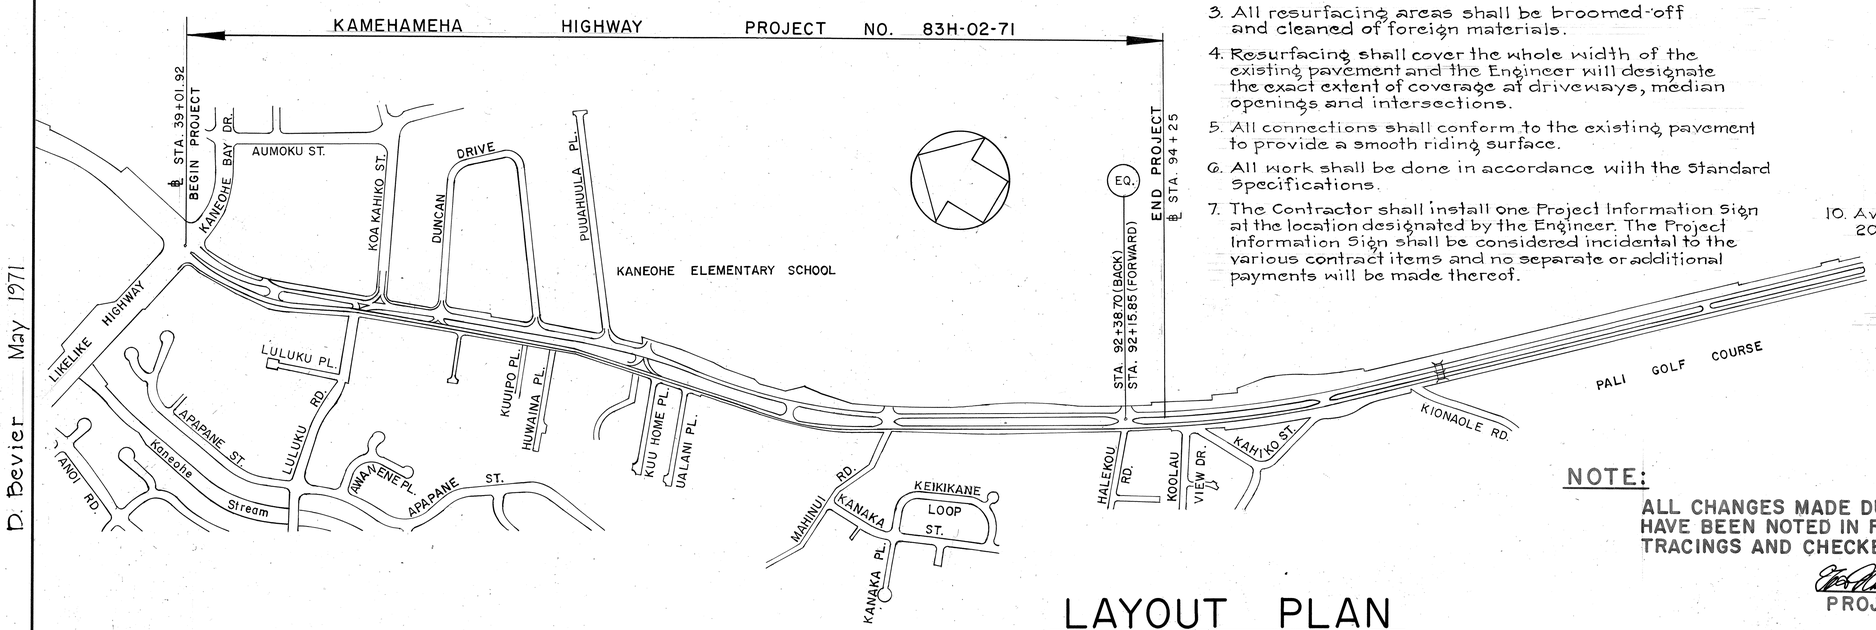

LAYOUT PLAN

Scale: 1" = 400'
LENGTH OF PROJECT ..... 1.050 Mi.

NOTE:

ALL CHANGES MADE DURING CONSTRUCTION HAVE BEEN NOTED IN RED ON THESE TRACINGS AND CHECKED BY:

PROJECT ENGINEER
12/30/71
DATE

DEPARTMENT OF TRANSPORTATION
STATE OF HAWAII
APPROVED:
for DIR. OF TRANSPORTATION — 6/10/71 DATE

D. Bevier May 1971

01-9-2