FED. ROAD DIST. NO.	STATE	PROJ. NO.	FISCAL YEAR	SHEET NO.	TOTAL SHEETS
HAWAII	HAW.	63A-11-71 83H-01-71	1972	1	16

INDEX TO DRAWINGS

SHEET NO.	DESCRIPTION
1	TITLE SHEET
2	TYPICAL GUARD RAIL SECTION
3-7	PLANS
8-16	STANDARD AND TYPICAL DETAILS

STATE OF HAWAII

DEPARTMENT OF TRANSPORTATION
HIGHWAYS DIVISION

HONOLULU, HAWAII

"AS BUILT" PLANS FOR

LIKELIKE HIGHWAY
GUARD RAIL IMPROVEMENTS
WILSON TUNNEL TO ANOI ROAD
PROJECT NO. 63A-11-71
AND
ANOI ROAD TO KAMEHAMEHA HIGHWAY
PROJECT NO. 83H-01-71

DISTRICT OF KOOLAUPOKO
ISLAND OF OAHU

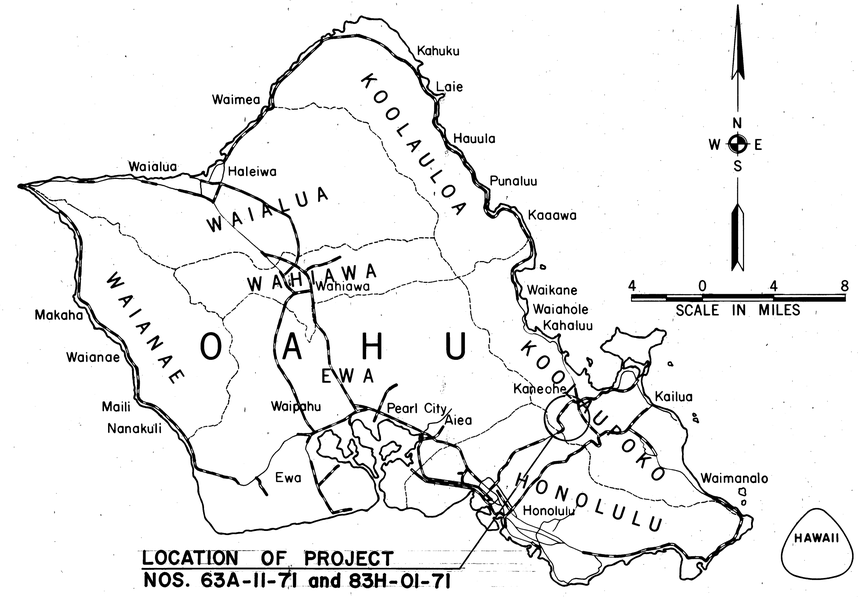

NOTE:

ALL CHANGES MADE DURING CONSTRUCTION HAVE BEEN INCORPORATED ON THESE PLANS EXCEPT CHANGES IN THE ORIGINAL THEORETICAL QUANTITIES. FOR ACTUAL QUANTITIES REFER TO PROJECT LEDGER AND/OR COMPUTATION BOOK.

Gilbert J. Almeida — PROJECT ENGINEER — 4-29-74 DATE

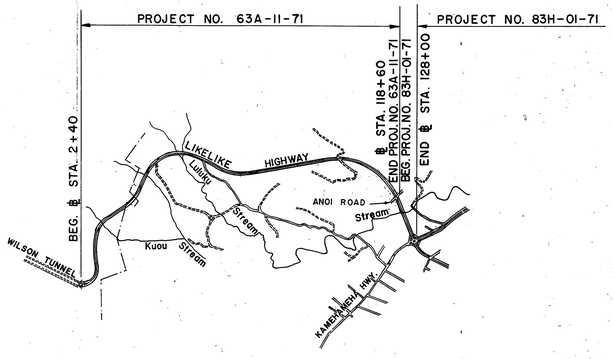

LAYOUT PLAN

LENGTH OF PROJECT NO. 63A-11-71 . . . . 2.2017 MILES
LENGTH OF PROJECT NO. 83H-01-71 . . . . .1780 MILES
TOTAL . . . . : 2.3797 MILES

SCALE IN MILES
0 .05 1

VTN-PACIFIC — DESIGNED BY
JAMES SUGIHARA — P. S. & E. BY
548-7532 — PHONE
12-28-71 — DATE

CHARLES YOON
REGISTERED PROFESSIONAL ENGINEER
No. 1037
HAWAII, U.S.A.

THIS WORK WAS PREPARED BY ME OR UNDER MY SUPERVISION
Charles Yoon

DEPARTMENT OF TRANSPORTATION
STATE OF HAWAII
APPROVED:
Murray Lee — FOR DIR. OF TRANSPORTATION — 3/16/72 DATE