FED. ROAD DIST. NO.	STATE	PROJ. NO.	FISCAL YEAR	SHEET NO.	TOTAL SHEETS
HAWAII	HAW.	83D-01-72	1972	1	26

INDEX TO DRAWINGS

SHEET NO.	DESCRIPTION
1	TITLE SHEET
2	TYPICAL DETAILS
3-4	PLAN AND PROFILE
5-14	DRAINAGE DETAILS
15-26	STANDARD DETAILS

STATE OF HAWAII

DEPARTMENT OF TRANSPORTATION

HIGHWAYS DIVISION

HONOLULU, HAWAII

"AS BUILT" PLANS FOR

ROADWAY IMPROVEMENTS ON KAMEHAMEHA HIGHWAY AT KAHANA BAY

PROJECT NO. 83D-01-72

DISTRICT OF KOOLAULOA

ISLAND OF OAHU

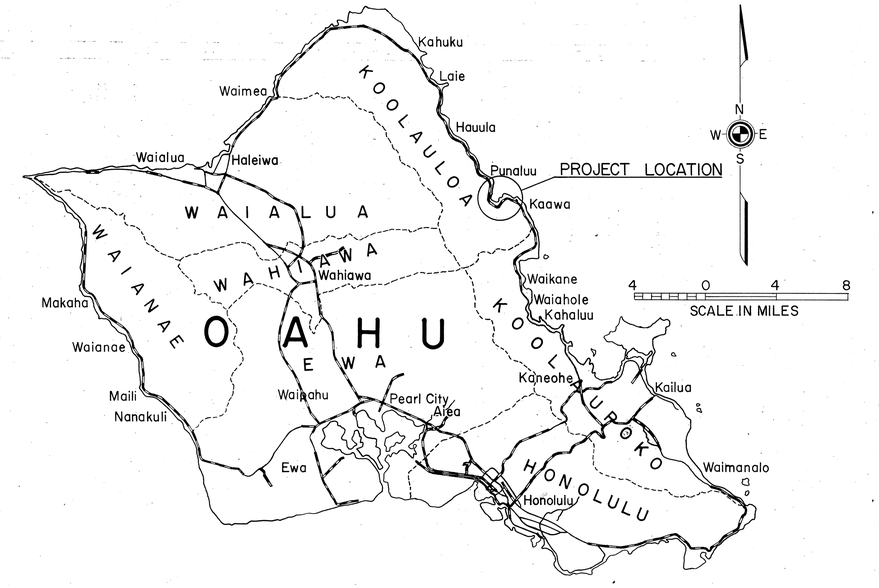

Federal Aid Projects Previously Constructed or Under Construction

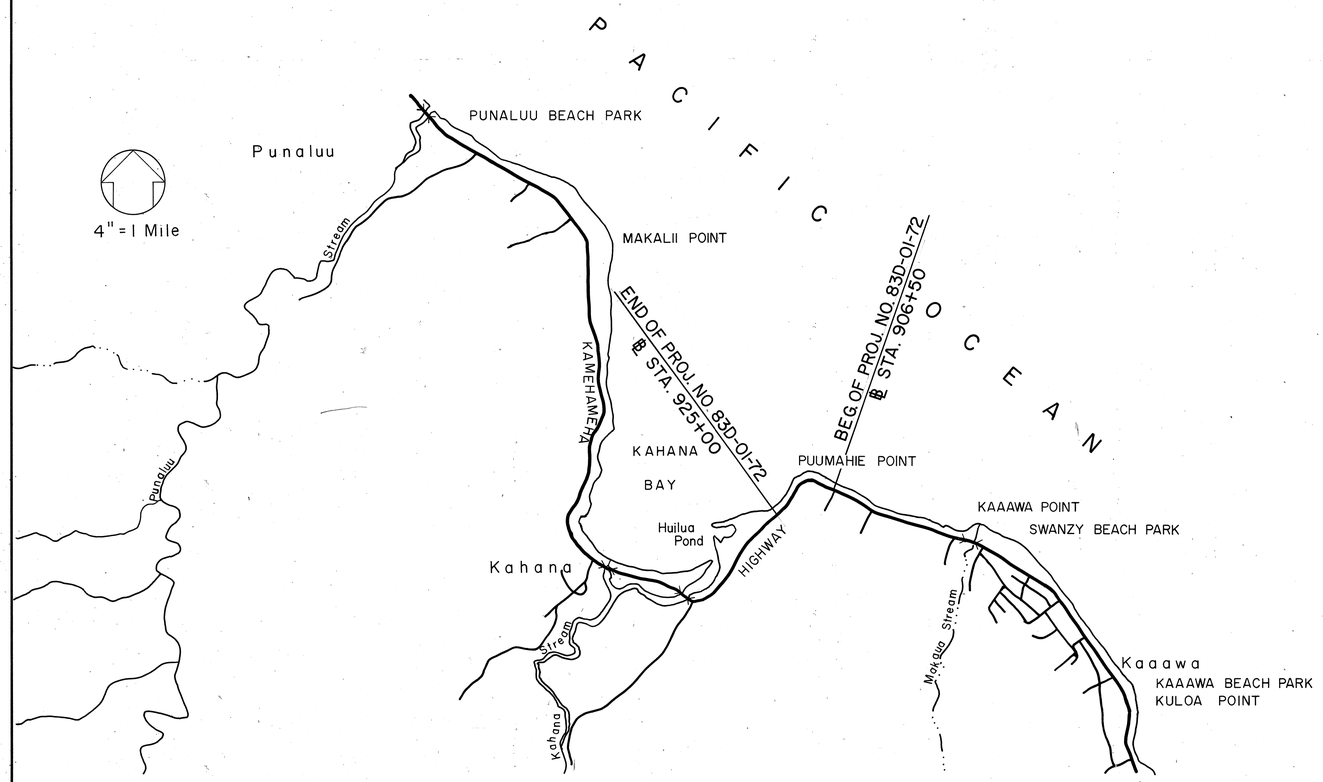

LAYOUT OF PROJECT

GROSS AND NET LENGTH OF PROJECT 0.350 MILES

NOTE:

ALL CHANGES MADE DURING CONSTRUCTION HAVE BEEN NOTED IN RED ON THESE TRACINGS AND CHECKED BY:

H. Hasuiko
PROJECT ENGINEER

3/15/74
DATE

ALL THE QUANTITIES SHOWN ARE ORIGINAL THEORETICAL QUANTITIES. FOR ACTUAL QUANTITIES REFER TO PROJECT LEDGER AND/OR COMPUTATION BOOK.

DEPARTMENT OF TRANSPORTATION
STATE OF HAWAII

APPROVED:

Munny Lee
FOR DIR. OF TRANSPORTATION

11/15/72
DATE

R. Mikami